

CITY PROJECT NO. 24-010

CITY OF TURLOCK, FIRE STATION NO. 31

SCBA COMPRESSOR ROOM

540 E MARSHALL ST.
TURLOCK, CA 95380



WMB
ARCHITECTS

5757 Pacific Avenue
Suite 226
Stockton, CA 95207

2000 L Street
Suite 125
Sacramento, CA 95811

T 209.944.9110
F 209.944.5711
www.wmbarchitects.com

ABBREVIATIONS

@	AT	JB.	JAMB
A.F.F.	ABOVE FINISH FLOOR	JT.	JOINT
ABV.	ABOVE		
ADJ.	ADJUSTABLE	LAV.	LAVATORY
ALT.	ALTERNATE	LWT.	LIGHT WEIGHT
ALUM.	ALUMINUM		
APPL.	APPLICABLE	MAX.	MAXIMUM
APPROX.	APPROXIMATE	MECH.	MECHANICAL
		MIN.	MINIMUM / MINUTE
		MTD.	MOUNTED
		MTL.	METAL
B.O.	BOTTOM OF		
BD.	BOARD		
BLDG.	BUILDING		
BLK.	BLOCK	(N)	NEW
BLKG.	BLOCKING	N.I.C.	NOT IN CONTRACT
BLW.	BELOW	N.T.S.	NOT TO SCALE
BTWN.	BETWEEN	N/A	NOT APPLICABLE
		NO. / #	NUMBER
C.I.	CAST IRON		
C.I.P.	CAST-IN-PLACE	O.C.	ON CENTER
C.J.	CONTROL JOINT	OPP.	OPPOSITE HAND
C.L.	CENTER LINE	ov	OVER
CBC	CALIFORNIA BUILDING CODE	OZ.	OUNCE
CLG.	CEILING	P.F.	PREFINISHED
CLR.	CLEAR	P.O.C.	POINT OF CONNECTION
CMU	CONCRETE MASONRY UNIT	P.T.	PRESSURE TREATED
		PL.	PLATE
COL.	COLUMN	PLAM.	PLASTIC LAMINATE
COMP.	COMPACTED	PROP.	PROPERTY
CONC.	CONCRETE	PSI	POUNDS PER SQUARE INCH
CONT.	CONTINUOUS	PW	PLYWOOD
D.F.	DOUGLAS FIR / DRINKING FOUNTAIN		
D.S.	DOWNSPOUT	R.W.L.	RAIN WATER LEADER
DBL.	DOUBLE	RDWD.	REDWOOD
DIA.	DIAMETER	REF.	REFER TO
DN.	DOWN	REINF.	REINFORCED
DWG.	DRAWING	REQ'D.	REQUIRED ROOM
		S.C.	SOLID CORE
E.I.F.S.	EXTERIOR INSULATION & FINISH SYSTEM	S.D.	STORM DRAIN
E.J.	EXPANSION JOINT	S.F.	SQUARE FOOTAGE / STOREFRONT
E.W.	EACH WAY		
EA.	EACH	S.M.	SHEET METAL
ELEV.	ELEVATION	S.M.S.	SHEET METAL SCREW
EQ.	EQUAL	S.P.	SINGLE PLY
EXIST. / (E)	EXISTING	S.S.	SANITARY SEWER LINE / STANDING SEAM / STAINLESS STEEL
EXP.	EXPANSION		
EXT.	EXTERIOR	SCH.	SCHEDULE
		SDST	SELF-DRILLING SELF-TAPPING
F.D.	FLOOR DRAIN		
F.E.	FIRE EXTINGUISHER	SHT.	SHEET
F.G.	FIBERGLASS / FINISH GRADE	SIM.	SIMILAR
		SPEC.	SPECIFICATION
F.H.	FIRE HYDRANT	SQ.	SQUARE
F.O.F.	FACE OF FINISH	STD.	STANDARD
F.O.S.	FACE OF STUD	STL.	STEEL
F.R.P.	FIBER REINFORCED POLYMER	SUSP.	SUSPENDED
F.S.	FIRE SPRINKLERS	T & B	TOP & BOTTOM
F.S.D.	FIRE SEPARATION DISTANCE	T & G	TONGUE & GROOVE
		T.J.I.	TRUS JOIST I-JOIST
FIN.	FINISH	T.O.	TOP OF
FLR.	FLOOR	T.S.	TUBE STEEL
FT.	FOOT / FEET	TEMP	TEMPORARY
FTG.	FOOTING	TYP.	TYPICAL
G.B.	GRADE BREAK	U.O.N.	UNLESS OTHERWISE NOTED
G.I.	GALVANIZED IRON		
G.L.B.	GLUE LAMINATED BEAM		
GA.	GAUGE		
GALV.	GALVANIZED	V.B.	VAPOR BARRIER
GD.	GRADE	V.I.F.	VERIFY IN FIELD
GYP. BD.	GYP. BOARD	V.T.R.	VENT THROUGH ROOF
		VERT.	VERTICAL
H.M.	HOLLOW METAL	W.C.	WATER CLOSET
HD.	HEAD	W.H.	WATER HEATER
HDR.	HEADER	W.I.	WROUGHT IRON
HDWR.	HARDWARE	W.W.F.	WOVEN WIRE FABRIC
HORIZ.	HORIZONTAL	w/	WITH
HR.	HOUR	w/o	WITHOUT
HT.	HEIGHT	WD.	WOOD
I.D.	IDENTIFICATION		
I.S.A.	INTERNATIONAL SYMBOL OF ACCESSIBILITY		
INSUL.	INSULATION		
INT.	INTERIOR		

SHEET INDEX

T1.1	TITLE SHEET
T1.2	SITE PLAN
T2.1	OCCUPANCY PLAN + SYMBOLS + ABBREVIATIONS
T3.2	BUILDING ACCESSIBILITY DETAILS
D2.1	DEMOLITION PLANS
A2.1	REMODEL FLOOR PLANS
A2.3	ENLARGED FLOOR PLAN + INTERIOR ELEVATIONS
A8.1	DOOR, FINISH SCHEDULE & DETAILS
SS.1	SPECIFICATIONS
SS.2	SPECIFICATIONS
S0.0	STRUCTURAL NOTES
S1.0	EQUIPMENT ANCHORAGE PLAN
S2.0	SHEAR WALL PLAN
M1.0	MECHANICAL- LEGEND, NOTES & SCHEDULES
M2.0	MECHANICAL- DEMOLITION AND NEW FLOOR PLANS
M2.1	MECHANICAL- BID ALT. 1 DEMOLITION AND FLOOR PLANS
M2.2	MECHANICAL- BID ALT. 2 DEMOLITION & FLOOR PLAN
M3.0	MECHANICAL DETAILS
E1.0	ELECTRICAL- FLOOR PLAN, NOTES AND SYMBOLS
E1.1	PARTIAL PLANS ELECTRICAL

PROJECT CONTACTS

OWNER INFORMATION	
OWNER	CITY OF TURLOCK 156 S. BROADWAY #150 TURLOCK, CA 95380 PHONE: 209.668.5366 EMAIL: omolina@turlock.ca.us CONTACT: OSCAR MOLINA

CONSULTANT INFORMATION	
ARCHITECT	WMB ARCHITECTS 5757 PACIFIC AVENUE, SUITE 226 STOCKTON, CA 95207 PHONE: 209.944.9110 FAX: 209.944.5711 EMAIL: dd@wmbarchitects.com CONTACT: DOUG DAVIS, PROJECT ARCHITECT

STRUCTURAL ENGINEER	PRECISION BUILDING SOLUTIONS DBA JC WAGNER & ASSOCIATES 2132 N. EL. DORADO STREET STOCKTON, CA 95204 PHONE: 209.227.7646 EMAIL: dougw@precisionbuildusa.com CONTACT: DOUGLASS E. WAGNER, P.E.
----------------------------	--

MECHANICAL ENGINEER	NEXUS ENGINEERING 1400-A LONE PALM AVENUE MODESTO, CA 95351 PHONE: 209.572.7399 FAX: 209.236.1579 EMAIL: alayman@nexusengineering.net CONTACT: ALLEN LAYMAN, P.E.
----------------------------	---

ELECTRICAL ENGINEER	PEZZONI ENGINEERING, INC. 1150 9th STREET STE. #1415 MODESTO, CA 95354 PHONE: 209.554.4602 EMAIL: kpezzoni@pezengr.com CONTACT: KEVIN PEZZONI, P.E.
----------------------------	--

PROJECT DATA ALTERATION

	YES	NO
ALTERATION TO EXISTING BLDG	X	
ADDITION TO EXISTING BLDG		X
CHANGE OF USE		X
EXISTING FIRE SPRINKLERS	X	

TYPE OF CONSTRUCTION	V-B
OCCUPANCY GROUP	B
	EXISTING
BUILDING HEIGHT	(E) 31' - 3" UNCHANGED
NUMBER OF STORIES	(E) 2 UNCHANGED
BUILDING AREA	10,127 S.F. UNCHANGED
AREA OF WORK	160 S.F.

ACCESS COMPLIANCE			
	COMPLIANT PRIOR TO ALTERATION	IMPROVED WITH ALTERATION	EXCEEDS HARSHIP THRESHOLD
PRIMARY ENTRANCE	X		
ACCESSIBLE ROUTE TO THE AREA	X		
TOILET FACILITIES SERVING THE AREA		X	X
DRINKING FOUNTAINS SERVING THE AREA	----- NOT PREVIOUSLY PROVIDED -----		
PUBLIC TELEPHONES SERVING THE AREA	----- NOT PREVIOUSLY PROVIDED -----		
SIGNS		X	
ACCESSIBLE PARKING		X	

REFER TO ACCESSIBILITY UPGRADE FORM FOR ADDITIONAL DETAIL

SPECIAL INSPECTIONS	1. REFER TO STRUCTURAL DRAWINGS FOR POST-INSTALLED ANCHORS - DETAILED INFORMATION
----------------------------	---


PROJECT INFORMATION

PROJECT DESCRIPTION
INTERIOR ALTERATION TO PORTION OF EXISTING FIRE STATION, ENLARGING EXISTING SCBA ROOM TO ACCOMMODATE NEW COMPRESSOR EQUIPMENT, ELECTRICAL AND HVAC MODIFICATIONS TO ACCOMMODATE NEW COMPRESSOR EQUIPMENT.

APPLICABLE CODES
ALL WORK SHALL BE IN CONFORMANCE WITH THE LATEST ADOPTED AND EFFECTIVE EDITION OF TITLE 24, CALIFORNIA CODE OF REGULATIONS (CCR), AS APPLICABLE:

PART 1 CALIFORNIA ADMINISTRATIVE CODE
PART 2 2022 CALIFORNIA BUILDING CODE
PART 3 2022 CALIFORNIA ELECTRICAL CODE
PART 4 2022 CALIFORNIA MECHANICAL CODE
PART 5 2022 CALIFORNIA PLUMBING CODE
PART 6 2022 CALIFORNIA ENERGY CODE
PART 9 2022 CALIFORNIA FIRE CODE
PART 11 2022 CALIFORNIA GREEN BUILDING STANDARDS CODE

VICINITY MAP

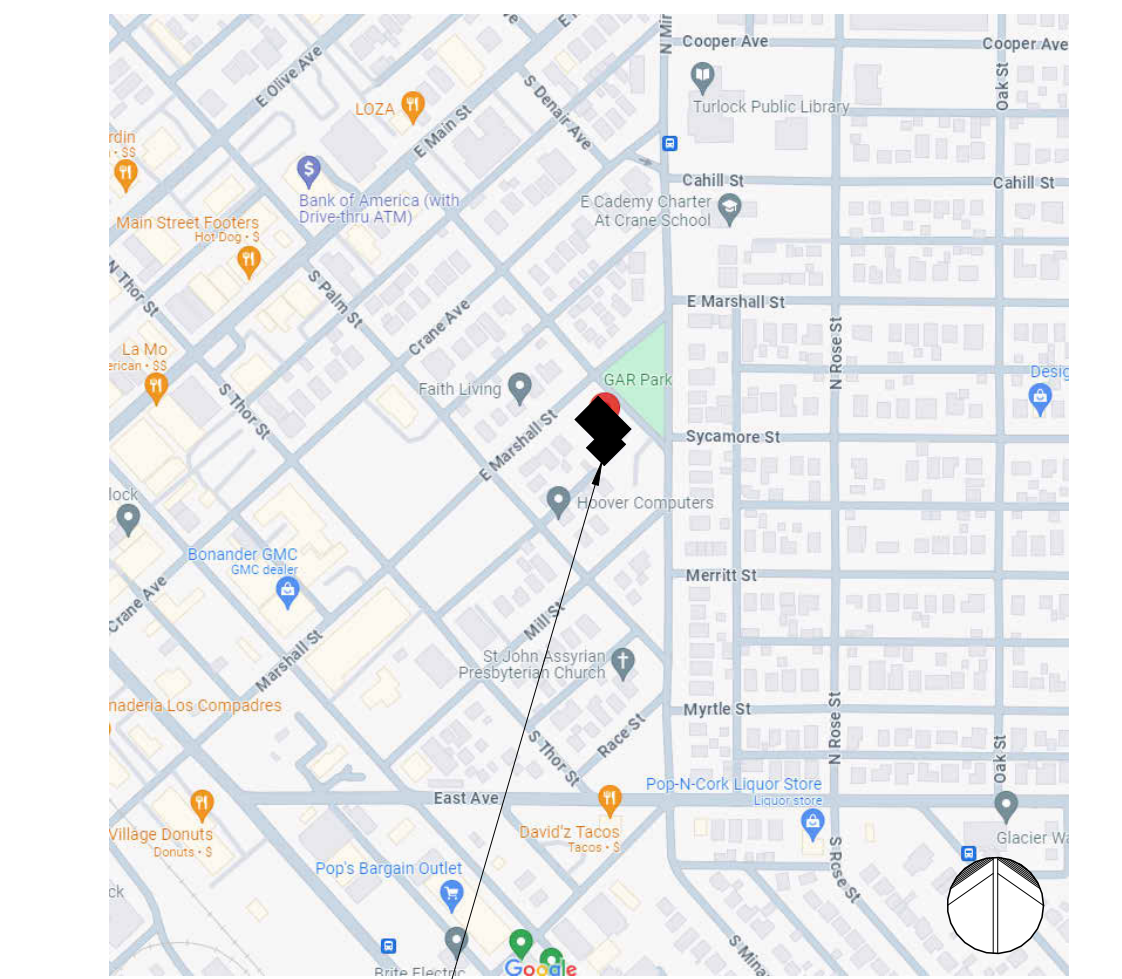

PROJECT LOCATION
ADDRESS: 540 E MARSHALL ST.
TURLOCK, CA 95380

SEPARATE PERMITS
IT IS THE GENERAL CONTRACTOR'S RESPONSIBILITY TO SUBMIT THE FOLLOWING ITEMS TO THE AUTHORITY HAVING JURISDICTION FOR APPROVAL PRIOR TO BEGINNING RELATED WORK:

1. ALTERATIONS TO EXISTING FIRE SUPPRESSION & FIRE ALARM SYSTEMS

BID ALTERNATES

ADDITIVE BID ALTERNATE # 1:
NEW EXTERIOR DOUBLE DOOR. WORK ASSOCIATED WITH BID ALTERNATE #1 INCLUDES:

- DEMOLISHING PORTION OF EXISTING WALL TO ACCOMMODATE NEW DOOR OPENING. REMOVAL OF INTERIOR GYPSUM WALLBOARD ADJACENT TO NEW OPENING TO INSTALL NEW HOLDDOWNS AND SHEATHING. REFER TO 3/02.1.
- PROVIDE AND INSTALL NEW DOUBLE DOOR 101.2, DOOR FRAME, AND DOOR HARDWARE PER DOOR SCHEDULE. INSTALL NEW GYPSUM WALLBOARD OVER NEW WALL SHEATHING. PATCH/REPAIR STUCCO AROUND DOOR FRAME. REFER TO 3/A2.1 AND BID ALT 1 DOOR SCHEDULE, SHEET A8.1
- INSTALL NEW 6X6 POSTS, HEADER, AND HOLDDOWNS AT NEW OPENING. INSTALL NEW SHEAR WALL SHEATHING ADJACENT NEW OPENING. REFER TO SHEET S2.0.
- RELOCATE EXISTING OUTDOOR CONDENSING UNIT TO ACCOMMODATE NEW DOOR OPENING. REFER TO MECHANICAL PLANS, SHEET M-2.0. RELOCATE EXISTING DISCONNECT AND FEEDER PER POWER NOTE #1, SHEET E1.1

ADDITIVE BID ALTERNATE #2:
PROVIDE AND INSTALL NEW MINI-SPLIT SYSTEM (INDOOR FAN COIL FC-1 AND OUTDOOR CONDENSING UNIT CU-1) PER MECHANICAL PLANS. REFER TO POWER NOTES 15 & 16 FOR ELECTRICAL POWER SUPPLY TO NEW MINI-SPLIT SYSTEM.

SYMBOLS

	BUILDING SECTION		NORTH ARROW
	WALL SECTION		ELEVATION MARKER
	INTERIOR ELEVATIONS		DETAIL DESIGNATION
	NUMBERED NOTE		FINISH DESIGNATION
	EXTERIOR ELEVATION		REVISION TO DRAWINGS
	GRID LINE		CENTERLINE DESIGNATION
	ROOM NAME & NUMBER		ROOM NAME & NUMBER

APPROVED BY


WILLIAM D. MORRIS, R.C.E., P.L.S.,
CITY ENGINEER
CITY OF TURLOCK

4/22/2025
DATE

CITY PROJECT NO.
24-010
FIRE STATION NO. 31,
SCBA COMPRESSOR ROOM

540 E MARSHALL ST.
TURLOCK, CA 95380

WMB Project No. 24-023

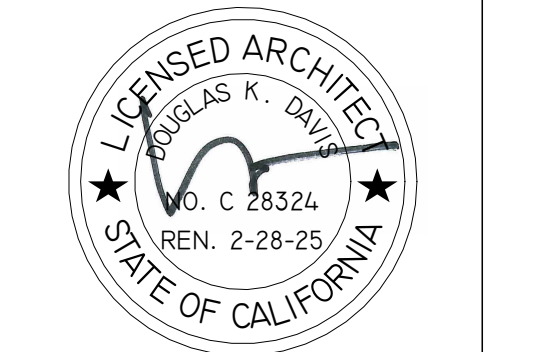

PUBLISH HISTORY:

DATE	PURPOSE
11.08.24	BLDG PERMIT APP
02.18.25	Plan Check #1

TITLE SHEET

T1.1



WMB ARCHITECTS


5757 Pacific Avenue
Suite 226
Stockton, CA 95207

2000 L Street
Suite 125
Sacramento, CA 95811

T 209.944.9110
F 209.944.5711
www.wmbarchitects.com

CITY PROJECT NO.
24-010
FIRE STATION NO. 31,
SCBA COMPRESSOR
ROOM
540 E MARSHALL ST.
TURLOCK, CA 95380

WMB Project No. 24-023

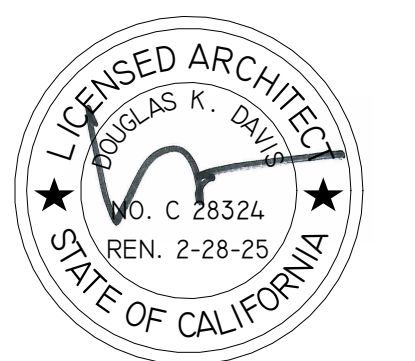

PUBLISH HISTORY:
DATE PURPOSE
11.08.24 BLDG PERMIT APP
02.18.25 Plan Check #1

SITE PLAN


T1.2

LEGEND


--- ACCESSIBLE PEDESTRIAN ROUTE:
MIN. WIDTH = 48"
MAX. SURFACE SLOPES:
CROSS SLOPE = 1:48" MAX.
SLOPE IN DIRECTION OF TRAVEL = 1:20 MAX.
RUNNING SLOPE ON RAMPS AND CURB RAMPS = 1:12 MAX.
NO VERTICAL OFFSETS IN EXCESS OF 1/4"

KEYNOTES


- 32.01 PROVIDE AND INSTALL 36" WIDE CONTINUOUS SURFACE MOUNTED DETECTABLE WARNING SURFACE - SEE DETAIL L/T3.2
- 32.02 PROVIDE AND INSTALL DETECTABLE WARNING SURFACE AT (E) CONC. RAMP PER DETAIL K/T3.2
- 32.03 PAINT 4" WIDE WHITE ACCESS AISLE STRIPING @ 36" O.C. w/ 12" HIGH IDENTIFICATION LETTERS: "NO PARKING"
- 32.05 PAINT 4" WIDE ACCESS AISLE w/ 4" BLUE BORDER w/ 4" WHITE STRIPING @ 36" O.C.
- 32.06 PAINT ACCESSIBLE PARKING STALL SURFACE IDENTIFICATION - WHITE I.S.A. ON A BLUE BACKGROUND - BACKGROUND AREA TO BE 36" SQUARE
- 32.07 (E) ACCESSIBLE PARKING STALL SIGN, ADD ADDITIONAL MINIMUM FINE SIGN PER DETAIL K/T3.2
- 32.08 (E) TOW-AWAY / ACCESSIBLE PARKING ENTRY SIGN - REPLACE CONTACT INFORMATION PER DETAIL N/T3.2
- 32.09 (E) PRECAST CON. WHEEL STOPS - TYP. @ FLUSH CURB
- 32.12 (E) CONCRETE CURB
- 32.13 (E) FLUSH CURB

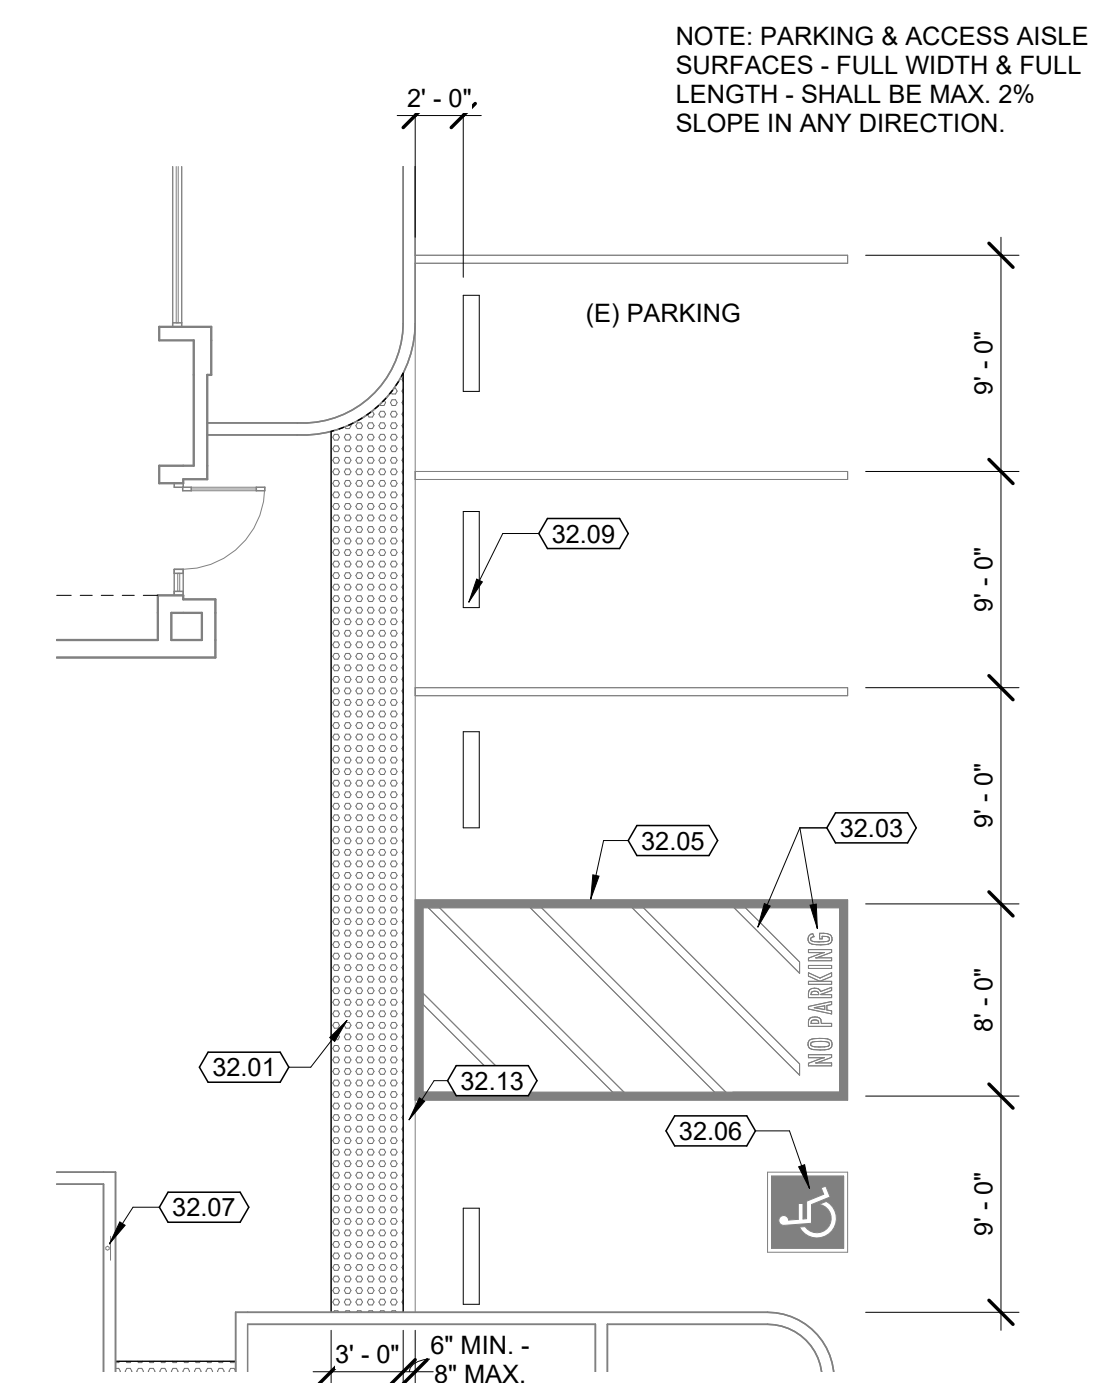



A ENLARGED SITE PLAN - PARKING
1/8" = 1'-0"

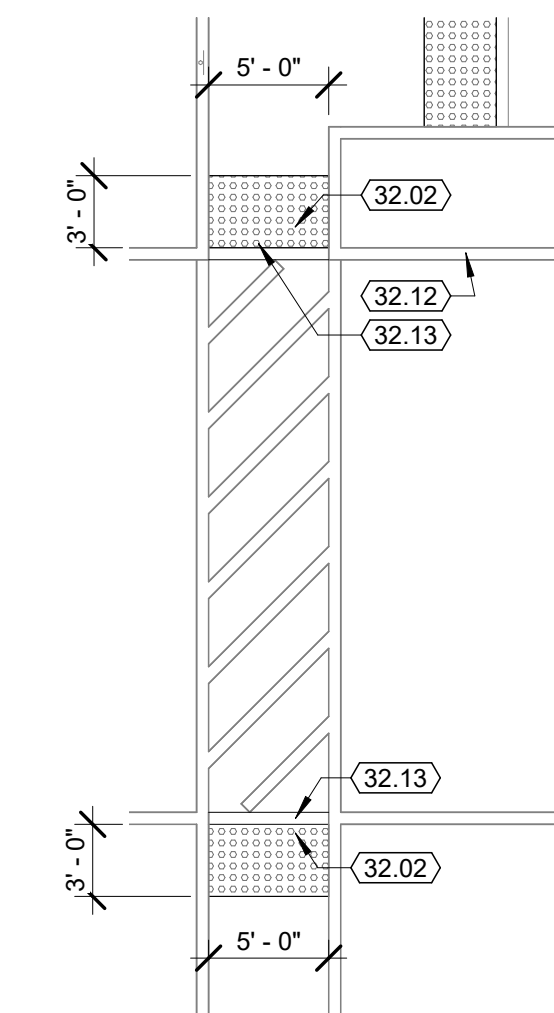

B ENLARGED SITE PLAN - WALKWAY
1/8" = 1'-0"

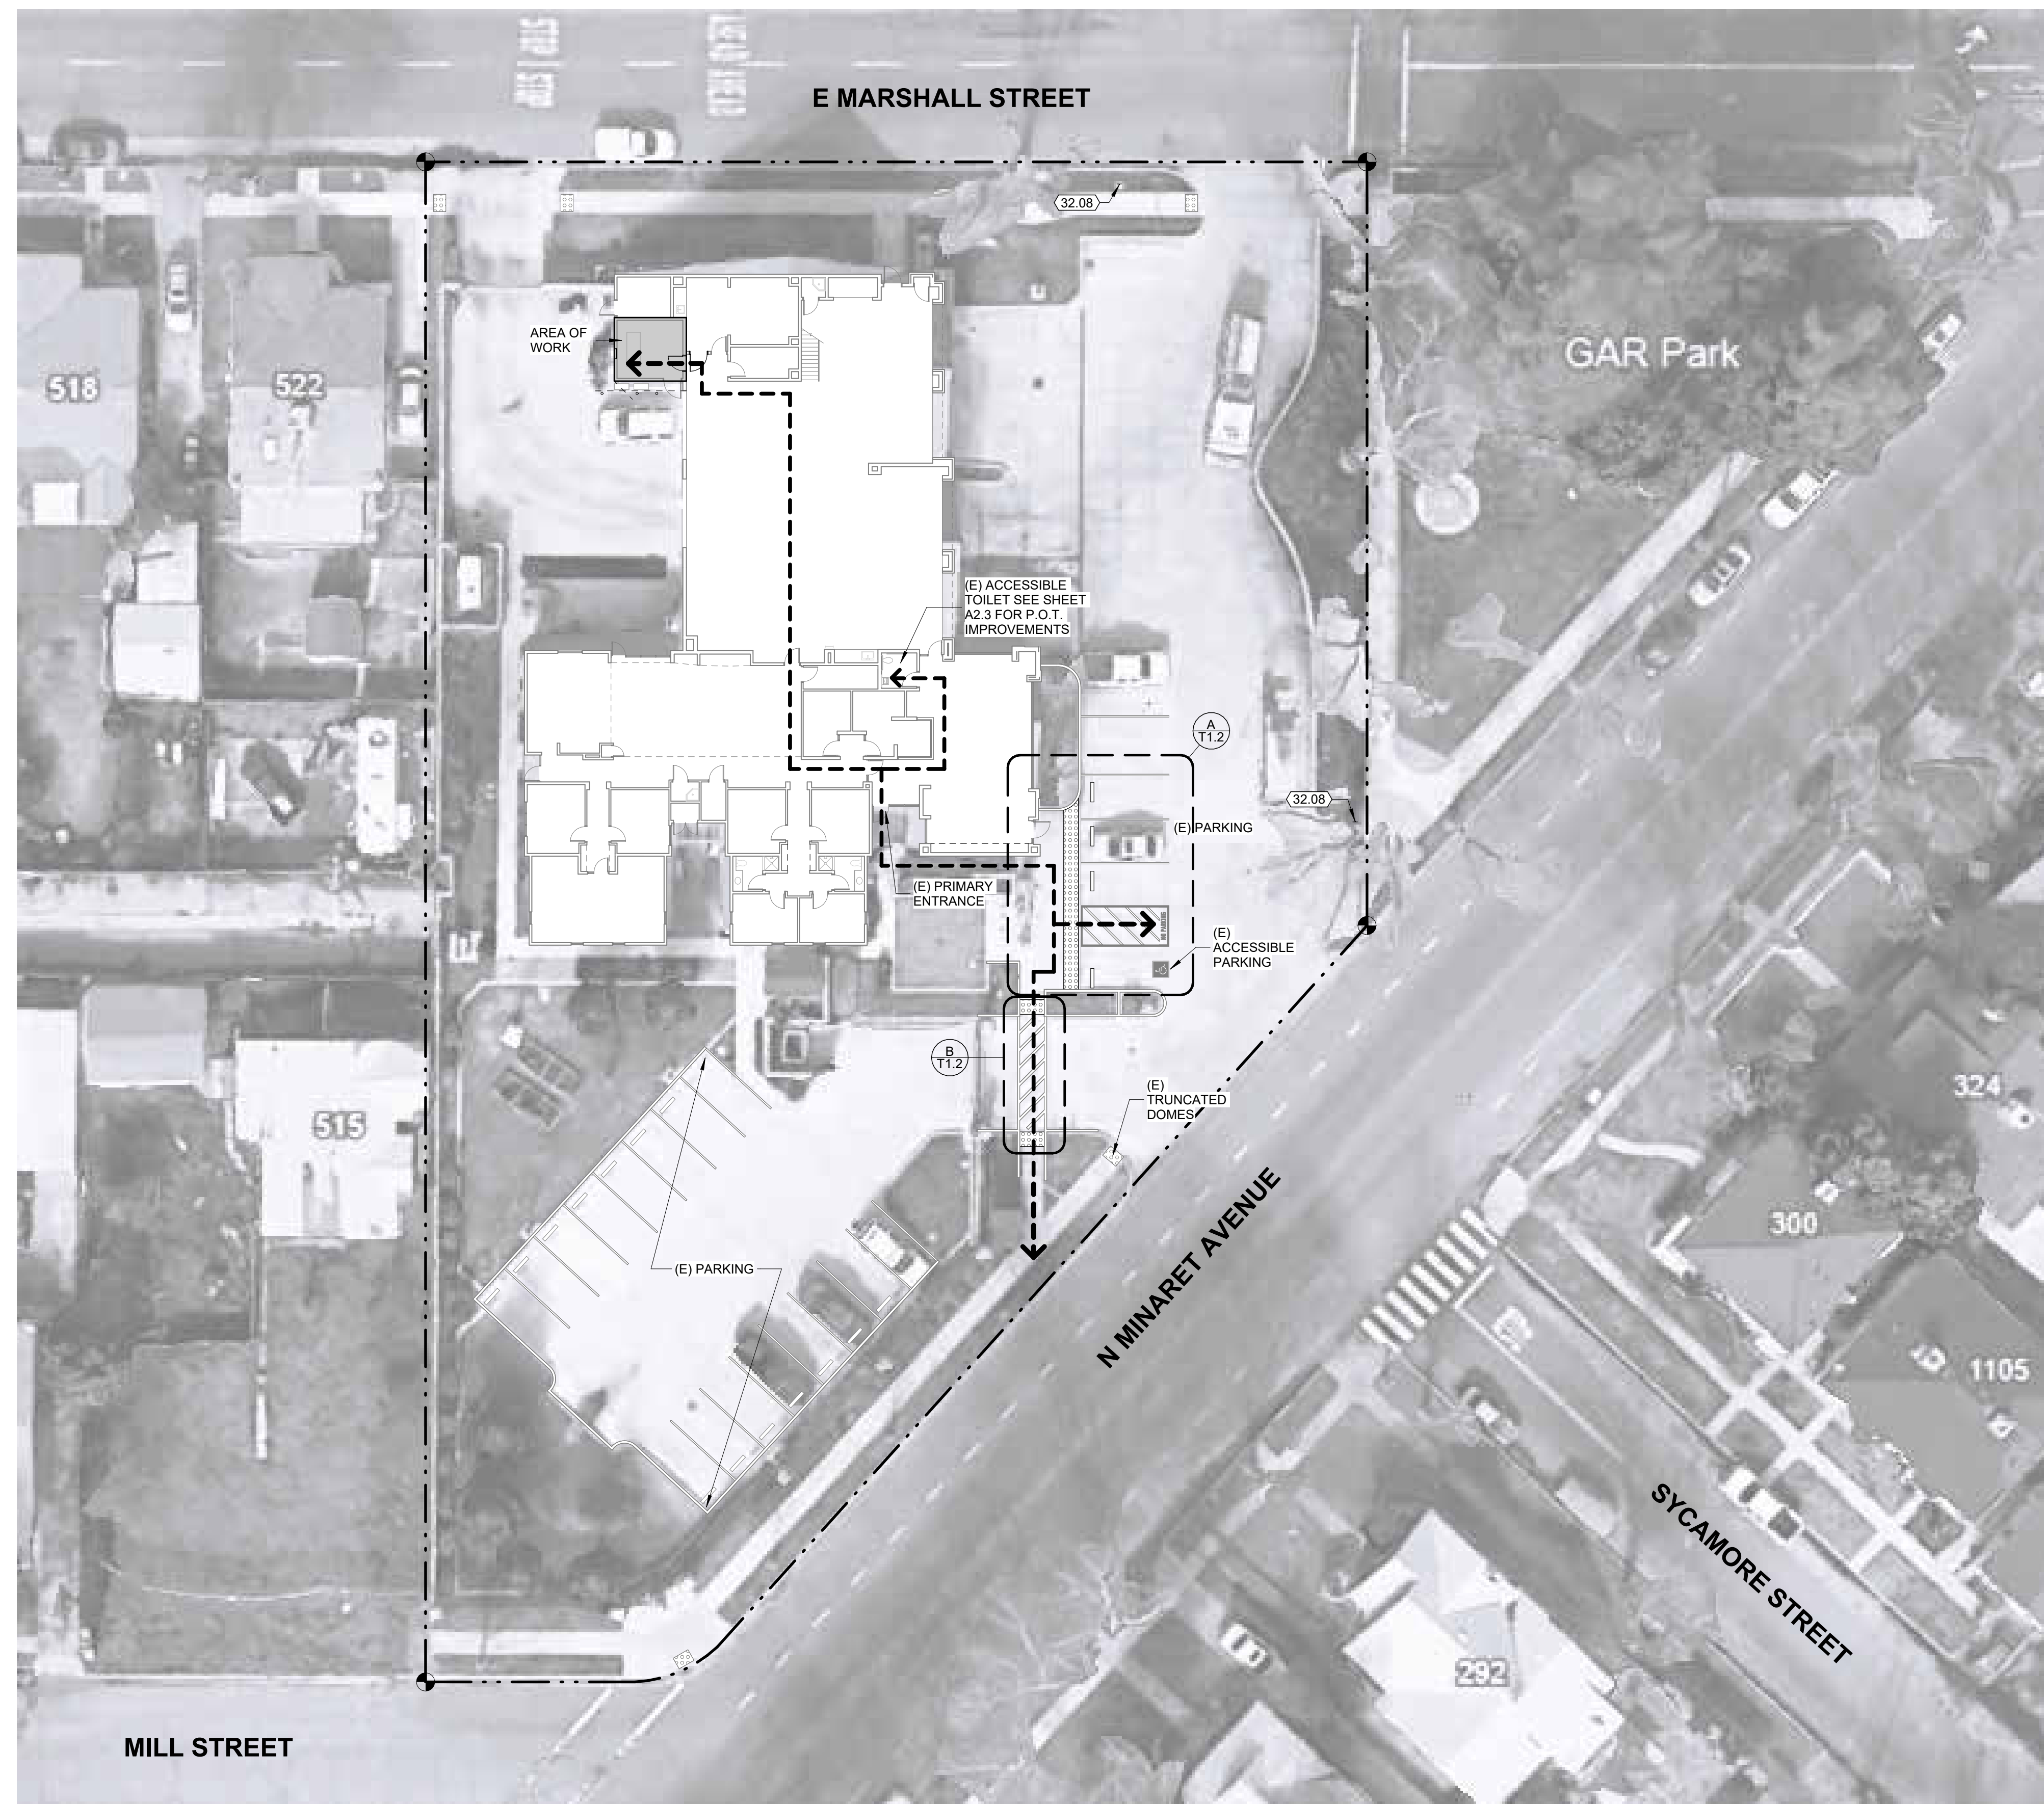

SITE PLAN
1" = 20'-0"

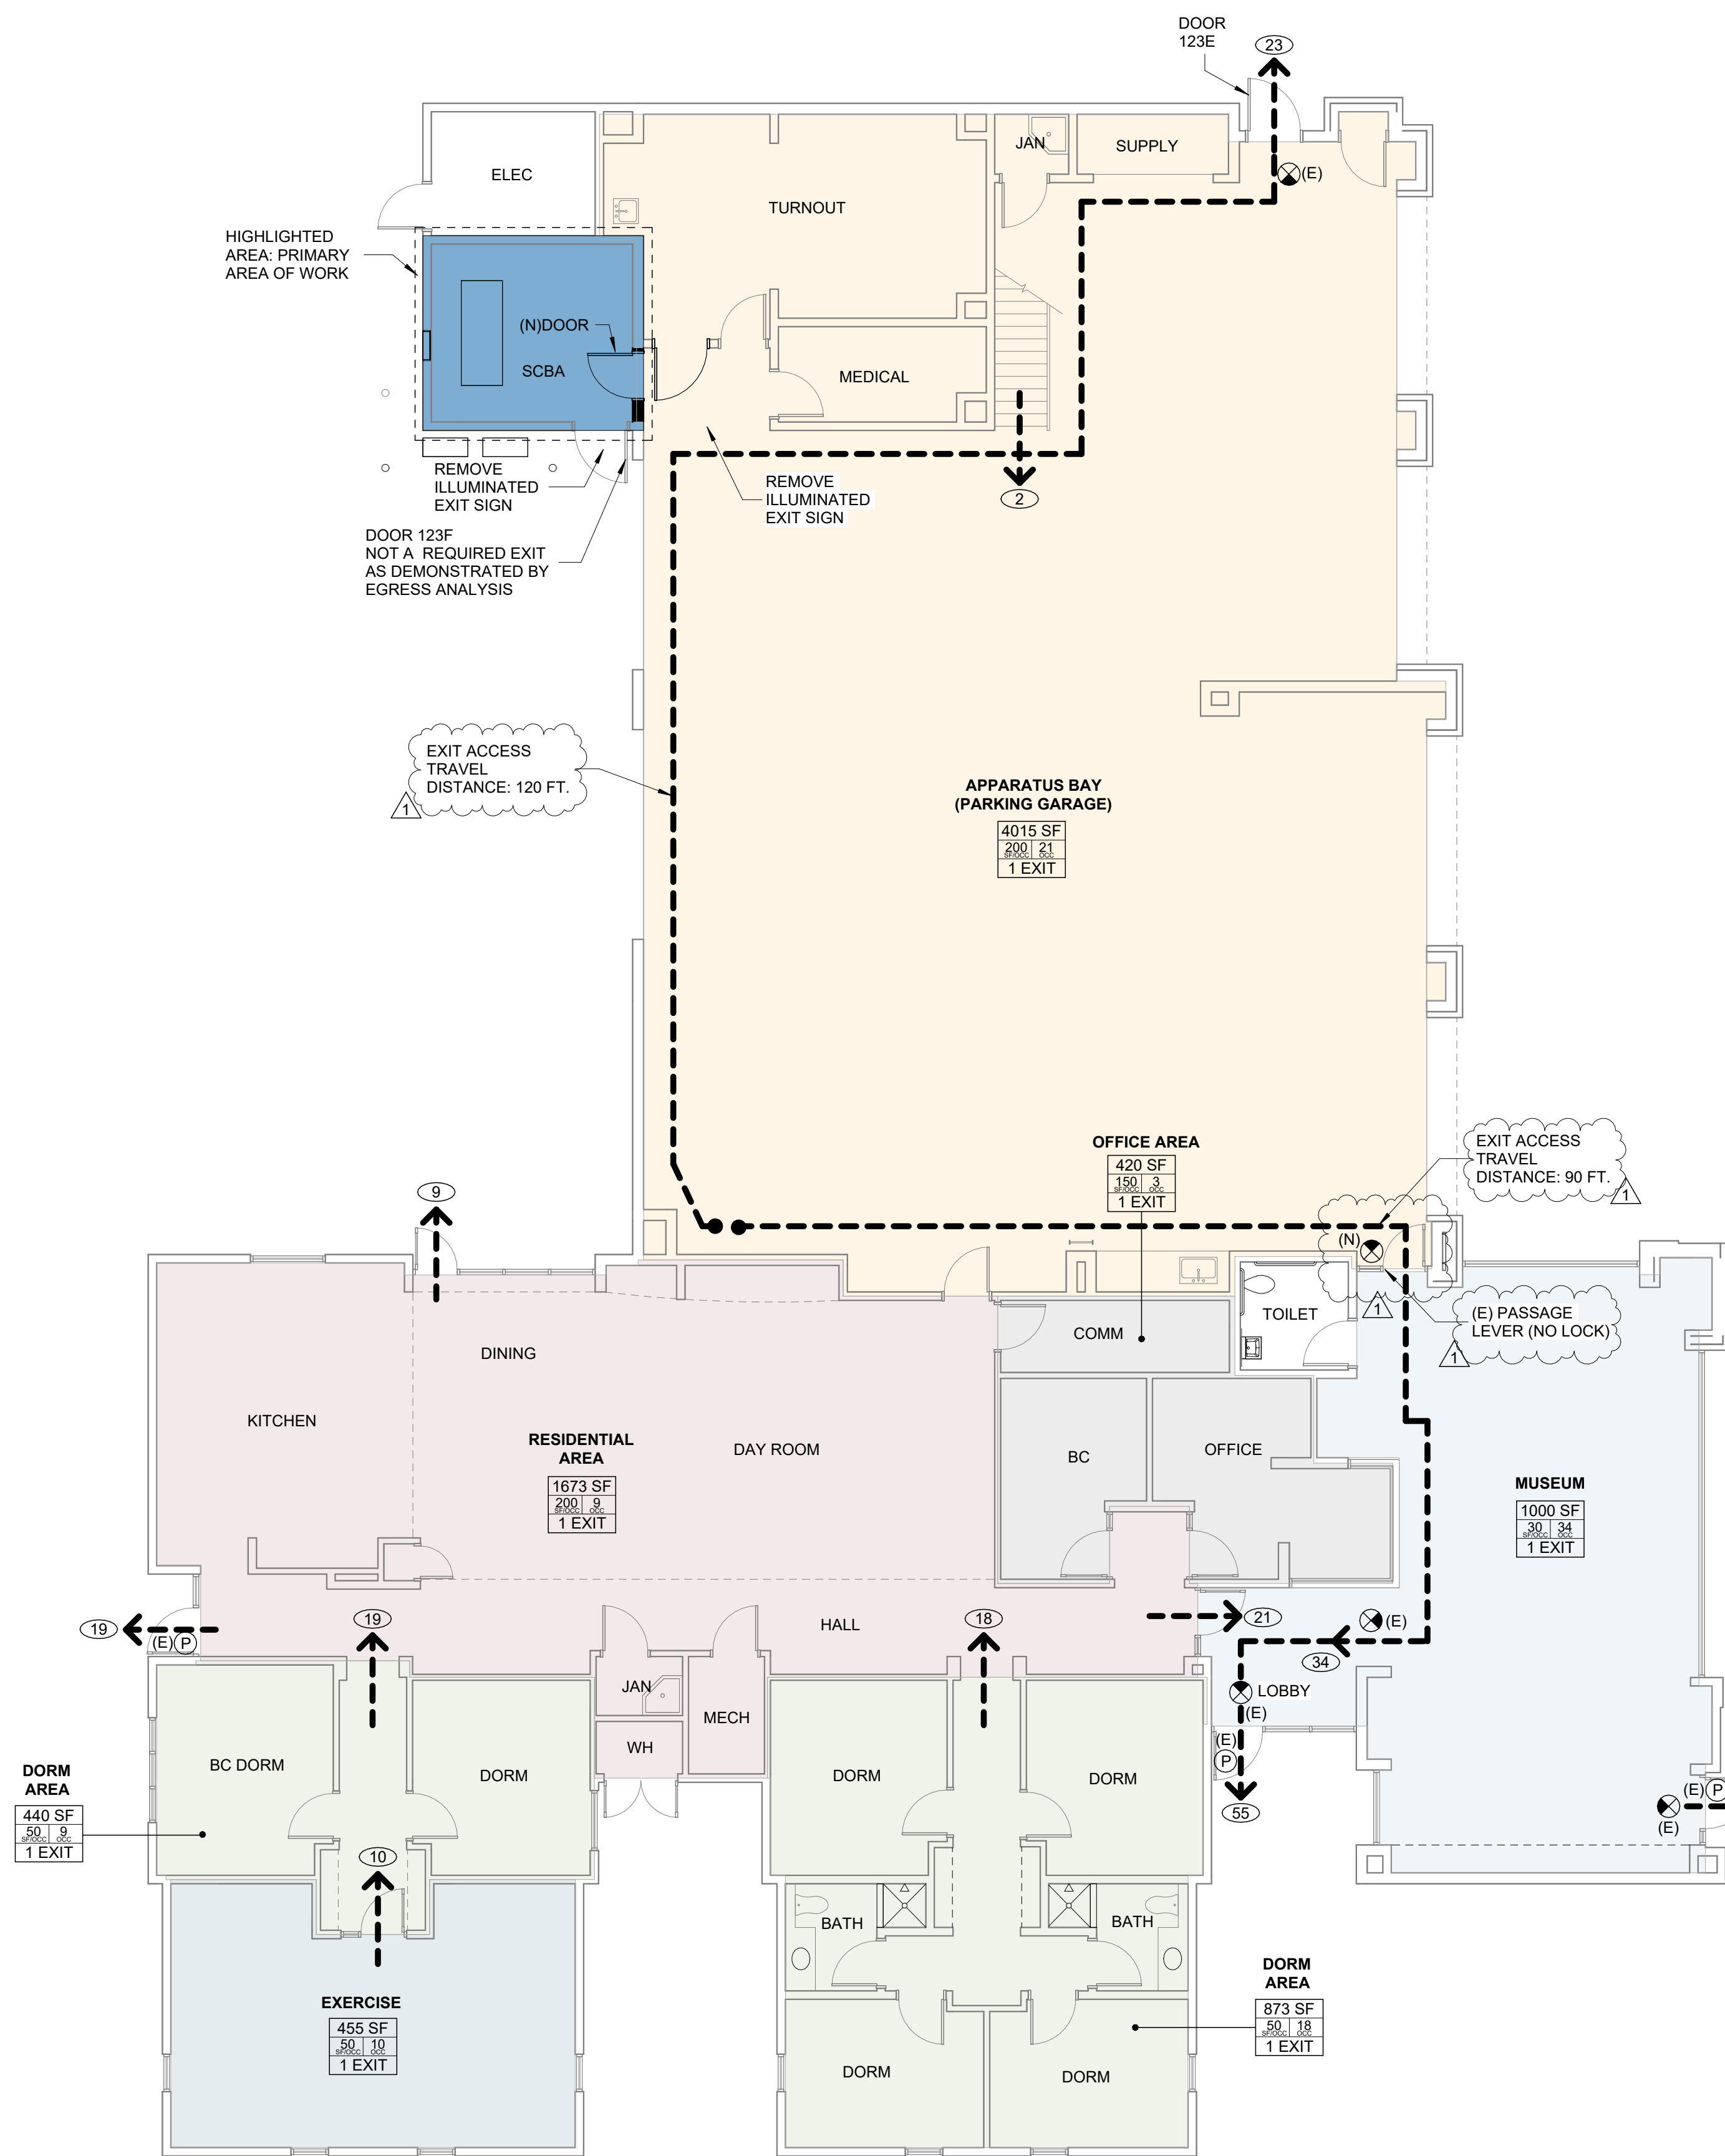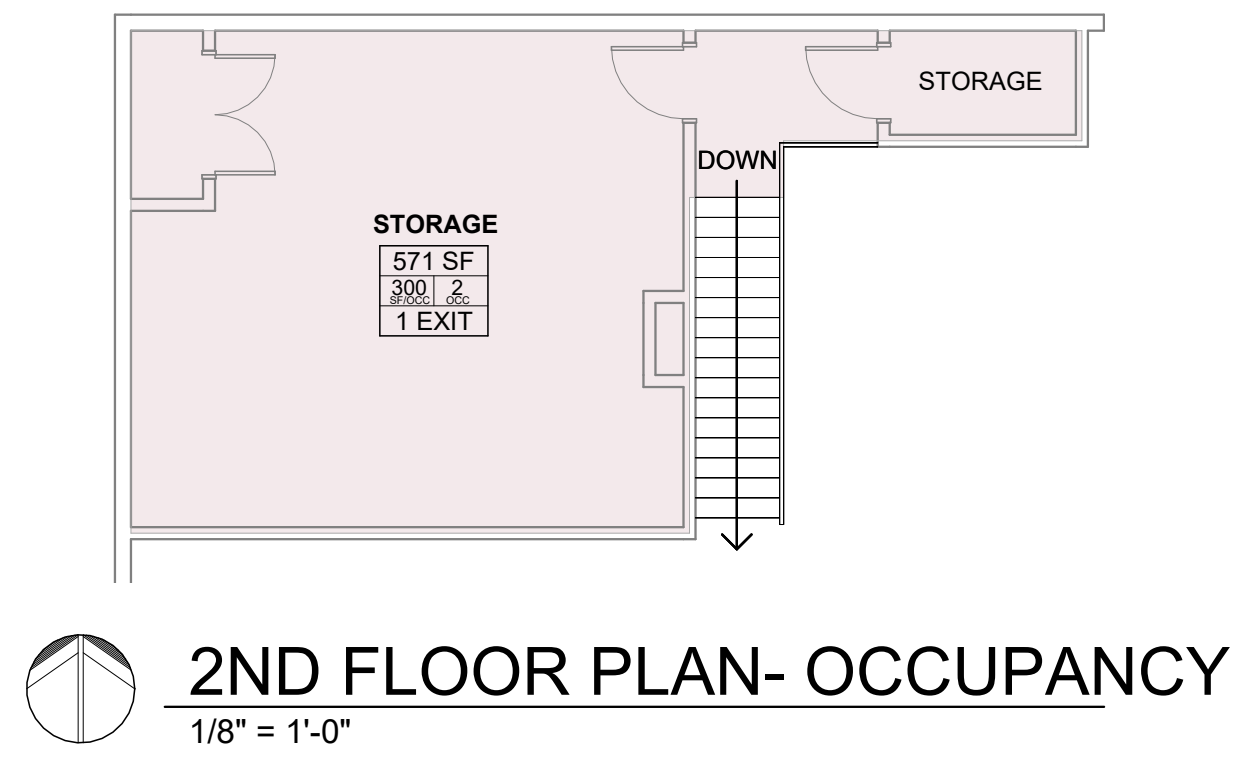

OCCUPANCY FLOOR PLAN
1/8" = 1'-0"

LEGEND

- ROOM NAME
- ROOM AREA
- OCCUPANT LOAD
- EXITS REQUIRED
- OCCUPANCY LOAD FACTOR
- (E) (P) EXISTING PANIC HARDWARE
- (E) (X) EXISTING ILLUMINATED EXIT SIGN
- (100) NUMBER OF OCCUPANTS

DOOR EGRESS CALCULATION

NOMINAL DOOR WIDTH	NET OPENING	FACTOR	MAX. NO. OF OCCUPANTS
36"	33"	0.20" / OCC.	165
42"	39"	0.20" / OCC.	195
48"	45"	0.20" / OCC.	225
72"	68"	0.20" / OCC.	340



WMB ARCHITECTS

5757 Pacific Avenue
Suite 226
Stockton, CA 95207


2000 L Street
Suite 125
Sacramento, CA 95811

T 209.944.9110
F 209.944.5711
www.wmbarchitects.com

CITY PROJECT NO.
24-010
FIRE STATION NO. 31,
SCBA COMPRESSOR
ROOM

540 E MARSHALL ST.
TURLOCK, CA 95380

WMB Project No. 24-023

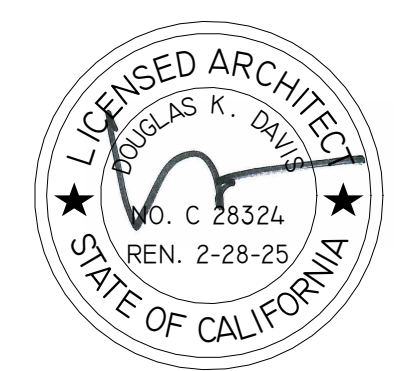

PUBLISH HISTORY:

DATE	PURPOSE
11.08.24	BLDG PERMIT APP
02.18.25	Plan Check #1

OCCUPANCY PLAN +
SYMBOLS +
ABBREVIATIONS

T2.1



WMB ARCHITECTS

5757 Pacific Avenue
Suite 226
Stockton, CA 95207

2000 L Street
Suite 125
Sacramento, CA 95811

T 209.944.9110
F 209.944.5711
www.wmbarchitects.com

CITY PROJECT NO.
24-010
FIRE STATION NO. 31,
SCBA COMPRESSOR
ROOM

540 E MARSHALL ST.
TURLOCK, CA 95380

WMB Project No. 24-023

PUBLISH HISTORY:

DATE	PURPOSE
11.08.24	BLDG PERMIT APP
02.18.25	Plan Check #1

BUILDING ACCESSIBILITY DETAILS


T3.2




ADD NEW TEXT TO (E) SIGN - TURLOCK POLICE DEPARTMENT (209) 668-5550

- NOTES:
- UNAUTHORIZED VEHICLE SIGN SHALL HAVE MIN 1" BLACK TEXT ON WHITE BACKGROUND
 - ALL BRACKETS AND HARDWARE SHALL BE GALVANIZED OR APPROVED EQUAL


(N) TOW AWAY SIGN
3/4" = 1'-0"

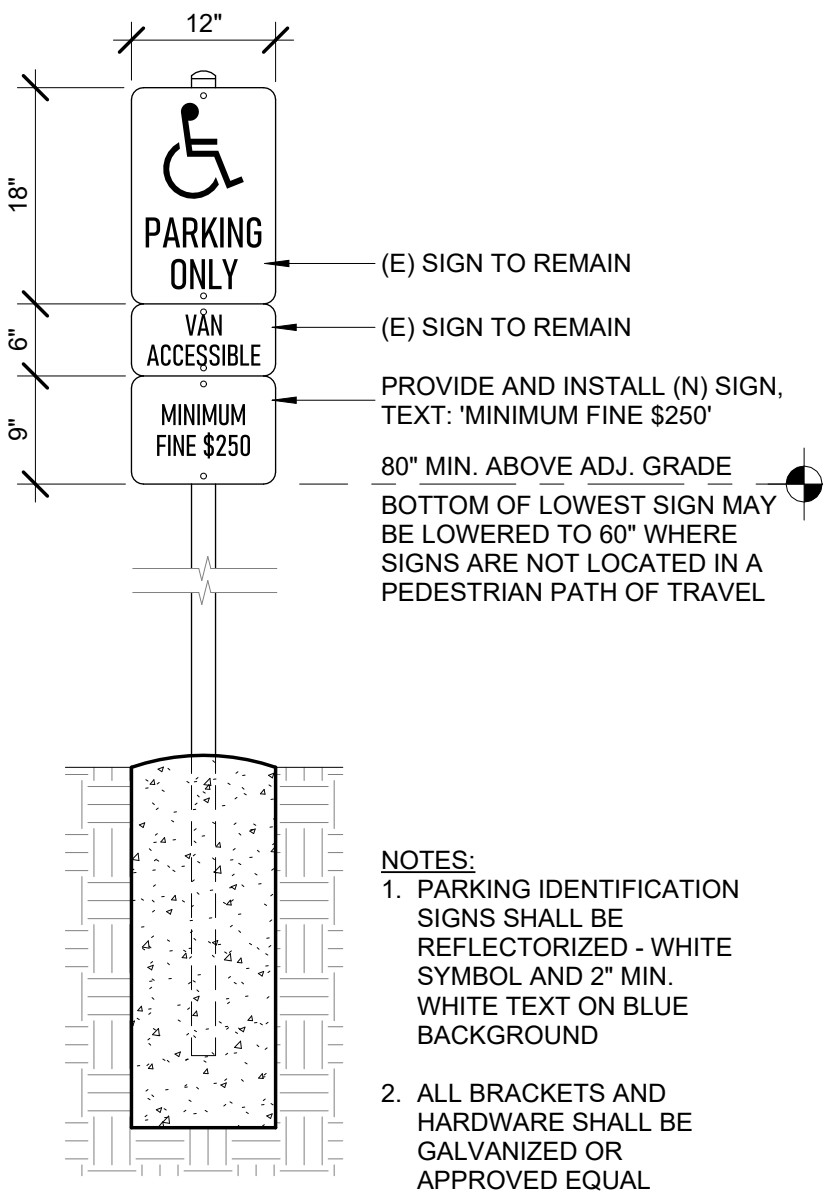




(K) ACCESS PARKING STALL SIGN
3/4" = 1'-0"

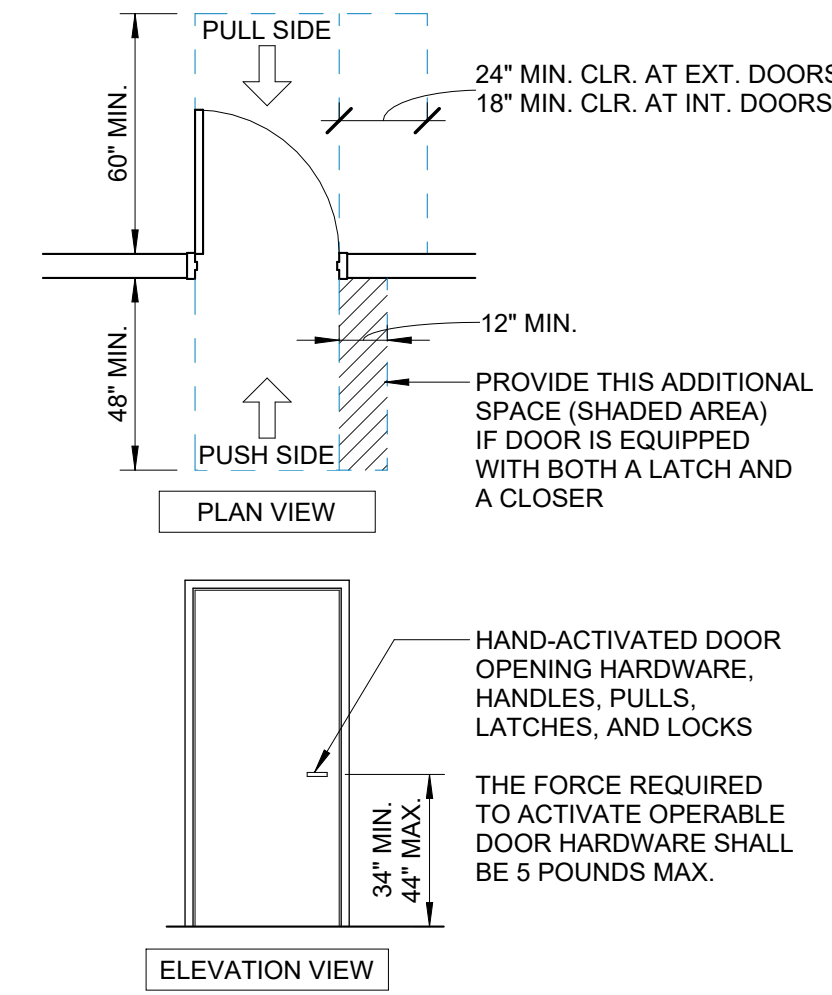


(D) ACCESSIBLE DOOR
1/4" = 1'-0"

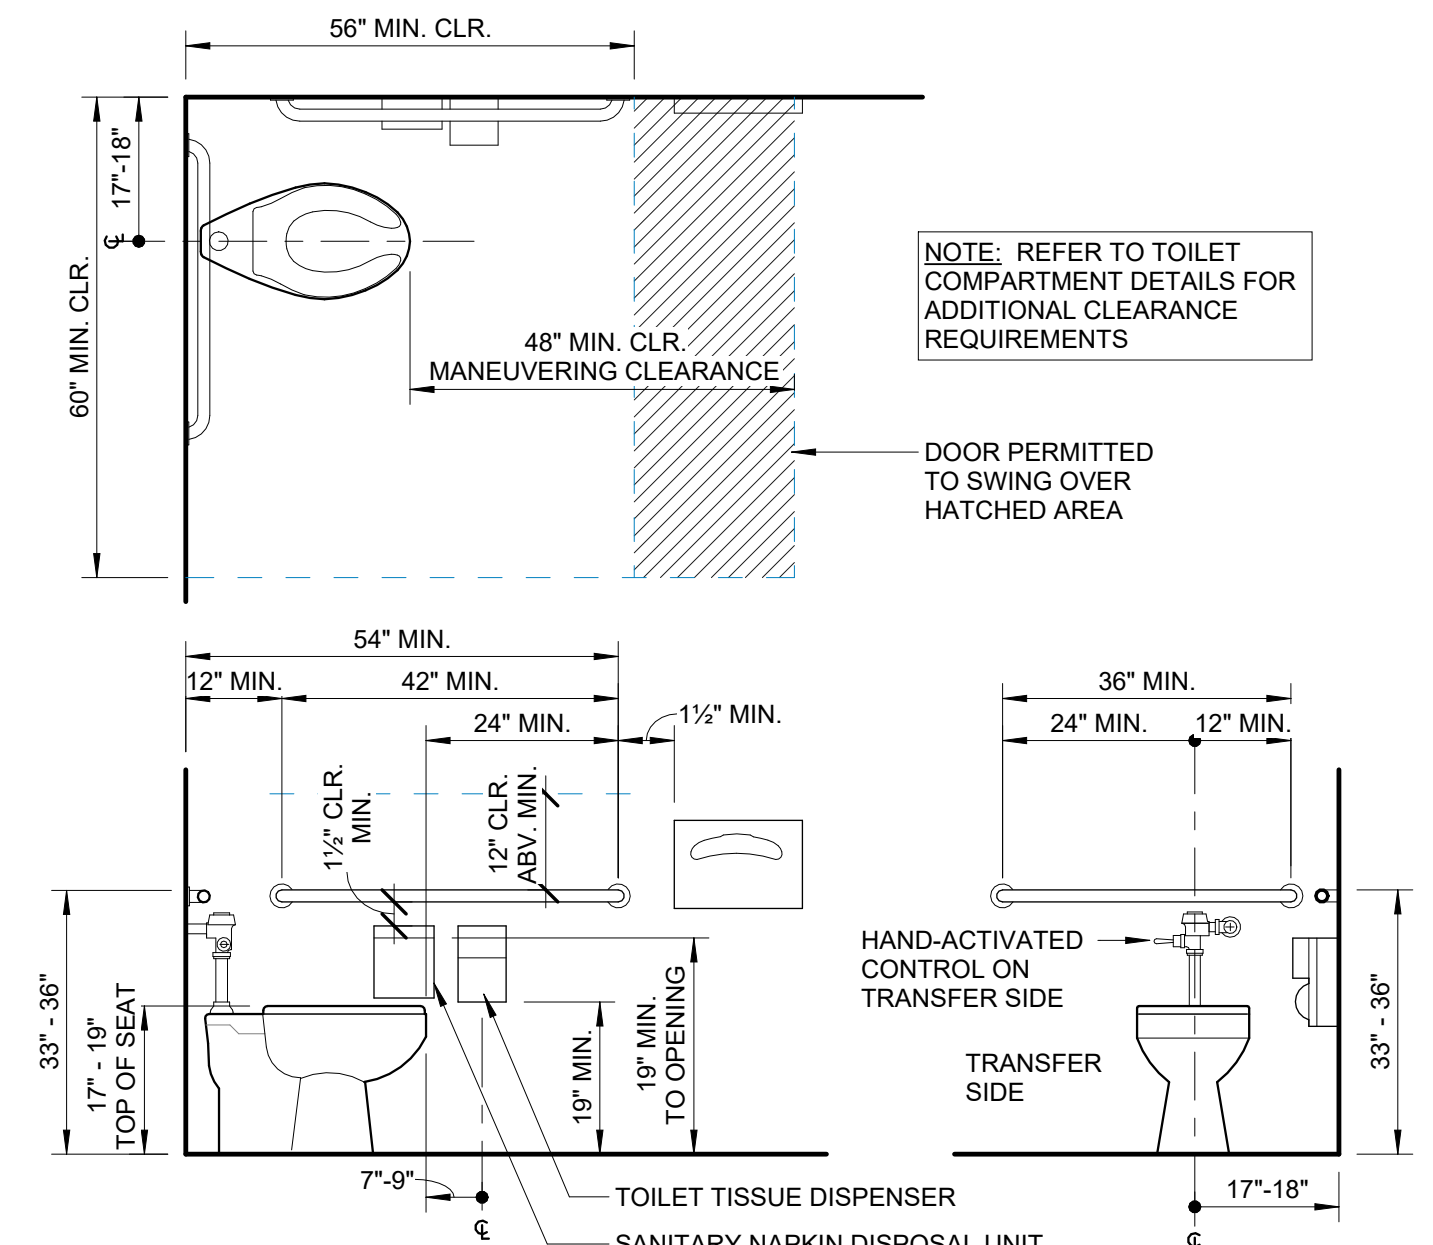

(A) ACCESSIBLE WATER CLOSET
1/2" = 1'-0"

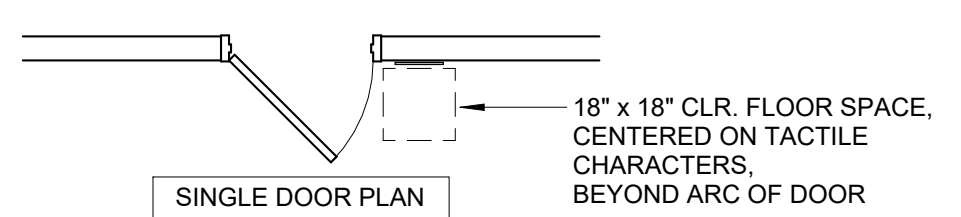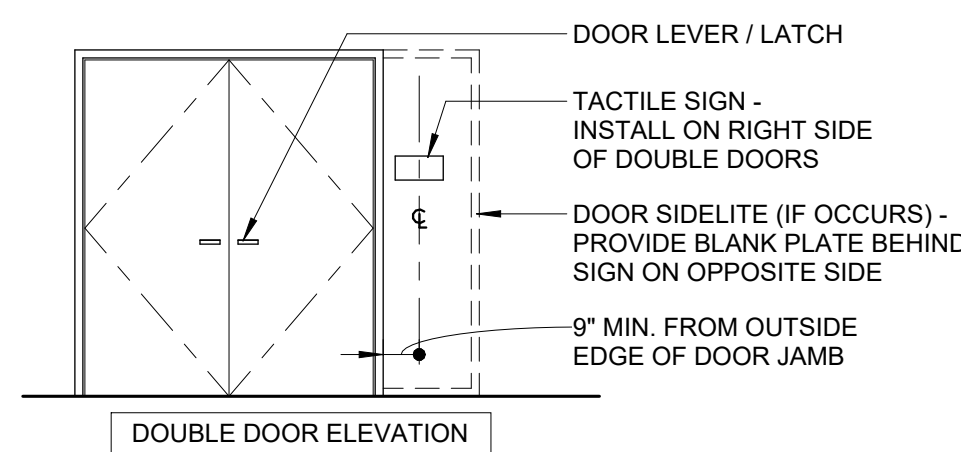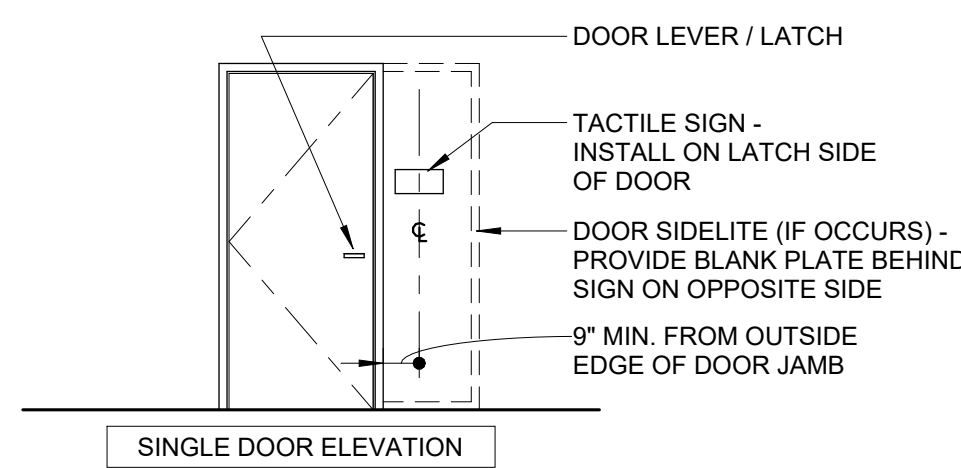


(P) TYP. TACTILE SIGN LOCATION AT DOOR
1/4" = 1'-0"

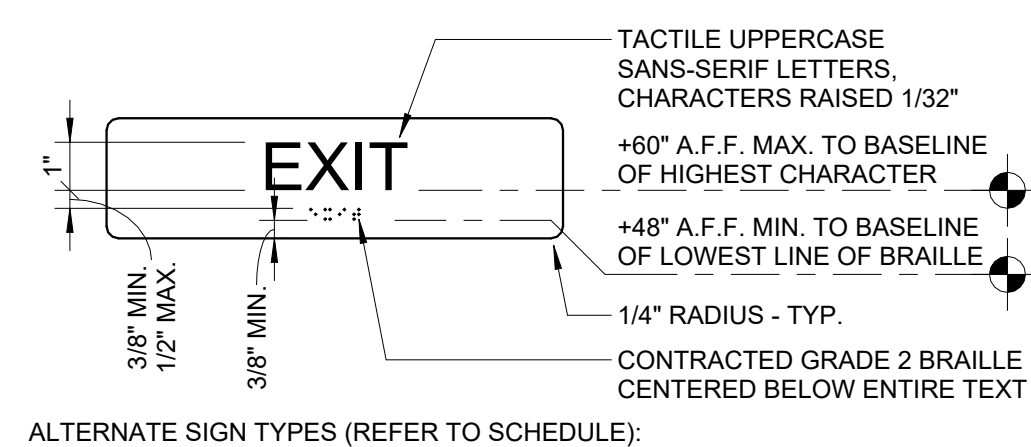


- NOTES:
1. CHARACTERS, SYMBOLS, AND THEIR BACKGROUND SHALL HAVE A NON-GLARE FINISH. CHARACTERS AND SYMBOLS SHALL CONTRAST WITH THEIR BACKGROUND (LIGHT ON A DARK BACKGROUND OR DARK ON A LIGHT BACKGROUND)
2. REFER TO TACTILE SIGN LOCATION DETAIL FOR SIGN LOCATION RELATIVE TO DOORS
3. BRAILLE SHALL COMPLY WITH THE REQUIREMENTS OF CHAPTER 11B OF THE C.B.C., LATEST EDITION
4. SEE SPECIFICATIONS FOR ADDITIONAL INFORMATION


(Q) TACTILE EXIT SIGN
3" = 1'-0"

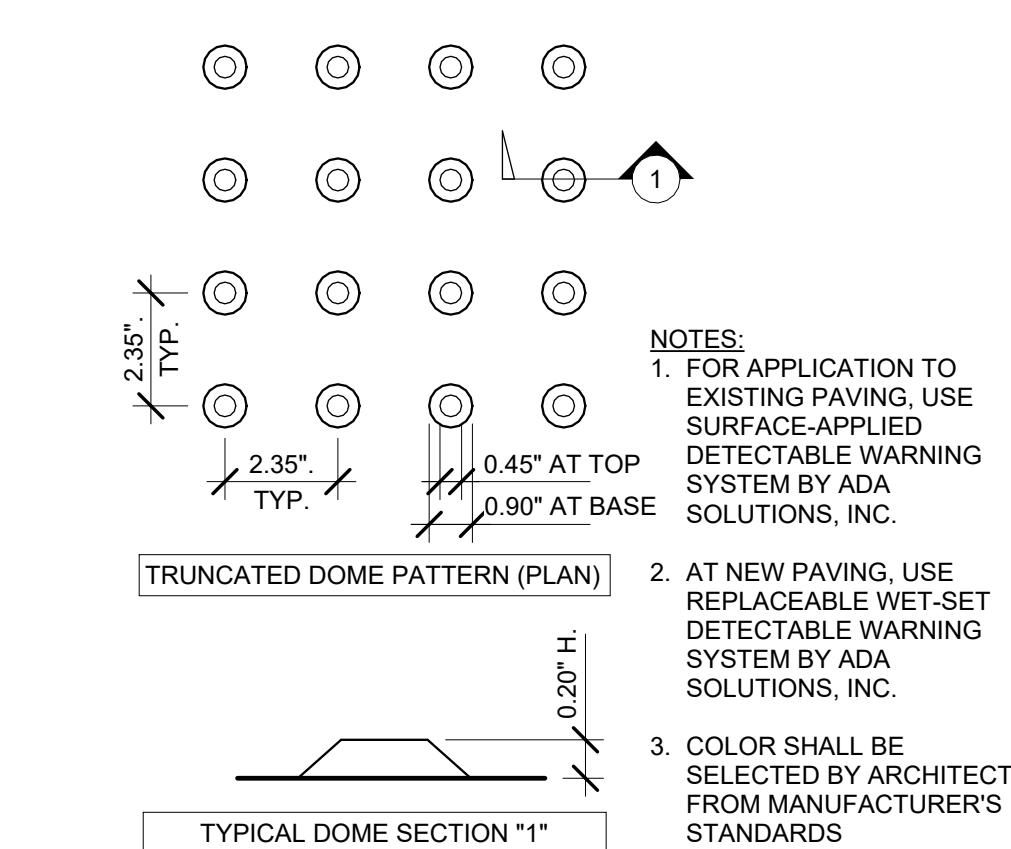


(L) DETECTABLE WARNING
3" = 1'-0"

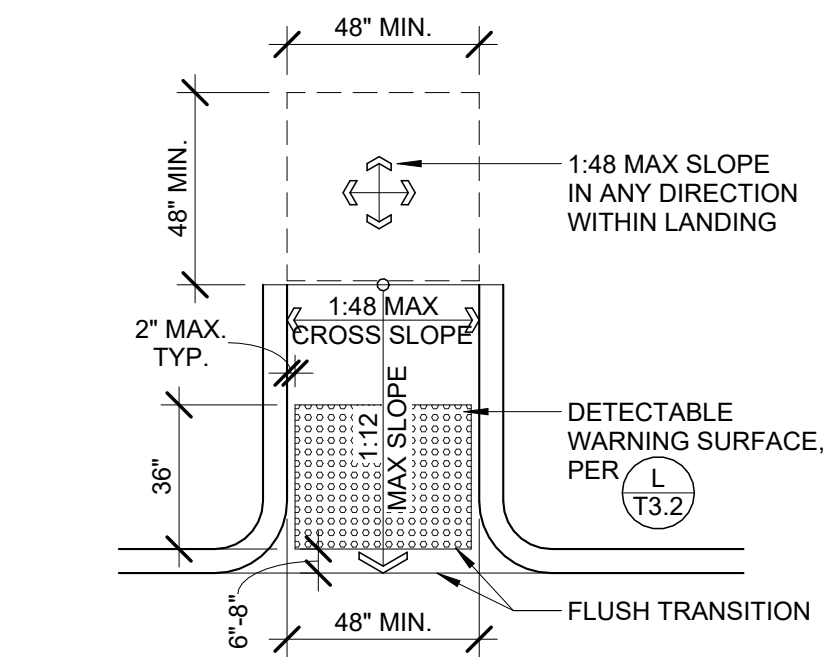


(M) CURB RAMP @ RETAINING CURB
1/4" = 1'-0"

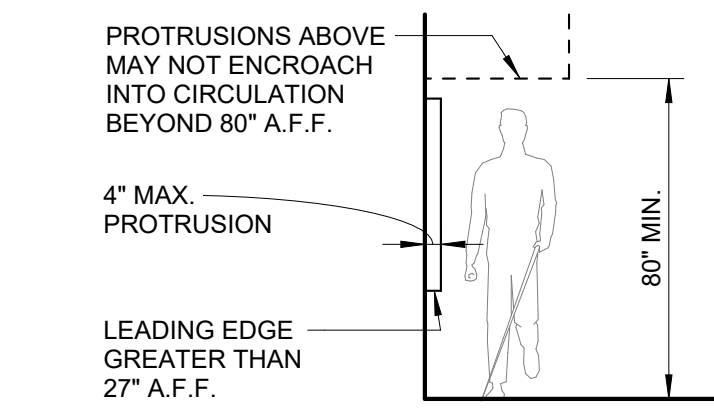


(F) PROTRUSION LIMITS
1/4" = 1'-0"

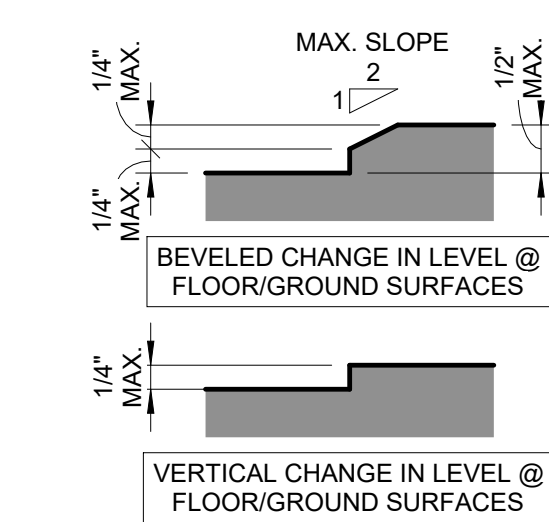


(G) VERTICAL OFFSETS
6" = 1'-0"

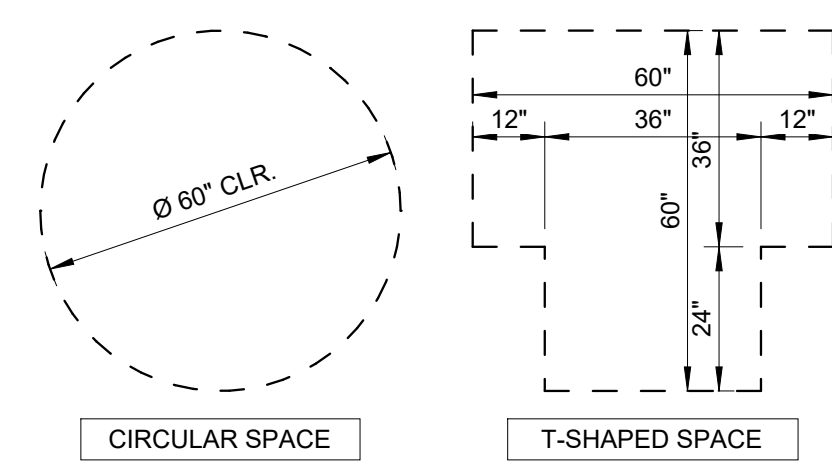


(H) TURNING SPACE
3/8" = 1'-0"

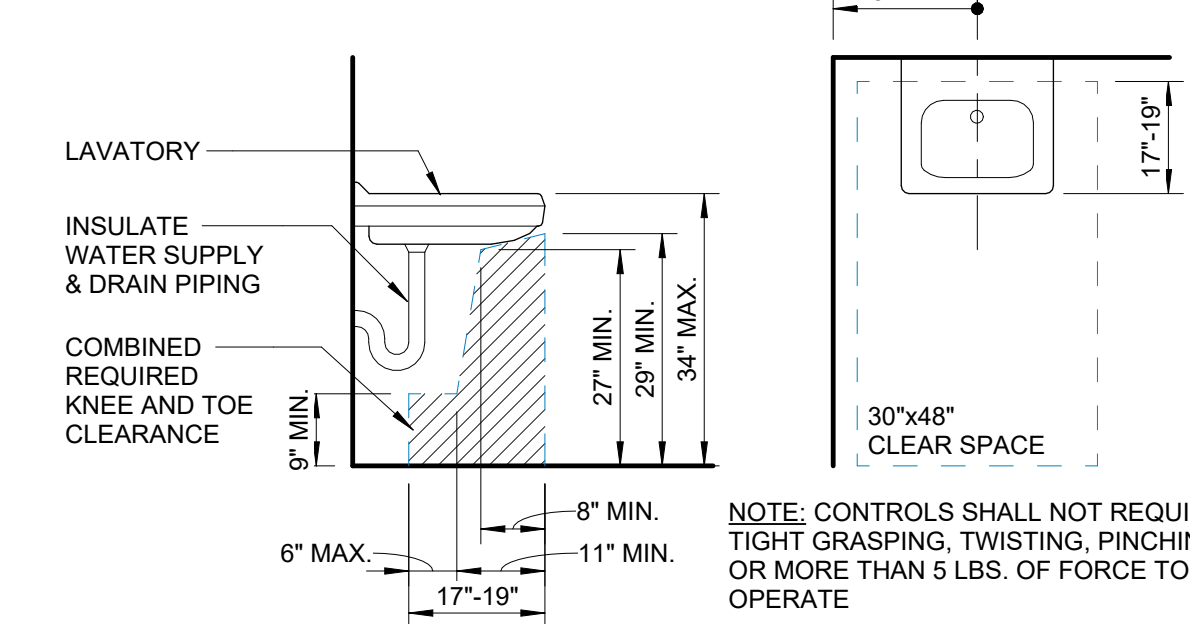

(C) ACCESSIBLE LAVATORY
1/2" = 1'-0"

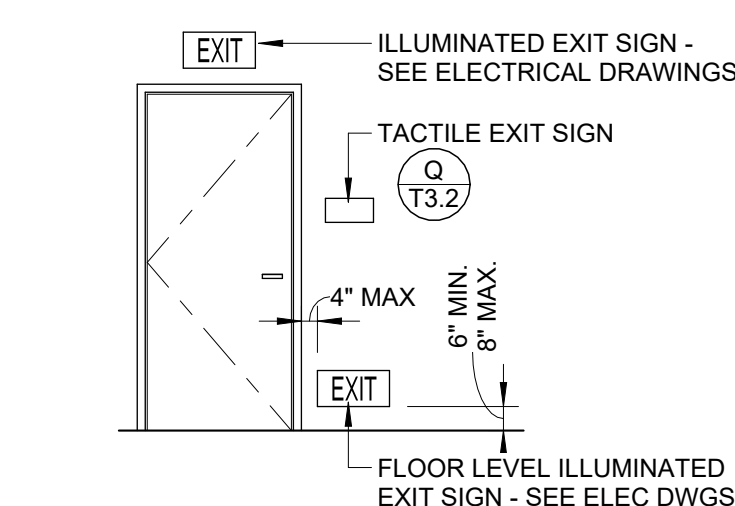

(R) ILLUMINATED EXIT SIGNS
1/4" = 1'-0"

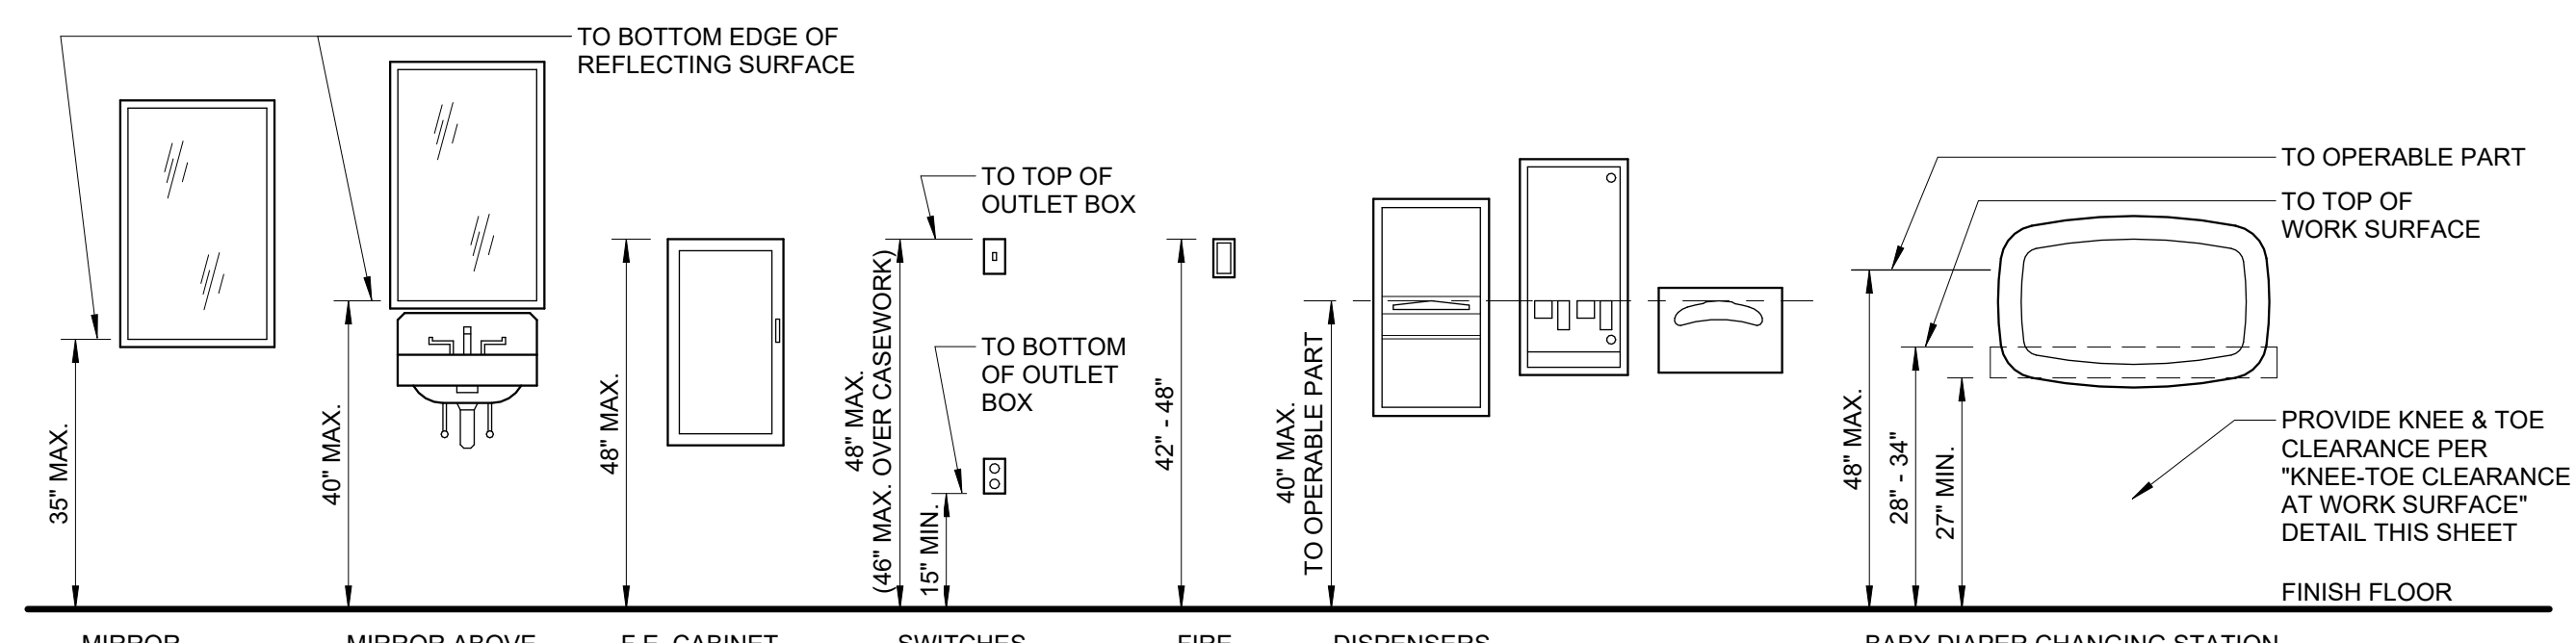

(J) MOUNTING HEIGHTS
1/2" = 1'-0"



WMB ARCHITECTS

5757 Pacific Avenue
Suite 226
Stockton, CA 95207


2000 L Street
Suite 125
Sacramento, CA 95811

T 209.944.9110
F 209.944.5711
www.wmbarchitects.com

CITY PROJECT NO.
24-010
FIRE STATION NO. 31,
SCBA COMPRESSOR
ROOM

540 E MARSHALL ST.
TURLOCK, CA 95380

WMB Project No. 24-023

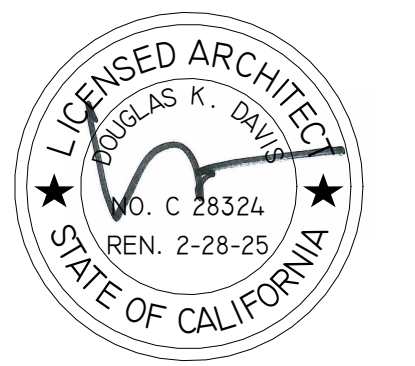


PUBLISH HISTORY:

DATE PURPOSE
11.08.24 BLDG PERMIT APP
02.18.25 Plan Check #1

DEMOLITION PLANS

D2.1

LEGEND

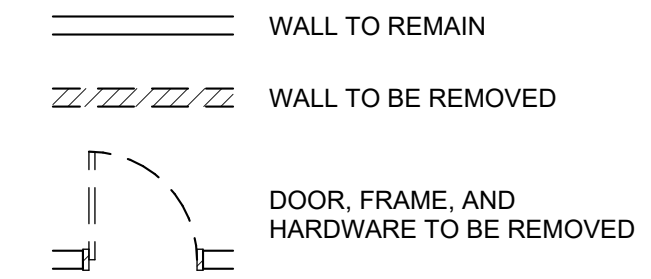


GENERAL NOTES


- 1. ALL ITEMS IDENTIFIED TO BE DEMOLISHED OR REMOVED SHALL MEAN THAT THE SUBJECT ITEM IS THE PROPERTY OF THE CONTRACTOR AND SHALL BE REMOVED FROM THE SITE AND RECYCLED, REUSED OR LEGALLY DISPOSED OF BY THE CONTRACTOR IN ACCORDANCE WITH THE CITY OF TURLOCK STANDARD SPECIFICATIONS SECTION 7-10: DISPOSAL OF MATERIALS OUTSIDE THE RIGHT OF WAY.
- 2. ALL ITEMS NOT IDENTIFIED TO BE DEMOLISHED OR REMOVED ARE EXISTING TO REMAIN. THE CONTRACTOR SHALL TAKE REQUIRED PRECAUTION TO PROTECT ALL EXISTING ITEMS.
- 3. A HAZARDOUS MATERIALS SURVEY HAS BEEN CONDUCTED ON THE PROPERTY AND HAS BEEN INCLUDED IN THE PROJECT SPECIFICATIONS FOR REFERENCE. ANY IDENTIFIED OR SUSPECT HAZARDOUS MATERIALS SHALL BE ABATED IN ACCORDANCE WITH SECTION 5.17: REMOVAL OF ASBESTOS AND HAZARDOUS SUBSTANCES IN THE SPECIAL PROVISIONS.
- 4. REFER TO MECHANICAL, PLUMBING, AND ELECTRICAL DRAWINGS FOR ADDITIONAL DEMOLITION INFORMATION. MECHANICAL GRILLES, PLUMBING FIXTURES, AND ELECTRICAL FIXTURES SHOWN FOR COORDINATION PURPOSES ONLY.
- 5. ANNUNCIATION SPEAKER SYSTEM TO REMAIN ACTIVE DURING CONSTRUCTION.

KEYNOTES


- 02.01 REMOVE DOOR, FRAME, AND HARDWARE
- 02.02 REMOVE LAVATORY & CAP OUTPIPES - REF. PLUMBING DWGS.
- 02.03 FRAMED WALL TO BE REMOVED FULL HEIGHT
- 02.04 REMOVE PORTION OF WALL TO CREATE NEW OPENING - SHORE AS REQ'D TO ACCOMMODATE DEMOLITION
- 02.05 REMOVE FINISH FLOORING AND (E) CERAMIC TILE WALL BASE THROUGHOUT
- 02.06 DEMO & REMOVE (E) COUNTERTOP & UPPER CABINETS
- 02.07 REMOVE INTERIOR GYP. WALLBOARD- ENTIRE WALL
- 02.08 DEMO & REMOVE MECHANICAL EQUIP. - REF MECH. DWGS.
- 02.09 DEMO & REMOVE LIGHT FIXTURE
- 02.10 RELOCATE EXISTING DOOR PER IMPROVEMENT PLAN. REMOVE EXISTING DOOR FRAME
- 02.11 EXISTING DOOR TO REMAIN
- 02.12 REMOVE AND DISCARD WALL LOUVER- OPENING TO REMAIN
- 02.14 BOLLARD TO REMAIN
- 02.15 REMOVE AND DISCARD WALL LOUVER
- 02.16 REMOVE CONDENSER UNIT
- 02.17 (E) CONDENSER UNIT TO REMAIN

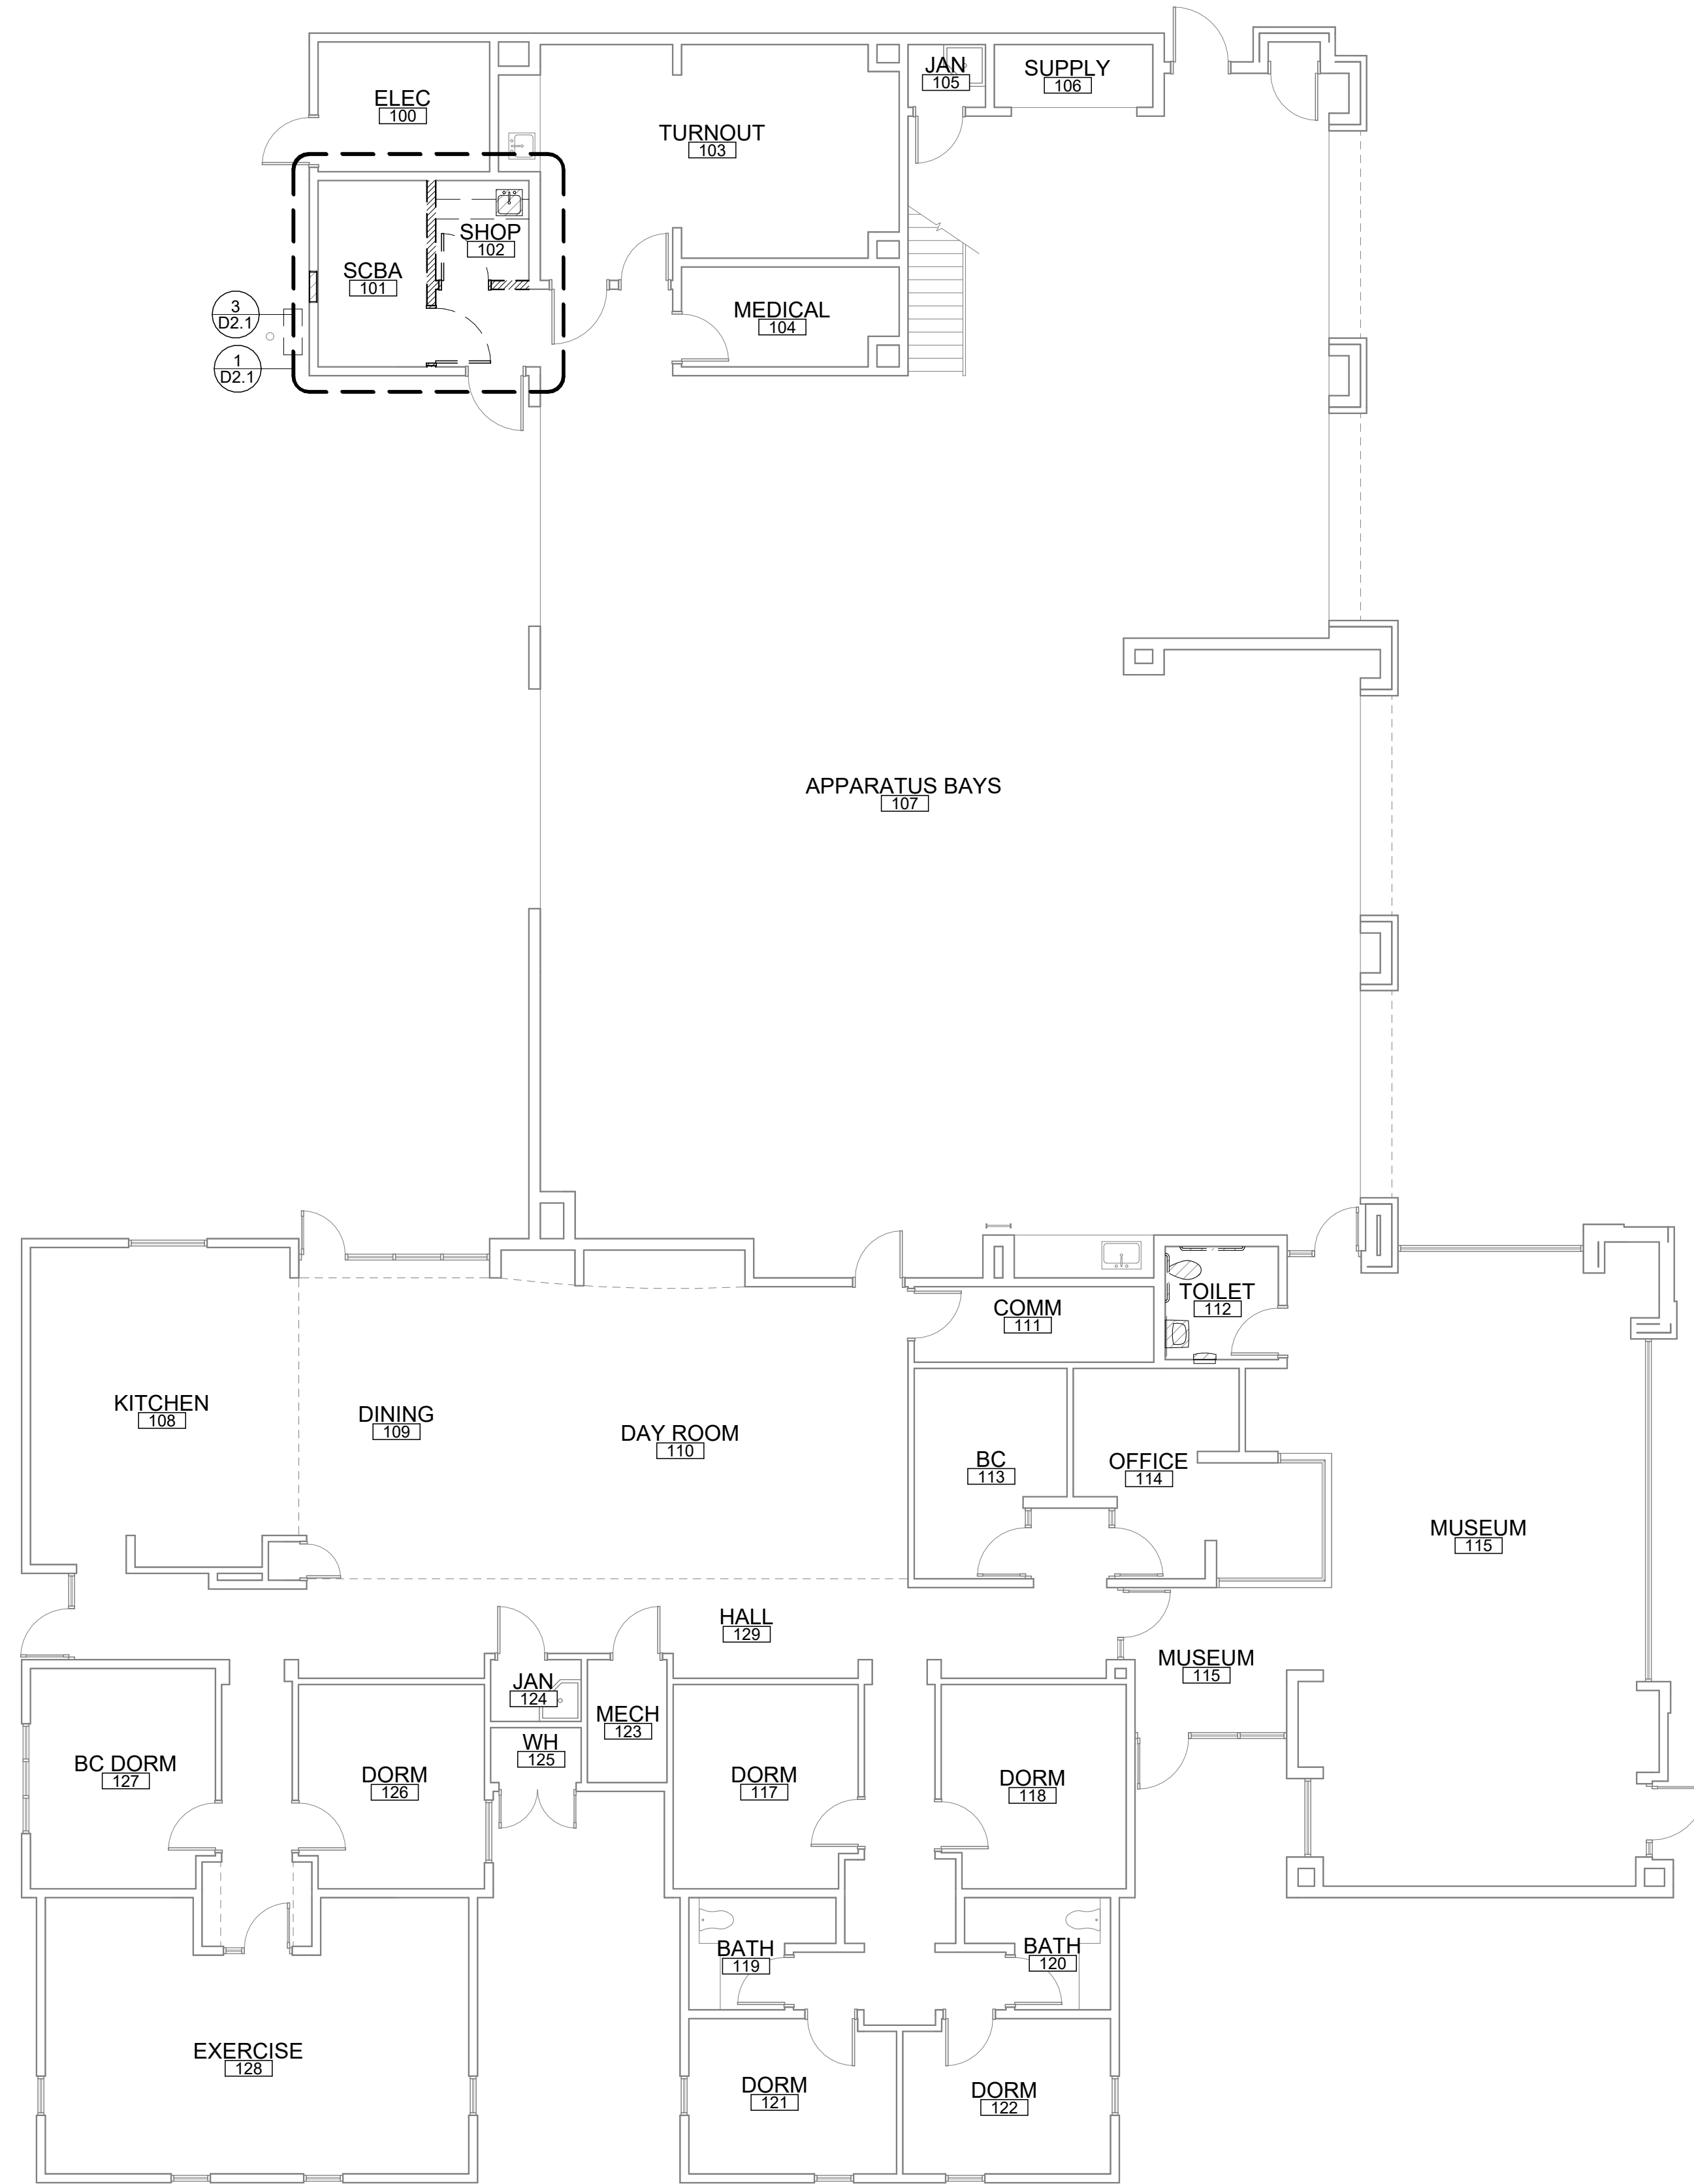


DEMOLITION FLOOR PLAN
1/8" = 1'-0"

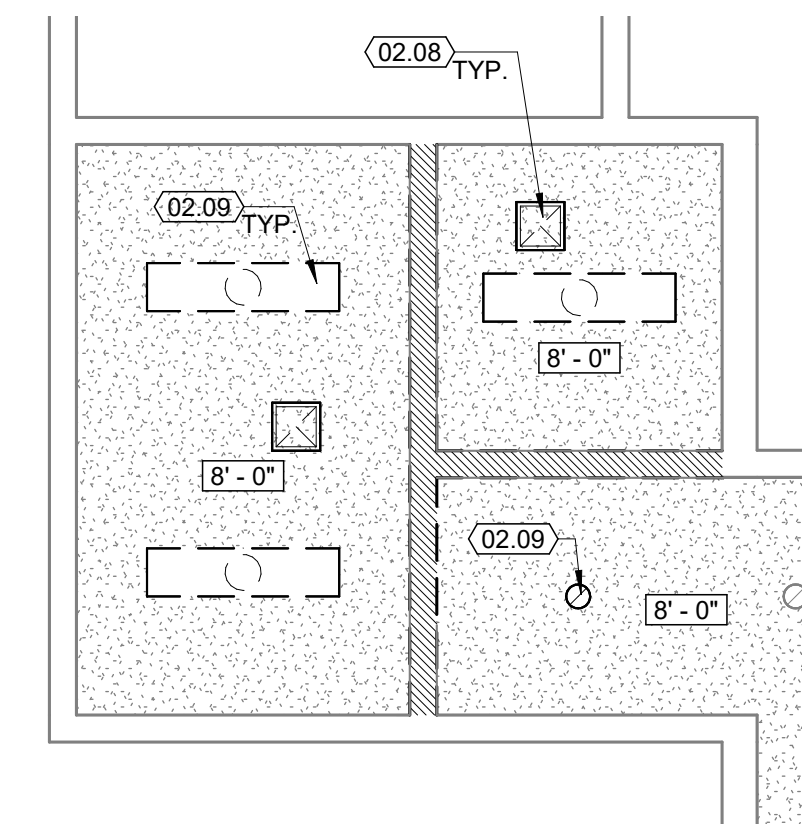

DEMOLITION CEILING PLAN
1/4" = 1'-0"

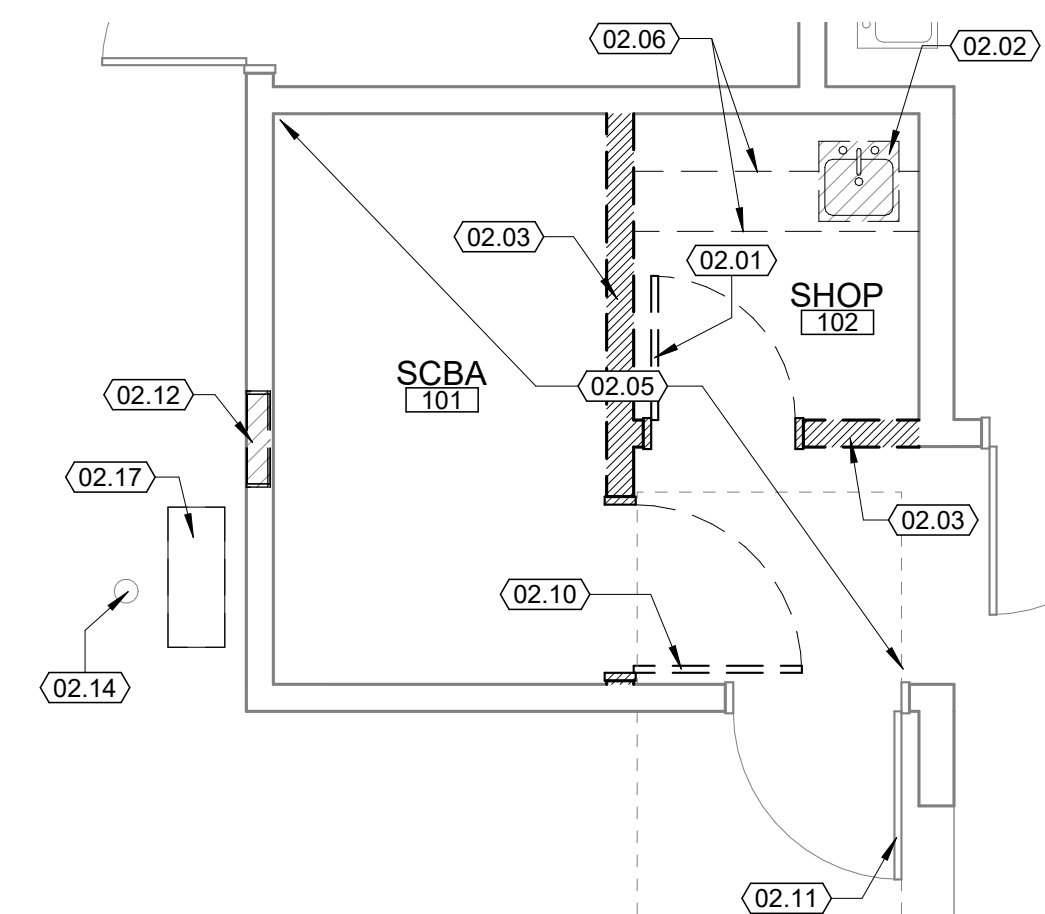

ENLARGED DEMO FLOOR PLAN
1/4" = 1'-0"

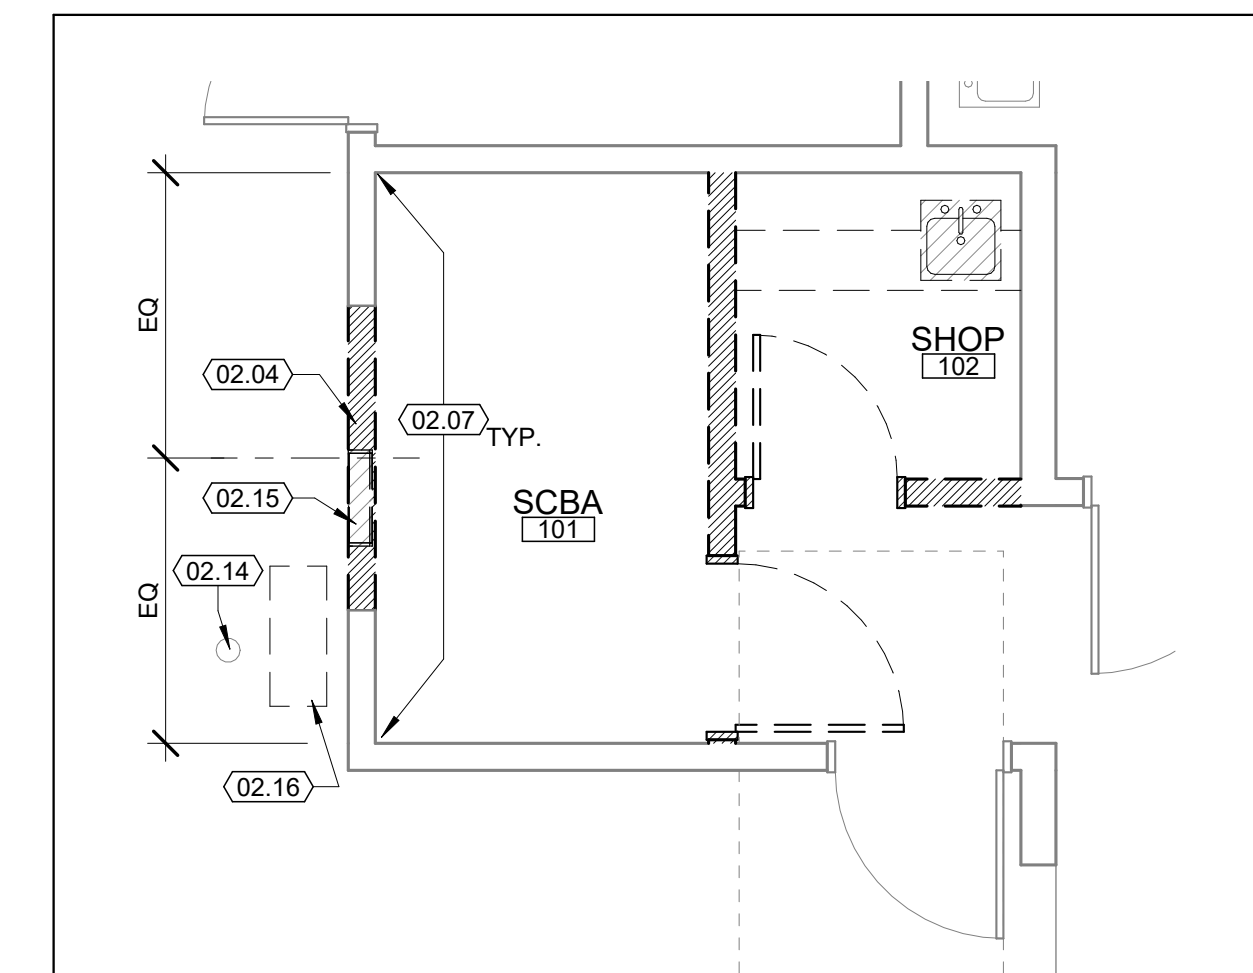

BID ALT 1 - ENLARGED DEMO FLR. PLAN
1/4" = 1'-0"

INTERIOR WALL SCHEDULE

NO.	CORE	INSUL.	WALLBOARD	EXTENT	DETAILS	
					HEAD	SILL
1	2x6 D.F. STUDS @ 16" O.C.	ACOUST. F.G. BATT.	5/8" GYP. BD. BOTH SIDES [1][2]	CORE, INSUL. & WALLBD. ONE SIDE TO UNDERSIDE OF ROOF DECK; WALLBD. ONE SIDE TO 6" ABOVE FINISH CEILING	D / A8.1	C / A8.1

[1] INTERIOR SHEAR PLY NOT INDICATED - COORDINATE LOCATIONS W/ STRUCTURAL DRAWINGS
 [2] PROVIDE MOISTURE-RESISTANT GYP. BD. AT ALL WET LOCATIONS AND/OR TO RECEIVE WALL TILE - REF. A10.1
 [3] MINIMUM SIZE, GAUGE, AND SPACING INDICATED - COORDINATE ADDITIONAL REQUIREMENTS AS SPECIFIED PER STRUCT. DWGS.

LEGEND


- EXISTING WALL TO REMAIN
- NEW WALL
- INTERIOR WALL TYPE - REF. SCHEDULE THIS SHEET
- DOOR NUMBER - REF. A8.1 FOR SCHEDULE
- ALIGN ADJACENT FINISH SURFACES
- CENTERLINE DESIGNATION
- 5/8" GYP. BD. ov/ JOISTS, PER CEILING FRAMING SCHEDULE
- CEILING HEIGHT ABOVE FINISH FLOOR LEVEL
- SURFACE-MOUNTED LIGHT FIXTURE
- SUPPLY AIR GRILLE
- RETURN AIR GRILLE
- EXHAUST GRILLE
- ILLUMINATED EXIT SIGN

GENERAL NOTES


1. GRID LINES ARE TO FACE OF STUD, U.O.N.
2. DIMENSIONS SHOWN ARE TO FACE OF STUD, U.O.N.
 • DIMENSIONS NOTED "CLR." ARE TO FACE OF FINISH
3. PLUMBING FIXTURES SHOWN FOR COORDINATION PURPOSES ONLY. REFER TO PLUMBING DRAWINGS FOR FIXTURE SPECIFICATIONS.
4. MECHANICAL GRILLES AND ELECTRICAL FIXTURES SHOWN FOR COORDINATION PURPOSES ONLY. REFER TO MECHANICAL AND ELECTRICAL SHEETS FOR MORE INFORMATION.

KEYNOTES


- 01.14 (N) PHOTO-LUMINESCENT SIGN - SEE DETAIL R/T3.2
- 01.15 (N) TACTILE SIGN - SEE DETAIL P/T3.2
- 08.01 RELOCATED DOOR- REFER TO DOOR SCHEDULE FOR NEW HARDWARE
- 08.02 BID ALT. #1: NEW DOUBLE DOOR PER SCHEDULE
- 08.03 (N) WALL LOUVER IN (E) OPENING
- 09.01 PATCH & REPAIR (E) GYPSUM BOARD CEILING TO MATCH (E) - REFER TO SPECIFICATIONS
- 09.02 (N) WALL BASE- REF. FINISH SCHEDULE A8.1
- 09.03 REPAIR, PREP, AND CLEAN CONCRETE SLAB SURFACE IN ACCORDANCE WITH SEALER MANUFACTURERE'S REQUIREMENTS
- 09.04 PATCH CERAMIC TILE BASE TO MATCH (E) ADJACENT BASE
- 09.05 INSTALL, FINISH AND PAINT (N) 5/8" GYP. WALLBOARD ov/ (N) SHEAR PLY PER STRUCT. (ENTIRE WALL)
- 09.06 PATCH (E) GYPSUM BD. AS REQ. TO CREATE A UNIFORM WALL SURFACE THROUGHOUT. PAINT ENTIRE SURFACE OF ALL WALLS, CEILINGS, DOOR & DOOR FRAMES PER DOOR AND FINISH SCHEDULE - A8.1
- 11.01 (N) CONDENSOR UNIT - BID ALT 1
- 11.02 BAUER COMPRESSOR- OWNER'S VENDOR WILL DELIVER AND PLACE THE UNIT AND MAKE FINAL ELECTRICAL CONNECTIONS. CONTRACTOR SHALL ANCHOR UNIT PER STRUCTURAL PLANS.
- 11.03 (N) CONDENSOR UNIT - BID ALT 2
- 26.01 LIGHT FIXTURE - REF. ELECTRICAL DWGS.
- 32.10 (N) PIPE BOLLARD - REF. DETAIL L/A8.1. REVIEW LAYOUT OF CONDENSING UNITS AND BOLLARDS ON-SITE WITH CITY PROJECT MANAGER PRIOR TO PREP WORK

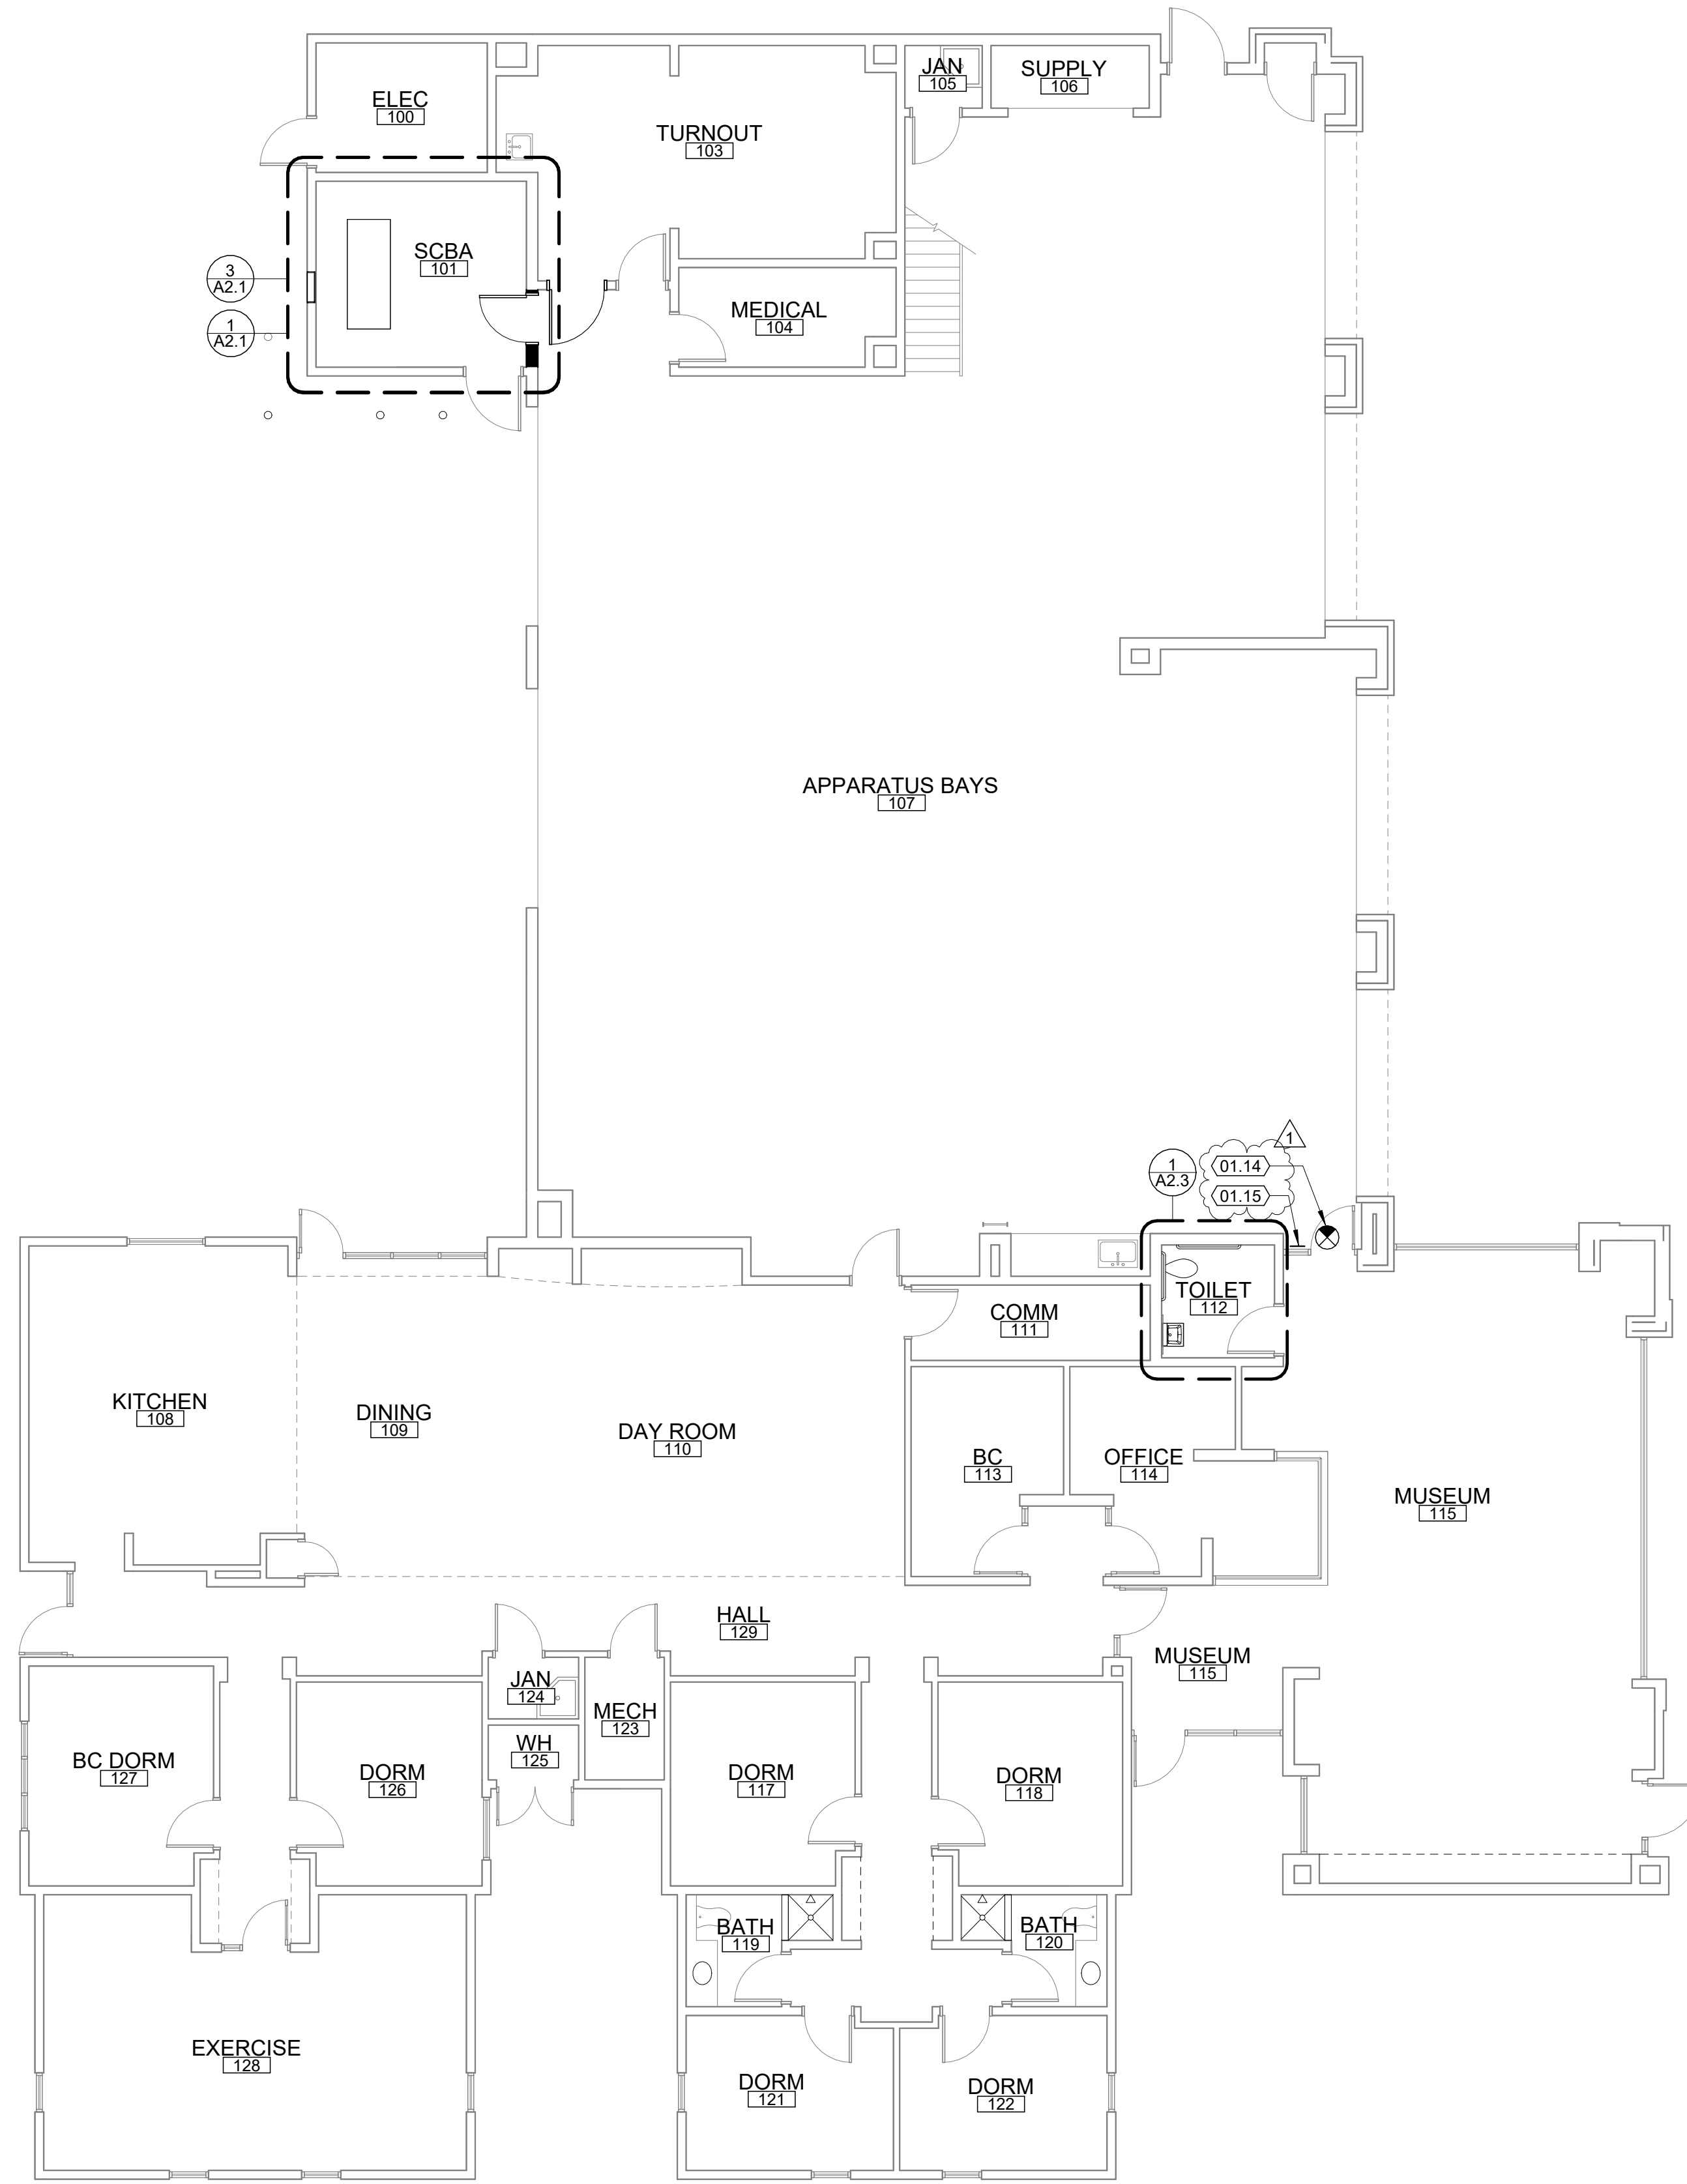


FLOOR PLAN
1/8" = 1'-0"

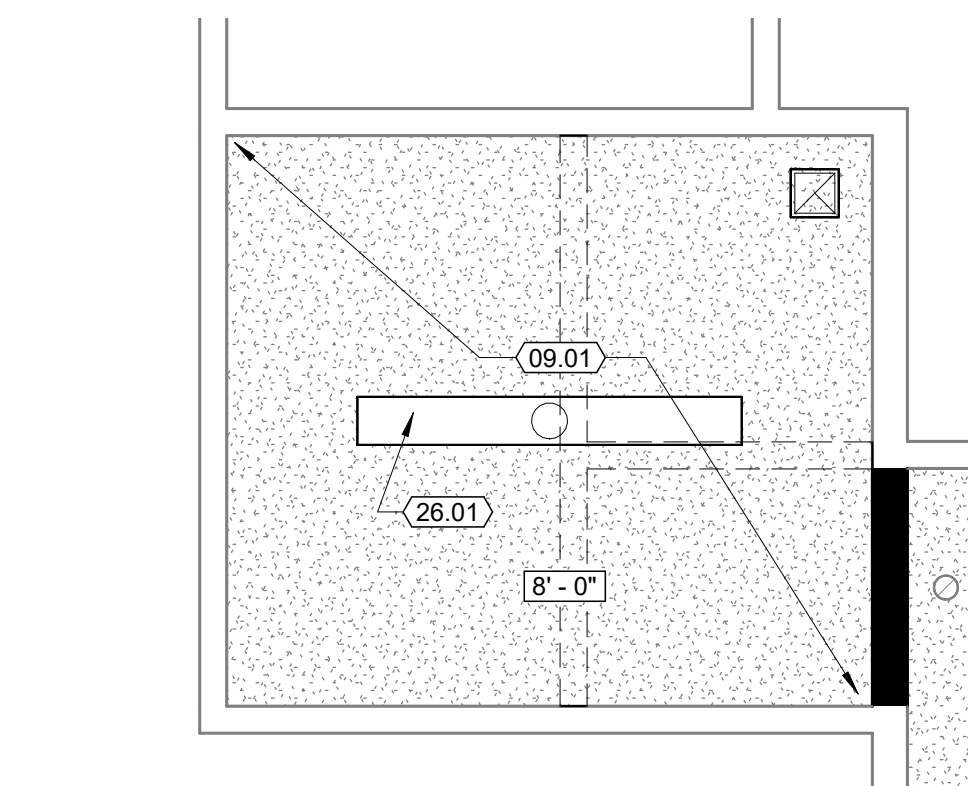

2 REFLECTED CEILING PLAN
1/4" = 1'-0"

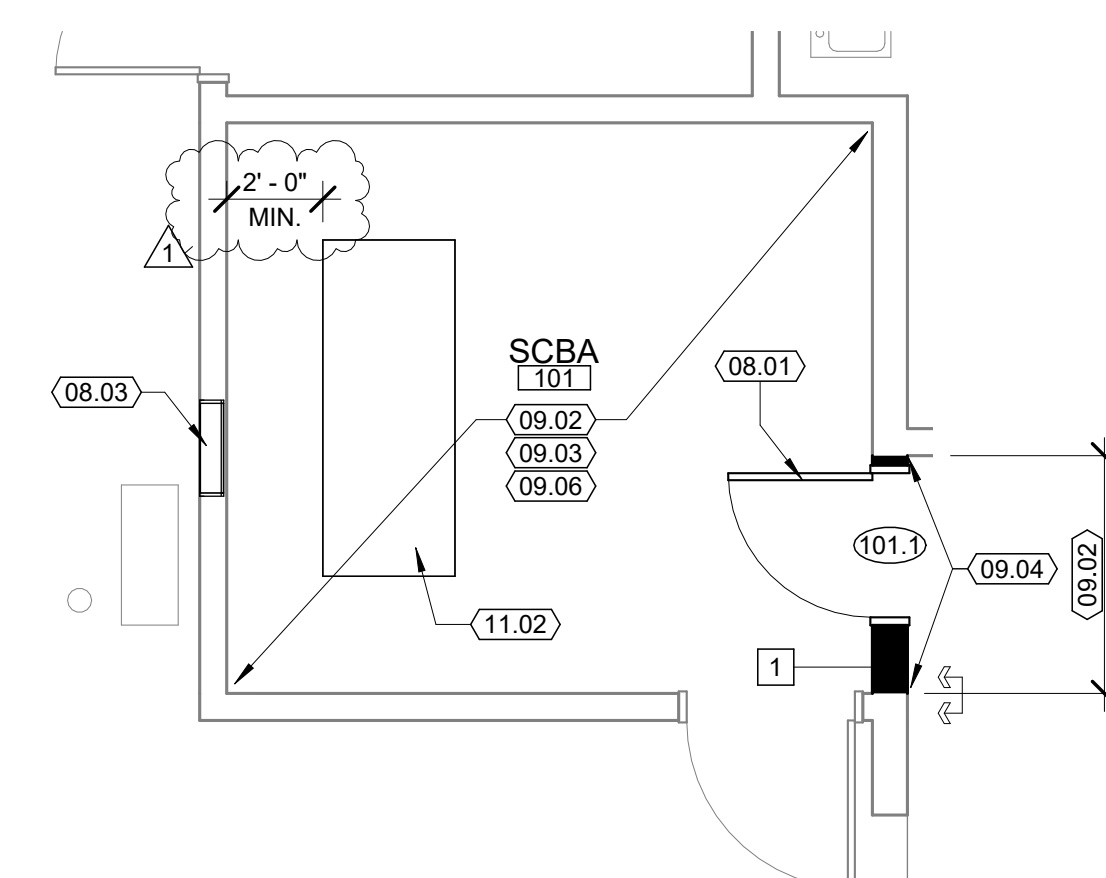

1 PARTIAL FLOOR PLAN
1/4" = 1'-0"

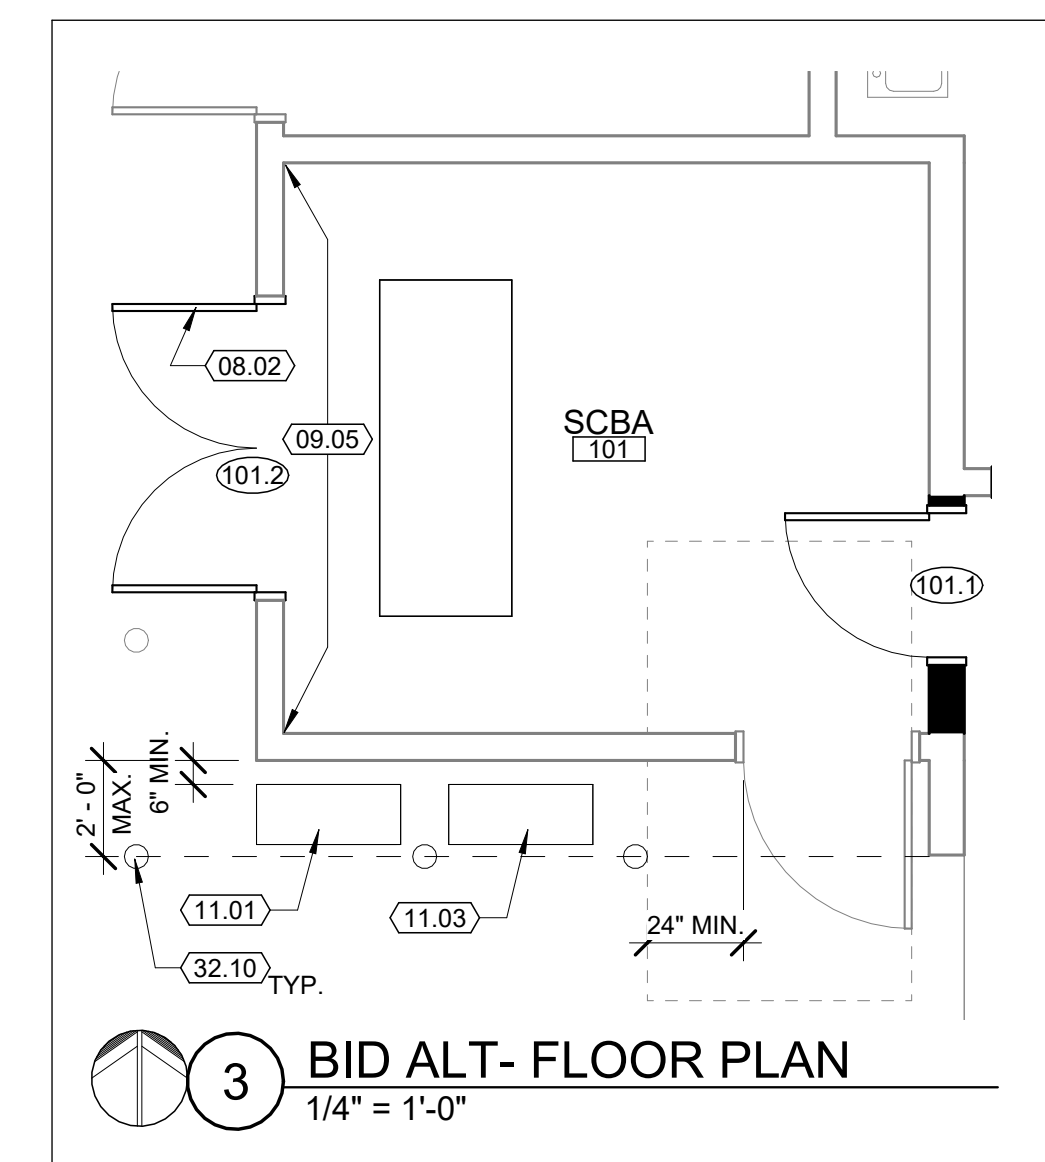

3 BID ALT- FLOOR PLAN
1/4" = 1'-0"



WMB ARCHITECTS

5757 Pacific Avenue
Suite 226
Stockton, CA 95207


2000 L Street
Suite 125
Sacramento, CA 95811

T 209.944.9110
F 209.944.5711
www.wmbarchitects.com

CITY PROJECT NO.
24-010
FIRE STATION NO. 31,
SCBA COMPRESSOR
ROOM

540 E MARSHALL ST.
TURLOCK, CA 95380

WMB Project No. 24-023

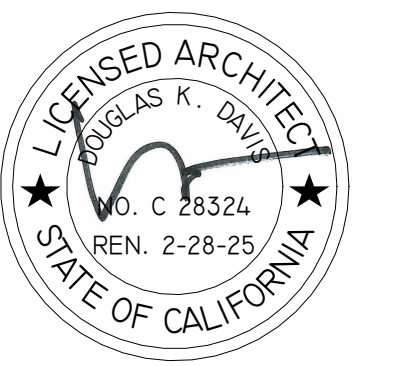

PUBLISH HISTORY:

DATE	PURPOSE
11.08.24	BLDG PERMIT APP
02.18.25	Plan Check #1

REMODEL FLOOR PLANS

A2.1



WMB ARCHITECTS

5757 Pacific Avenue
Suite 226
Stockton, CA 95207


2000 L Street
Suite 125
Sacramento, CA 95811

T 209.944.9110
F 209.944.5711
www.wmbarchitects.com

CITY PROJECT NO.
24-010
FIRE STATION NO. 31,
SCBA COMPRESSOR
ROOM

540 E MARSHALL ST.
TURLOCK, CA 95380

WMB Project No. 24-023

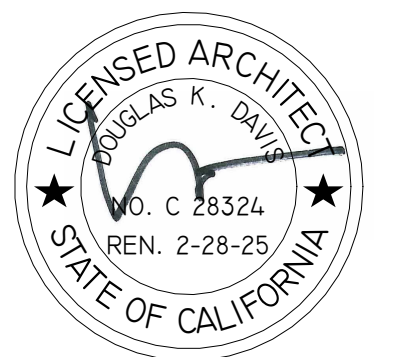

PUBLISH HISTORY:

DATE	PURPOSE
11.08.24	BLDG PERMIT APP
02.18.25	Plan Check #1

ENLARGED FLOOR PLAN +
INTERIOR ELEVATIONS

A2.3

LEGEND


- ↕ ALIGN ADJACENT FINISH SURFACES
- ⊕ CENTERLINE DESIGNATION

GENERAL NOTES


- REFER TO SHEET T3.2 FOR MOUNTING HEIGHTS, CLEARANCES AND ADDITIONAL REQUIREMENTS FOR ACCESSIBILITY
- PATCH HOLES IN (E) WALL TILE CAUSED BY IMPROVEMENT WORK WITH COLOR - MATCHED EPOXY FILLER
- PLUMBING FIXTURES SHOWN FOR COORDINATION PURPOSES ONLY.

KEYNOTES


- 01.02 ADJUST (E) TOILET SEAT COVER DISPENSER TO COMPLY WITH MAX. MOUNTING HEIGHT PER DETAIL J/T3.2 AND LOCATION PER PLAN DIMENSIONS AND DETAIL A/T3.2
- 01.03 ADJUST (E) GRAB BAR TO COMPLY WITH MOUNTING HEIGHT REQUIREMENTS PER DETAIL J/T3.2 AND LOCATION PER PLAN DIMENSIONS AT DETAIL A/T3.2
- 01.04 SHIFT (E) WATER CLOSET APPROX. 1/2" SO THAT CENTERLINE OF FIXTURE IS 17" MIN. AND 18" MAX. FROM SIDEWALL. FIELD VERIFY EXISTING CONDITION
- 01.05 ADJUST (E) TOILET TISSUE DISPENSER PER DETAIL A/T3.2
- 01.06 LOWER (E) MIRROR SO THAT BOTTOM OF REFLECTING SURFACE IS 40" MAX. ABOVE FINISH FLOOR
- 01.08 ADJUST (E) SOAP DISPENSER TO COMPLY WITH MAX. MOUNTING HEIGHT PER DETAIL J/T3.2
- 01.09 (E) SIGN, ADJUST MOUNTING HEIGHT PER DETAIL A/A2.3
- 01.10 (E) SYMBOL, ADJUST MOUNTING HEIGHT PER DETAIL B/A2.3
- 01.11 (E) COAT HANGER TO REMAIN
- 01.12 PROVIDE & INSTALL (N) COAT HANGER 48" MAX. A.F.F.
- 02.18 PERMANENTLY REMOVE EXISTING PROTRUDING WASTE BIN FROM (E) RECESSED PAPER TOWEL DISPENSER UNIT
- 02.19 REMOVE (E) PAPER TOWEL DISPENSER
- 02.20 (E) LAVATORY ENCLOSED INTO WATER CLOSET FIXTURE CLEARANCE. REMOVE (E) LAVATORY AND INSTALL NEW LAVATORY (WS BATH COLLECTIONS PLAIN 45W MODEL OR EQUIVALENT 17.5" MAX. SIDE TO SIDE WIDTH AND ADA COMPLIANT). REMOVE AND REPLACE IN-WALL CARRIER AND PROVIDE ADDITIONAL FRAMING/BLOCKING AS REQ'D. MOUNT LAVATORY PER DETAIL C/T3.2 AND PROVIDED DIMENSIONS. CONNECT TO EXISTING PLUMBING; INSULATED EXPOSED PIPES. PROVIDE LEVER-STYLE FAUCET TRIM. PATCH, REPAIR, AND REPLACE WALLBOARD AND WALL TILE AS REQ'D.

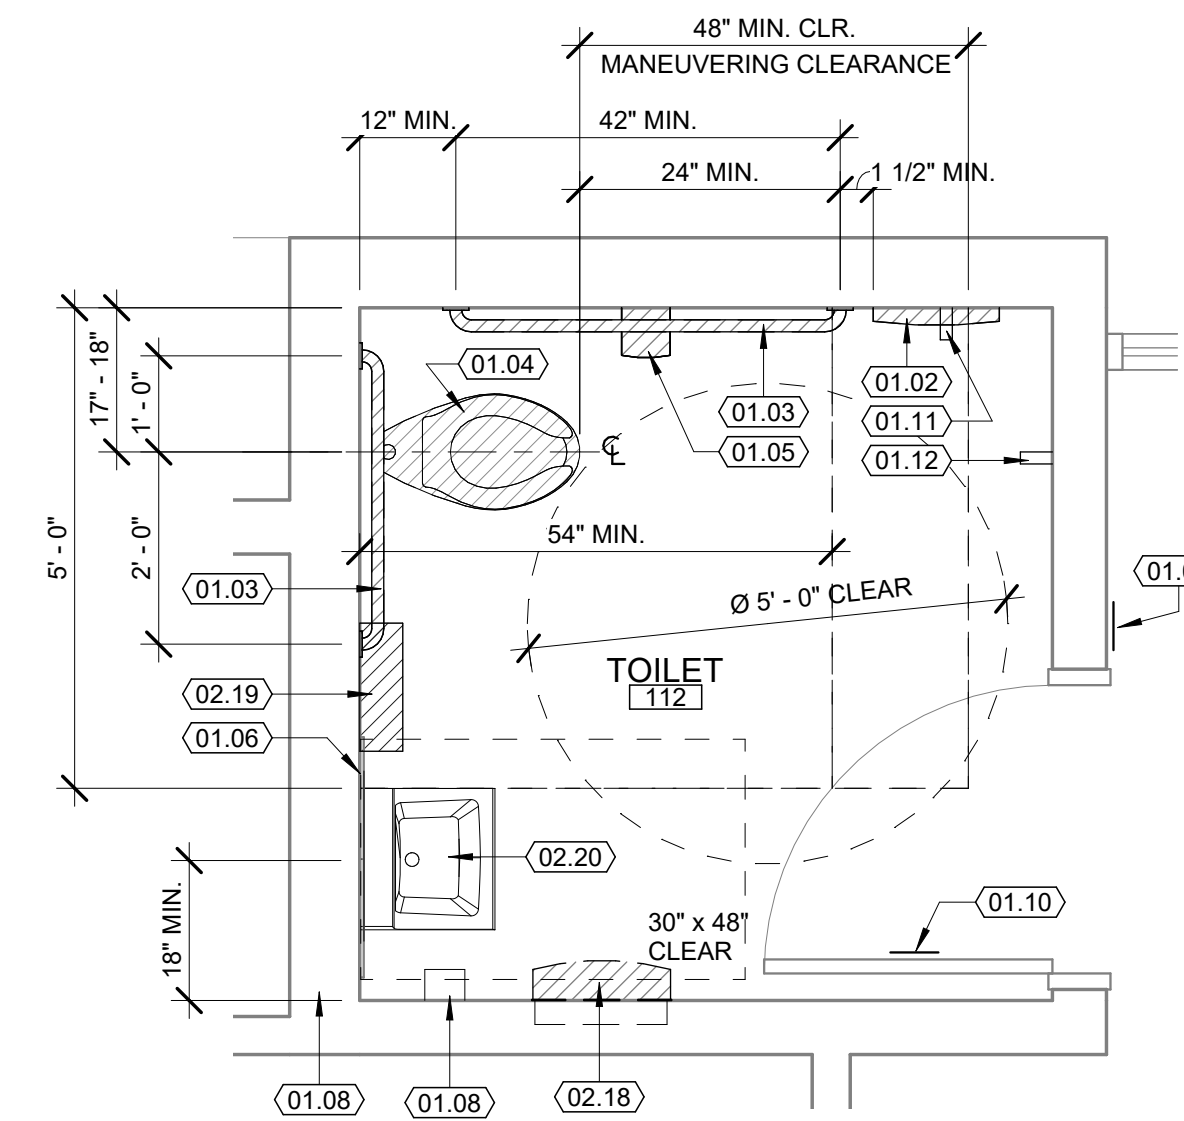

1 ENLARGED TOILET FLOOR PLAN
1/2" = 1'-0"

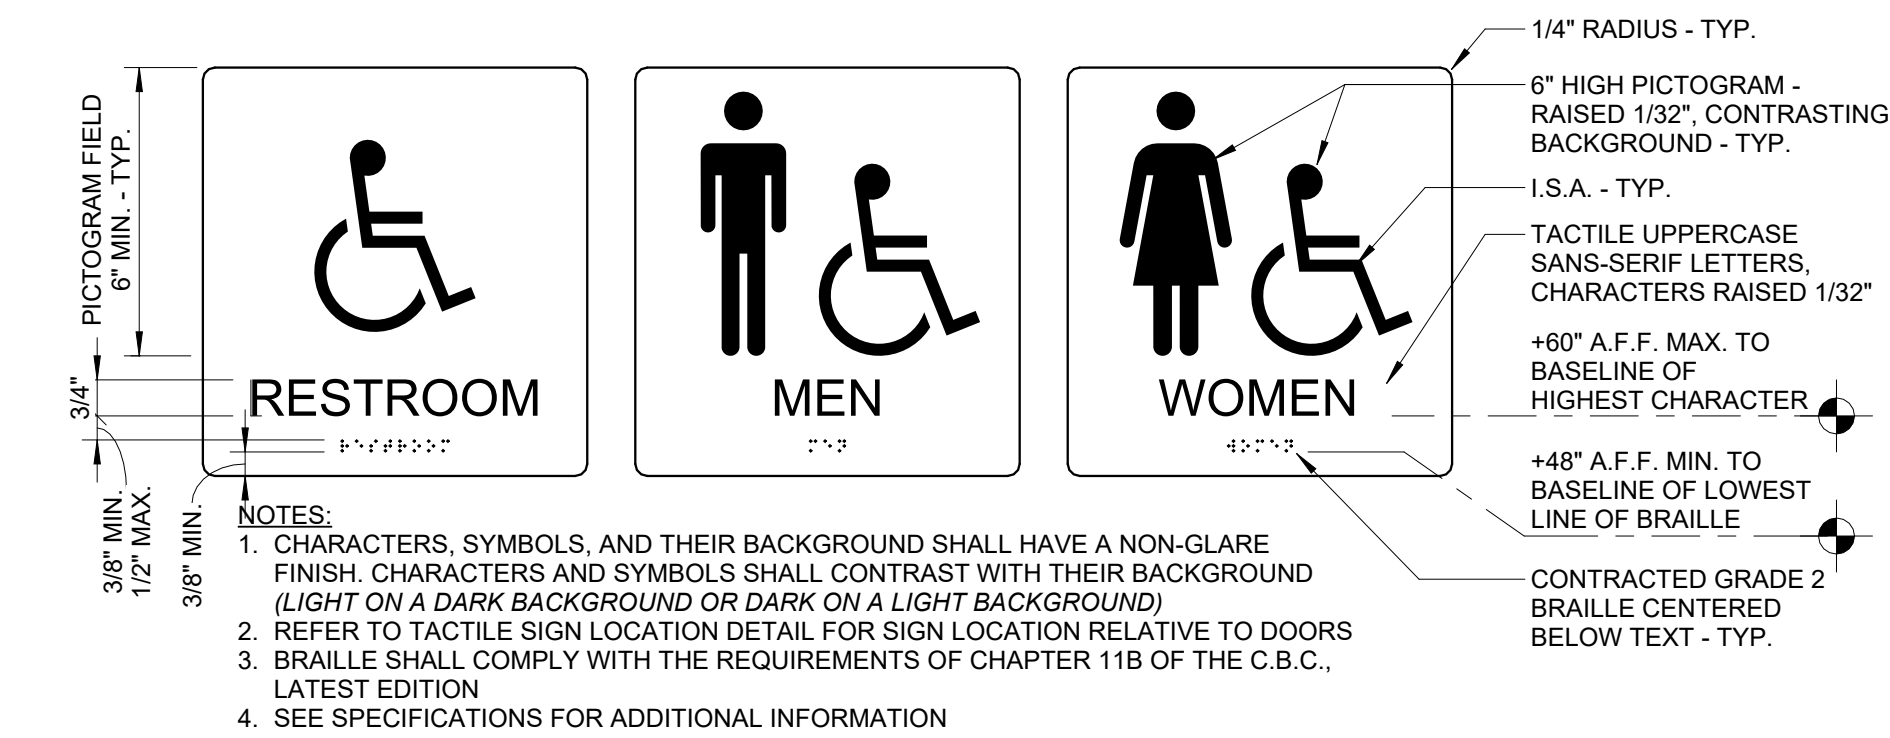

A RESTROOM IDENTIFICATION WALL SIGNAGE
3" = 1'-0"


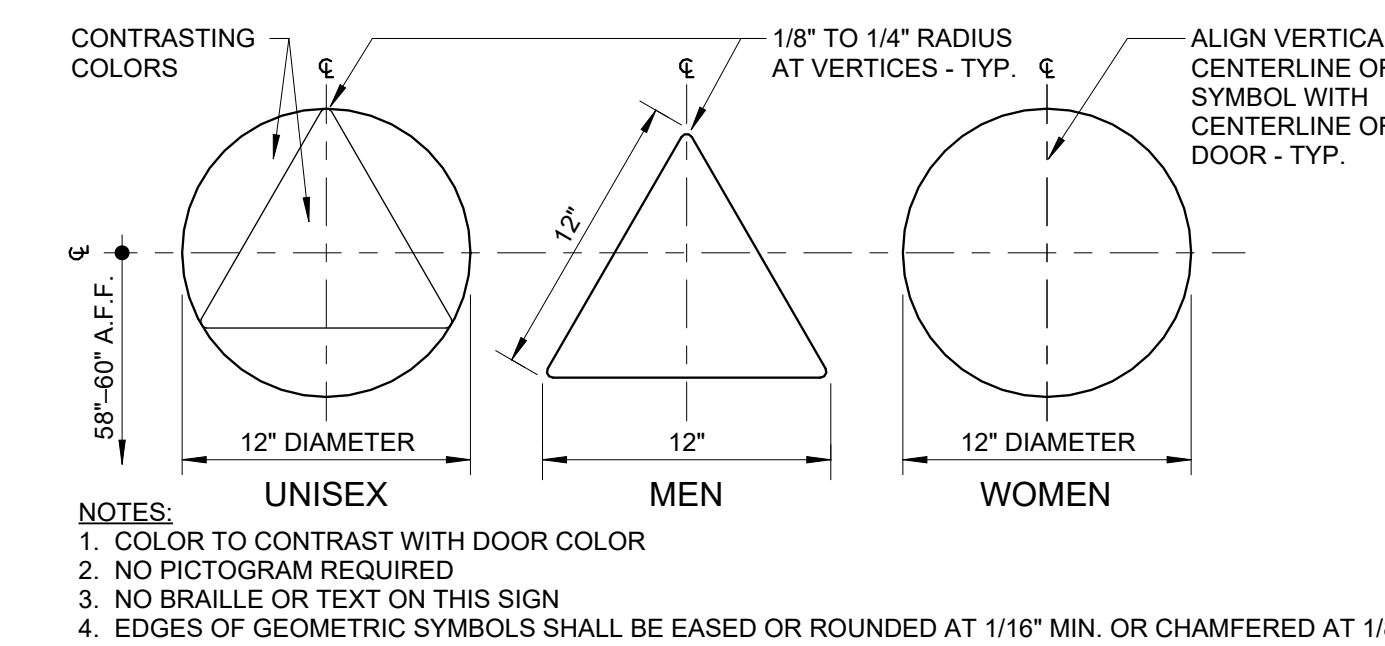


B RESTROOM GEOMETRIC DOOR SYMBOLS
1 1/2" = 1'-0"


BID ALT- DOOR SCHEDULE

NO.	HDWR SET	SIZE		TYPE	THK	PANEL				FRAME			DETAILS			COMMENTS
		WIDTH	HEIGHT			MATERIAL	GLASS	FINISH	COLOR	MATERIAL	FINISH	COLOR	HEAD	JAMB	THD.	
101.2	2	6'-0"	7'-0"	PL	1 3/4"	H.M.	-	PAINT	P2	H.M.	PAINT	P2	G	J	K	PROVIDE (N) DOOR HARDWARE PER SPEC


BID ALT- DOOR PANEL TYPE

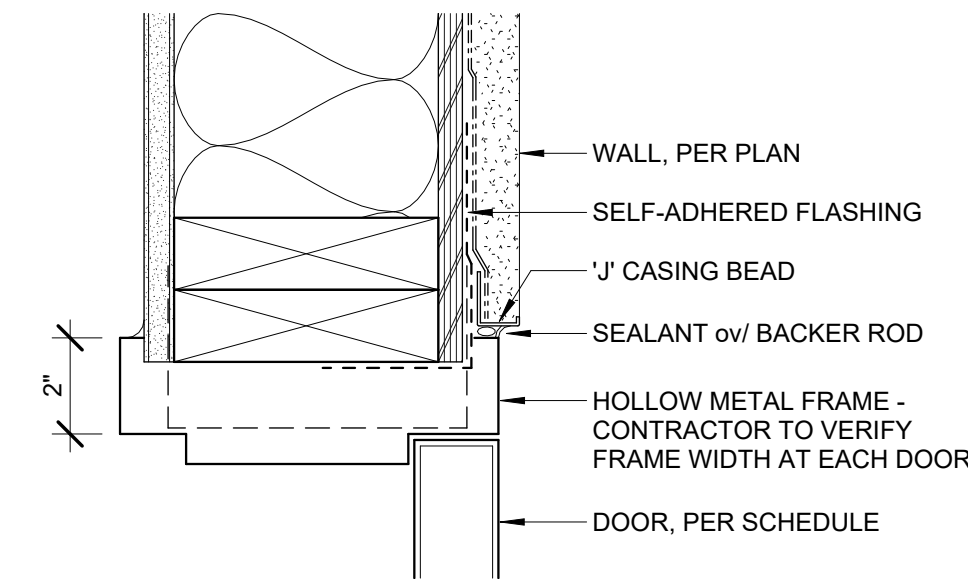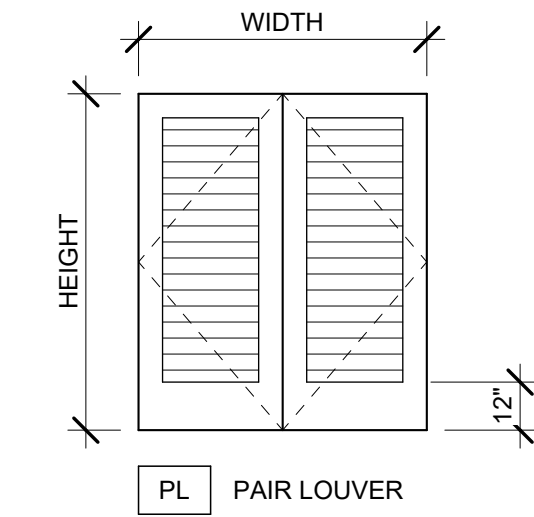


J H.M. DOOR JAMB @ PLASTER
3" = 1'-0"

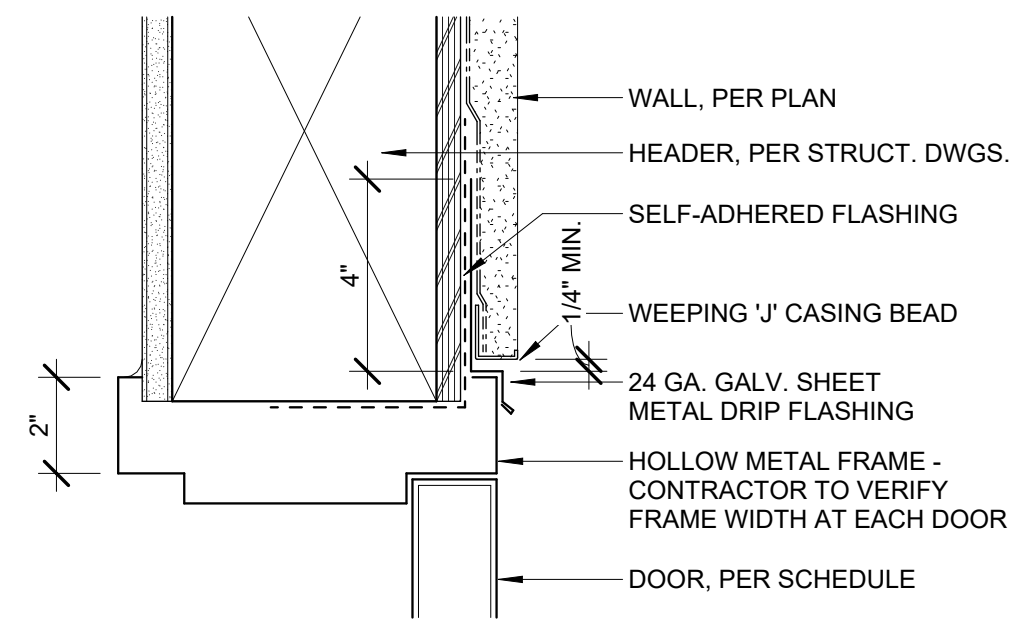

G H.M. DOOR HEAD @ PLASTER
3" = 1'-0"

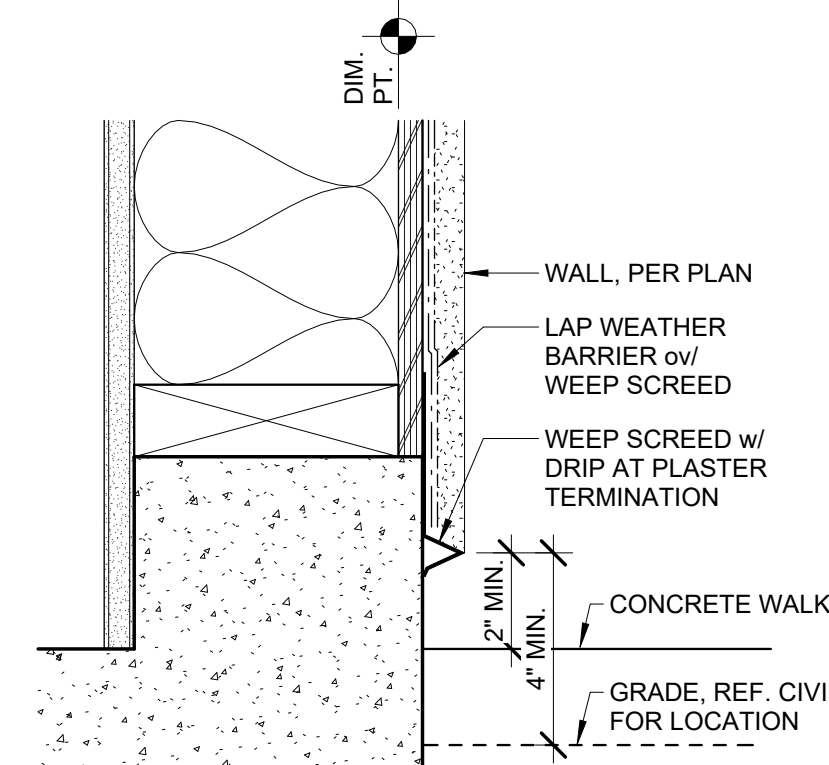


K PLASTER WEEP SCREED @ CONC. CURB
3" = 1'-0"

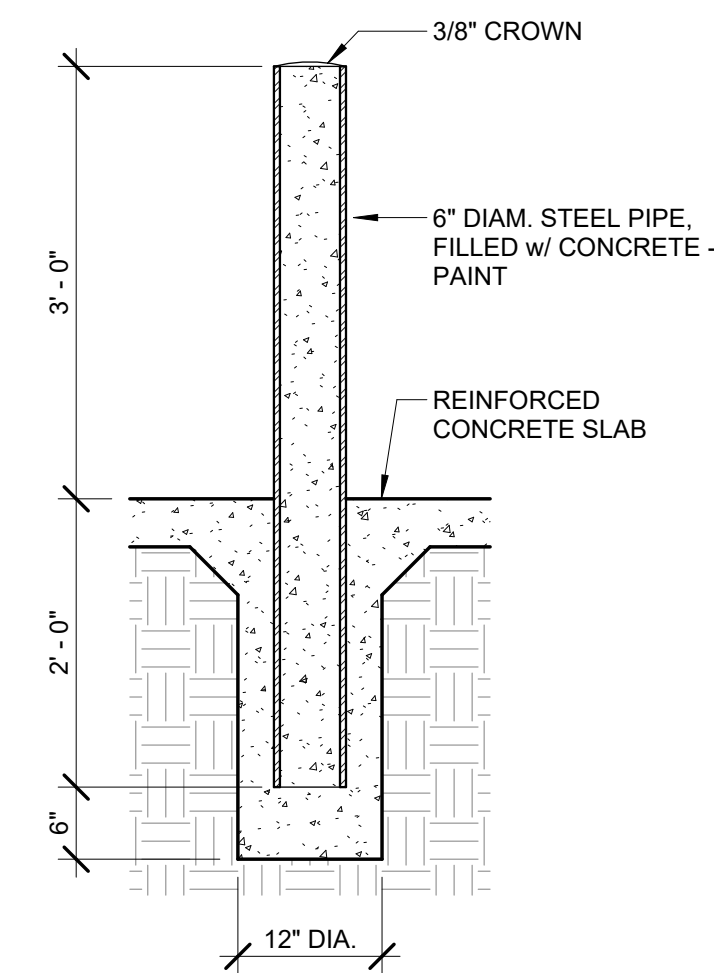


L BOLLARD
3/4" = 1'-0"

BASE BID- DOOR SCHEDULE


NO.	HDWR SET	SIZE		TYPE	THK	PANEL				FRAME			DETAILS			COMMENTS
		WIDTH	HEIGHT			MATERIAL	GLASS	FINISH	COLOR	MATERIAL	FINISH	COLOR	HEAD	JAMB	THD.	
101.1	1	3'-0"	7'-0"	(E)	RELOCATED H.M. DOOR	-	PAINT	P2	H.M.	PAINT	P2	A	B	PROVIDE (N) DOOR HARDWARE PER SPEC		

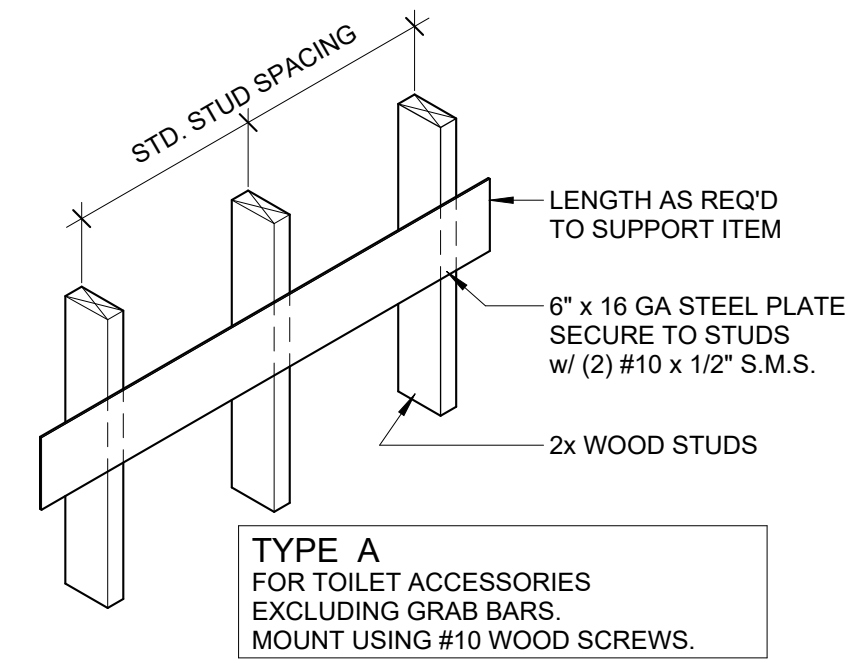

TYPE A
FOR TOILET ACCESSORIES EXCLUDING GRAB BARS. MOUNT USING #10 WOOD SCREWS.

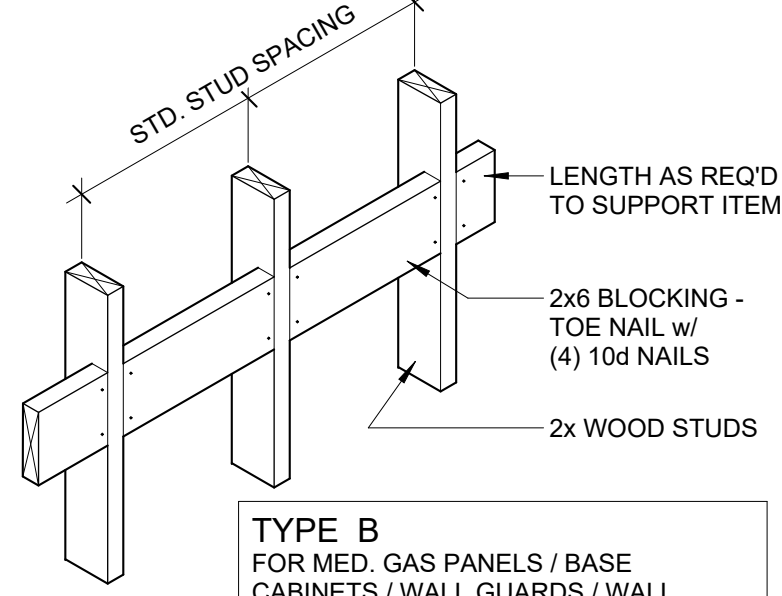


TYPE B
FOR MED. GAS PANELS / BASE CABINETS / WALL GUARDS / WALL HUNG CABINETS / WALL HUNG EQUIP. MOUNT USING #12 WOOD SCREWS.

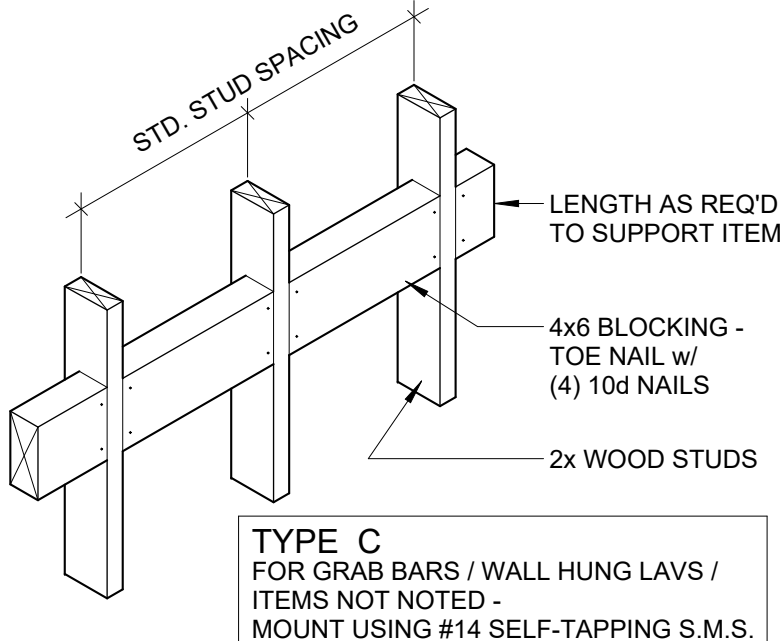


TYPE C
FOR GRAB BARS / WALL HUNG LAVS / ITEMS NOT NOTED - MOUNT USING #14 SELF-TAPPING S.M.S.


F TYP. BACKING PLATES
1/4" = 1'-0"

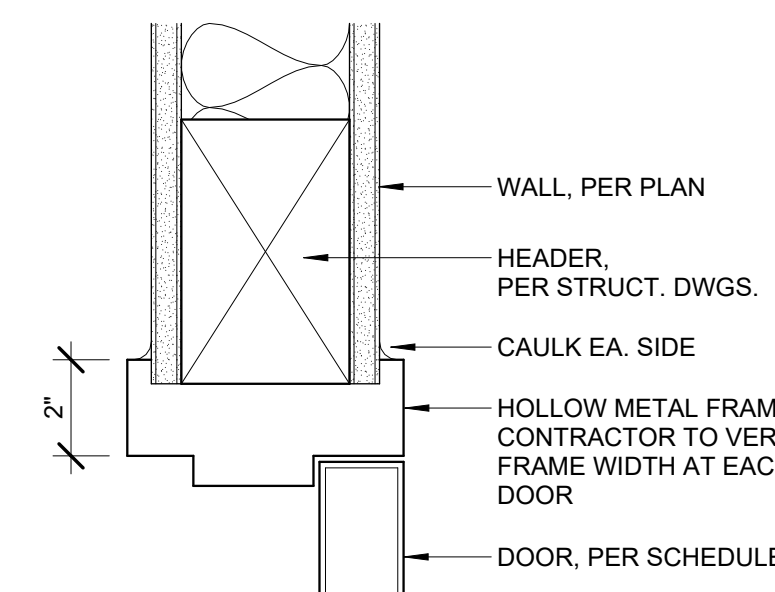


A INT. H.M. DOOR HEAD
3" = 1'-0"

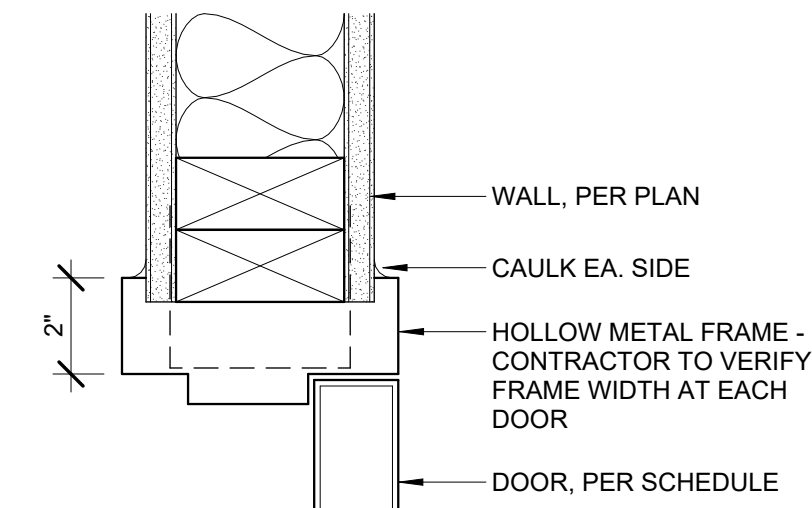

B INT. H.M. DOOR JAMB
3" = 1'-0"

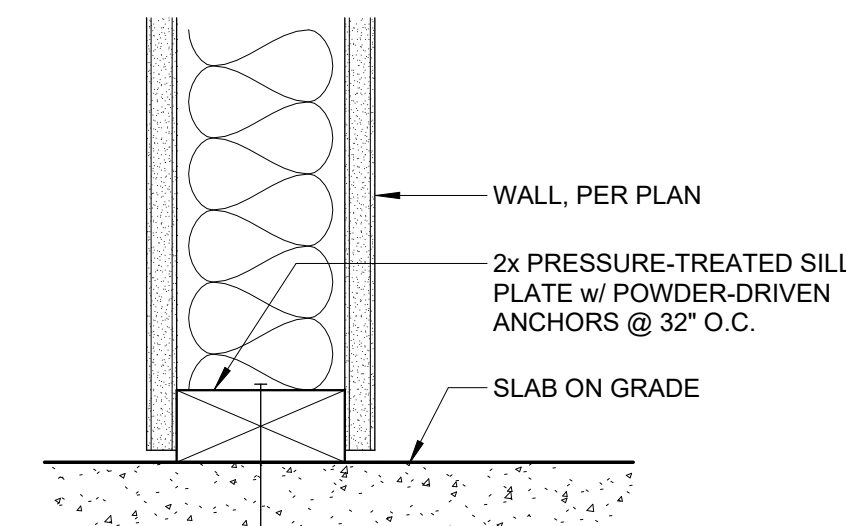

C WALL SILL PLATE
3" = 1'-0"

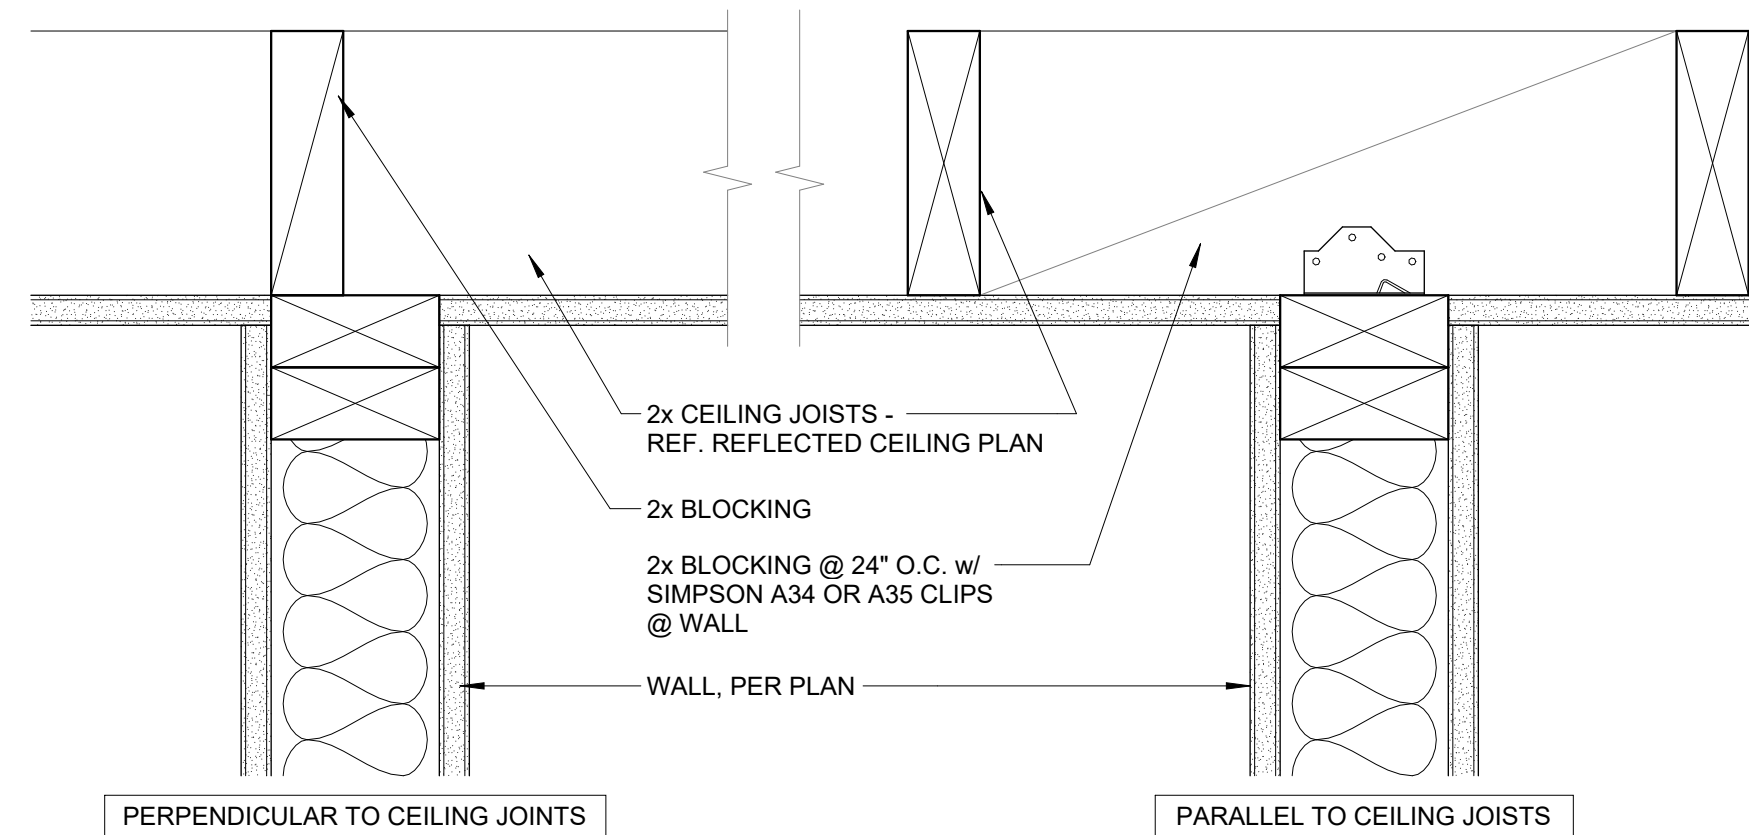

D WALL HEAD @ CEILING FRAMING
3" = 1'-0"

ROOM FINISH SCHEDULE


ROOM NO.	NAME	FINISHES				COMMENTS
		FLOOR	BASE	WALL	CEILING	
101	SCBA	SC1	B1	P1	P1	

FINISHES LEGEND

- FLOORING**
SC1 - SEALED CONCRETE- CLEAR SEAL
- BASE**
B1 - ROPPE RUBBER BASE, 4" COVE WITH TOE BROWN
- PAINT**
P1 - INTERIOR WALLS & CEILING MATCH (E) DUNN-EDWARDS
P2 - HOLLOW METAL DOORS AND FRAMES MATCH (E) DUNN-EDWARDS

GENERAL NOTES

- MAXIMUM VERTICAL OFFSET AT DOOR THRESHOLD SHALL BE 1/4" VERTICAL OR 1/2" IF BEVELED - REFER TO THRESHOLD DETAIL(S).
- ALL DOORS THAT ARE PART OF THE MEANS OF EGRESS SHALL BE EQUIPPED WITH HARDWARE THAT OPENS THE DOOR FROM THE INTERIOR WITHOUT SPECIAL KNOWLEDGE, EFFORT, OR A KEY.
- MAXIMUM DOOR OPENING EFFORT SHALL BE 5# AT NON-RATED DOORS AND 15# AT FIRE RATED DOORS.
- ALL FIRE RATED DOORS SHALL BE SELF-CLOSING, SELF-LATCHING, LISTED AND LABELED BY TESTING AGENCY, AND SHALL HAVE SMOKE SEALS. EXIT DEVICES ON FIRE RATED DOORS SHALL BE FIRE RATED WITHOUT DOGGING CAPABILITY.
- SEE SPECIFICATIONS FOR DOOR HARDWARE SETS AND PRODUCTS.
- ALL GLASS IN DOOR PANELS TO BE TEMPERED.
- ALL GLAZING MATERIAL IN FIRE RATED DOOR ASSEMBLIES SHALL BE TESTED IN ACCORDANCE WITH NFPA 257 OR UL 9, INCLUDING THE HOSE STREAM TEST (GLAZING IN 20-MINUTE FIRE DOOR ASSEMBLIES SHALL BE EXEMPT FROM THE HOSE STREAM TEST).
- REFER TO SHEET A8.1 FOR FINISH CODE LEGEND
- SCHEDULED DETAILS REFER TO DETAILS ON THIS SHEET U.O.N.
- OPERATING HARDWARE FOR LOCKSETS/LATCHSETS SHALL BE LEVER TYPE:

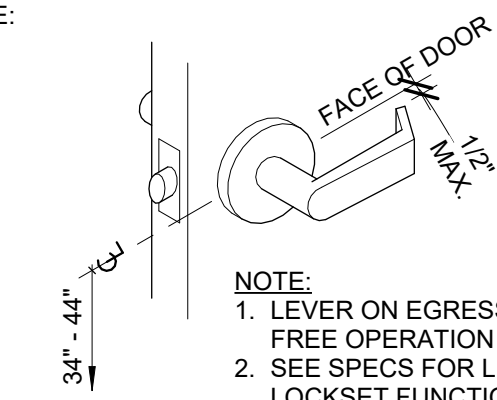

- NOTE:**
- LEVER ON EGRESS SIDE SHALL PROVIDE FREE OPERATION w/o USE OF KEY
 - SEE SPECS FOR LEVER TYPE AND LOCKSET FUNCTION
 - FORCE TO ACTIVATE OPERABLE PARTS SHALL BE 5 POUNDS MAX.

PRODUCT & MATERIAL REQUIREMENTS FOR INDOOR POLLUTANT CONTROL

- ALL MATERIALS, ADHESIVES, COATINGS, AND SEALANTS SHALL COMPLY WITH V.O.C. LIMITATIONS SET FORTH BY THE LOCAL AIR POLLUTION CONTROL DISTRICT OR CALIFORNIA CODE OF REGULATIONS TITLE 24, PART 11 (CALGREEN BUILDING STANDARDS), WHICHEVER IS MORE RESTRICTIVE.
- ALL CARPET MATERIALS SHALL MEET THE TESTING AND PRODUCT REQUIREMENTS OF THE CARPET & RUG INSTITUTE'S GREEN LABEL PLUS PROGRAM OR EQUIVALENT CRITERIA SET FORTH IN CALIFORNIA CALGREEN BUILDING STANDARDS.
- A MINIMUM OF 50% OF RESILIENT FLOORING SHALL COMPLY WITH THE V.O.C. EMISSION LIMITS DEFINED IN 2009 COLLABORATIVE FOR HIGH PERFORMANCE SCHOOLS (CHPS) CRITERIA AND LISTED ON ITS LOW-EMITTING MATERIALS LIST OR CERTIFIED UNDER THE RESILIENT FLOOR COVERING INSTITUTE FLOORSORE PROGRAM.
- ALL HARDWOOD COMPOSITE WOOD PRODUCTS (PLYWOOD, PARTICLEBOARD, AND MEDIUM DENSITY FIBERBOARD) SHALL MEET THE MAXIMUM FORMALDEHYDE EMISSIONS LIMITATIONS AS SPECIFIED IN ARB'S AIR TOXIC CONTROL MEASURE FOR COMPOSITE WOOD (17 COR 93120 ET SEQ.) BY THE DATES SPECIFIED IN THOSE SECTIONS.
- ARCHITECT HAS MADE EVERY REASONABLE ATTEMPT TO CONFIRM THAT PRODUCTS SPECIFIED IN THESE DOCUMENTS COMPLY WITH ABOVE-LISTED REQUIREMENTS. IT IS THE RESPONSIBILITY OF THE SUBCONTRACTOR, VENDOR, AND/OR MANUFACTURER TO NOTIFY THE ARCHITECT THROUGH THE GENERAL CONTRACTOR OF ANY NON-COMPLIANT PRODUCT OR MATERIAL SPECIFIED BY THE ARCHITECT PRIOR TO BID DUE DATE.
- CONTRACTOR SHALL PROVIDE PRODUCT/MATERIAL COMPLIANCE DOCUMENTATION WITH SUBMITTAL DOCUMENTS AS REQUIRED BY SPECIFICATION SECTION 013323. CONTRACTOR SHALL SUBMIT COMPLIANCE DOCUMENTATION TO THE JURISDICTION HAVING AUTHORITY UPON ACCEPTANCE BY ARCHITECT.



WMB ARCHITECTS

5757 Pacific Avenue
Suite 226
Stockton, CA 95207


2000 L Street
Suite 125
Sacramento, CA 95811

T 209.944.9110
F 209.944.5711
www.wmbarchitects.com

CITY PROJECT NO.
24-010
FIRE STATION NO. 31,
SCBA COMPRESSOR
ROOM

540 E MARSHALL ST.
TURLOCK, CA 95380

WMB Project No. 24-023

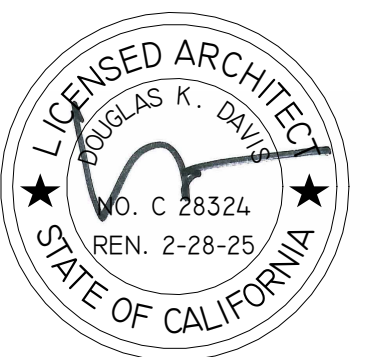

PUBLISH HISTORY:

DATE	PURPOSE
11.08.24	BLDG PERMIT APP
02.18.25	Plan Check #1

DOOR, FINISH SCHEDULE & DETAILS

A8.1



WMB ARCHITECTS

5757 Pacific Avenue Suite 226 Stockton, CA 95207


2000 L Street Suite 125 Sacramento, CA 95811

T 209.944.9110 F 209.944.5711 www.wmbarchitects.com

CITY PROJECT NO. 24-010 FIRE STATION NO. 31, SCBA COMPRESSOR ROOM

540 E MARSHALL ST. TURLOCK, CA 95380

WMB Project No. 24-023

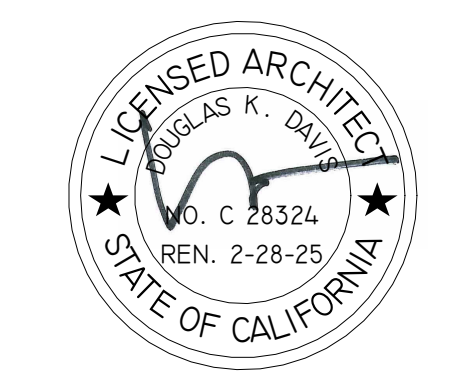

PUBLISHING HISTORY table with columns: DATE, PURPOSE. Includes 11.08.24 BLDG PERMIT APP and 02.18.25 Plan Check #1

SPECIFICATIONS

SS.1

01000 – GENERAL REQUIREMENTS

- SUMMARY: This Section describes general requirements that pertain to each Section of these Specifications.
COORDINATION OF DOCUMENTS: Documents affecting all Work in this contract and each Section of these Specifications include, but are not limited to, Sections in Division One of these Specifications, the General Conditions of the Contract and the Supplementary Conditions.

01230 - ALTERNATES

- SUMMARY: To compare total costs where alternate materials and methods might be used, alternatives have been established for the Work.
ALTERNATES: Refer to Drawing Title Sheet for Bid Alternates.

024119 – SELECTIVE DEMOLITION

- SUMMARY: Demolish and remove from the site those items so indicated on the Drawings.
GENERAL REQUIREMENTS: This Section shall be performed in accordance with the General Conditions, Supplementary Conditions and all Sections in Division 1 of these Specifications.

- DEMOLITION: Maintain services / systems indicated to remain and protect them against damage during selective demolition operations.
REPLACEMENT: In the event of demolition of items not so scheduled to be demolished, promptly replace such items to the approval of the Architect and at no additional cost to the Owner.

079200 – JOINT SEALANTS

- SUMMARY: Provide a positive barrier against penetration of air and moisture at joints between items where sealing is essential to continued integrity of the barrier.
AIR POLLUTANT CONTROL REQUIREMENTS: Per Section 5.504.4.1 of the 2013 California Green Building Standards Code (CALGreen), the project shall meet the requirements of the following standards.

081113 – HOLLOW METAL DOORS AND FRAMES

- SUMMARY: Provide and install hollow metal doors, frames, and frame components such as sidelites and borrowed lites as shown on the Drawings.
SUBMITTALS: Product Data: For each type of product indicated, include construction details, material descriptions, core descriptions, hardware reinforcements, profiles, anchors, fire-resistance rating, and finishes.

10. STANDARD HOLLOW METAL DOORS:

- General: Provide 1-3/4-inch doors of design indicated, not less than thickness indicated; fabricated with smooth surfaces, without visible joints or seams on exposed faces unless otherwise indicated.
Basis of Design: Flush panel; CECCO Legion Services Full Flush Door.

11. STANDARD HOLLOW METAL FRAMES:

- General: Comply with ANSISDI A250.8 and with details indicated for type and profile.
Exterior Frames: Fabricated of 16 gauge hot-dipped zinc coated steel that complies with ASTM A 653/A 653M.
Interior Frames: Fabricated from 16 gauge cold-rolled steel sheet that complies with ASTM A 1008/A 1008M.

12. FRAME ANCHORS:

- Jamb Anchors: Stud Wall Type: Designed to engage stud and not less than 0.042 inch thick.
Floor Anchors: Floor anchors to be provided at each jamb, formed from A60 metallic coated material, not less than 0.042 inches thick.

13. LOUVERS:

- Metal Louvers: Door manufacturer's standard metal louvers unless otherwise indicated.
Blade Type: Vision profile inverted V or inverted Y.

14. FABRICATION: Fabricate hollow metal work to be rigid and free of defects, warp, or buckle.

- Tolerances: Fabricate hollow metal work to tolerances indicated in ANSISDI A250.8.
Hollow Metal Doors: Exterior Doors: Provide optional weep-hole openings in bottom of exterior doors to permit moisture to escape where specified.

15. HARDWARE PREPARATION: Factory prepare hollow metal work to receive template mortised hardware;

- Prime Finishes: Doors and frames to be cleaned, and chemically treated to insure maximum finish paint adhesion.
Shop Primer: Manufacturer's standard, fast-curing, lead and chromate free primer complying with ANSISDI A250.10 acceptance criteria.

17. EXAMINATION: Examine substrates, areas, and conditions, with installer present, for compliance with requirements for installation of hollow metal work and framing.

- PREPARATION: Remove welded in shipping spreaders installed at factory. Restore exposed finish by grinding, filling, and dressing, as required to make repaired area smooth, flush, and invisible on exposed faces.
INSTALLATION: General: Install hollow metal work plumb, rigid, properly aligned, and securely fastened in place, comply with Drawings and manufacturer's written instructions.

- Hollow Metal Frames: Install hollow metal frames of size and profile indicated. Comply with ANSISDI A250.11 and NFPA 80 at fire rated openings.
Floor Anchors: Provide floor anchors for each jamb and mullion that extends to floor, and secure with post-installed expansion anchors.

20. ADJUSTMENT AND CLEANING:

- Final Adjustments: Check and readjust operating hardware items immediately before final inspection.
Prime-Coat and Painted Finish Touchup: Immediately after erection, sand smooth rusted or damaged areas of prime coat.

087100 – DOOR HARDWARE

- SUMMARY: This Section includes commercial door hardware for the following: Swinging Doors, Sliding Doors, Other doors to the extent indicated.
Product Data: Manufacturer's product data sheets including installation details, material descriptions, dimensions of individual components and profiles, operational descriptions and finishes.

4. COORDINATION:

- Templates: Obtain and distribute to the parties involved templates for doors, frames, and other work specified to be fabricated by the factory preparator and install hardware.
WARRANTY: Warranty Period: Written warranty, executed by manufacturer(s), agreeing to repair or replace components of standard and electrified door hardware that fails in materials or workmanship within specified warranty period.

6. MAINTENANCE SERVICE:

- Maintenance Tools and Instructions: Furnish a complete set of specialized tools and maintenance instructions as needed for Owner's continued adjustment, maintenance, and removal and replacement of door hardware.

7. SCHEDULED DOOR HARDWARE:

- General: Provide door hardware for each door to comply with requirements in Door Hardware Sets and each referenced section that products are to be supplied under.

- Designations: Requirements for quantity, item, size, finish or color, grade, function, and other distinctive qualities of each type of door hardware are indicated in the Door Hardware Sets at the end of Part 3.
Product designation and manufacturer are listed for each door hardware type required for the purpose of establishing requirements.

- Substitutions: Requests for substitution and product approval for inclusive mechanical and electromechanical door hardware in compliance with the specifications must be submitted in writing and in accordance with the procedures and time frames outlined in Division 01, Substitution Procedures.

8. HANGING DEVICES:

- Hinges: ANSIBHMA A156.1 certified butt hinges with number of hinge knuckles as specified in the Door Hardware Sets.



WMB ARCHITECTS

5757 Pacific Avenue
Suite 226
Stockton, CA 95207


2000 L Street
Suite 125
Sacramento, CA 95811

T 209.944.9110
F 209.944.5711
www.wmbarchitects.com

CITY PROJECT NO. 24-010 FIRE STATION NO. 31, SCBA COMPRESSOR ROOM

540 E MARSHALL ST.
TURLOCK, CA 95380

WMB Project No. 24-023

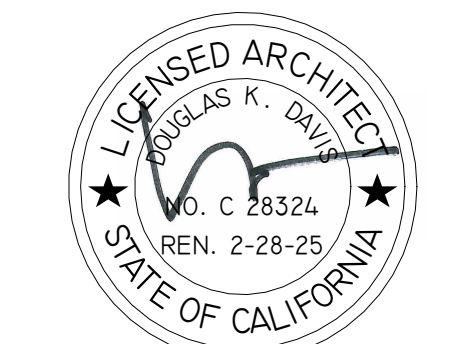

PUBLISH HISTORY:

DATE	PURPOSE
11.08.24	BLDG PERMIT APP
02.18.25	Plan Check #1

SPECIFICATIONS

SS.2

- d. Hinge Weight and Base Material: Unless otherwise indicated, provide the following: Exterior Doors: Heavy weight, non-ferrous, ball bearing or oil impregnated bearing hinges unless Hardware Sets indicate standard weight. Interior Doors: Standard weight, steel, ball bearing or oil impregnated bearing hinges unless Hardware Sets indicate heavy weight.
- e. Hinge Options: Comply with the following where indicated in the Hardware Sets or on Drawings: Non-removable Pins: Provide set screw in hinge barrel that, when tightened into a groove in hinge pin, prevents removal of pin while door is closed; for the following applications: Out-swinging exterior doors. Out-swinging access-controlled doors. Out-swinging lockable doors.
9. DOOR OPERATING TRIM.
- a. Flush Bolts and Surface Bolts: ANSI/BHMA A156.3 and A156.16, Grade 1, certified automatic, self-latching, and manual flush bolts and surface bolts. Manual flush bolts to be furnished with top rod of sufficient length to allow bolt location approximately six feet from the floor. Furnish dust proof strikes for bottom bolts. Surface bolts to be minimum 8" in length and U.L. listed for labeled fire doors and U.L. listed for windstorm components where applicable. Provide related accessories (mounting brackets, strikes, coordinators, etc.) as required for appropriate installation and operation.
- b. Coordinators: ANSI/BHMA A156.3 certified door coordinators consisting of active-leaf, hold-open lever and inactive-leaf release trigger. Coordinators fabricated from steel with nylon-coated strike plates and built-in adjustable safety release.
- c. Door Push Plates and Pulls: ANSI/BHMA A156.6 certified door pushes and pulls of type and design specified below or in the Hardware Sets. Coordinate and provide proper width and height as required where conflicting hardware dictates. Push/Pull Plates: Minimum .050-inch-thick, size as indicated in hardware sets, with square corners and beveled edges, secured with exposed screws unless otherwise indicated. Door Pull and Push Bar Design: Size, shape, and material as indicated in the hardware sets. Minimum clearance of 2 1/2-inches from face of door unless otherwise indicated. Offset Pull Design: Size, shape, and material as indicated in the hardware sets. Minimum clearance of 2 1/2-inches from face of door and offset of 90 degrees unless otherwise indicated. Fasteners: Provide manufacturer's designated fastener type as indicated in Hardware Sets.
10. CYLINDERS AND KEYING:
- a. Cylinders: Original manufacturer cylinders complying with the following: Mortise Type: Threaded cylinders with rings and straight- or clover-type cam. Rim Type: Cylinders with back plate, flat-type vertical or horizontal tailpiece, and raised trim ring. Bored Lock Type: Cylinders with tailpieces to suit locks. Mortise and rim cylinder collars to be solid and recessed to allow the cylinder face to be flush and be free spinning with matching finishes. Keyway: Manufacturer's Standard. Match Facility Standard. Match Facility Restricted Keyway.
- b. Permanent Cores: Manufacturer's standard, finish face to match lockset; complying with the following: Interchangeable Cores: Core insert, removable by use of a special key, usable with other manufacturers' cylinders.
- c. Keying System: Each type of lock and cylinders to be factory keyed. Conduct specified "Keying Conference" to define and document keying system and requirements. Furnish factory cut, nickel-silver large bow permanently inscribed with a visual key control number as directed by Owner. Incorporate decisions made in keying conference, and as follows: Master Key System: Cylinders are operated by a change key and a master key. Grand Master Key System: Cylinders are operated by a change key, a master key, and a grand master key. Great-Grand Master Key System: Cylinders are operated by a change key, a master key, a grand master key, and a great-grand master key. Existing System: Master key and grand master key locks to Owner's existing system. Keyed Alike: Key all cylinders to same change key.
- d. Key Quantity: Provide the following minimum number of keys: Top Master Key: One (1). Change Keys per Cylinder: Two (2). Master Keys (per Master Key Group): Two (2). Grand Master Keys (per Grand Master Key Group): Two (2). Construction Keys (where required): Ten (10). Construction Control Keys (where required): Two (2). Permanent Control Keys (where required): Two (2).
- e. Construction Keying: Provide construction master keyed cylinders or temporary keyed construction cores where specified. Provide construction master keys in quantity as required by project Contractor. Replace construction cores with permanent cores. Furnish permanent cores for installation as directed under specified "Keying Conference".
11. MECHANICAL LOCKS AND LATCHING DEVICES:
- a. Cylindrical Locksets, Grade 1 (Extra-Heavy Duty): ANSI 156.2 Series 4000, Grade 1 certified cylindrical (bored) locksets able to withstand 3000-inch pounds of torque applied to the locked lever without gaining access. Locksets to fit a standard 2 1/8" bore without the use of through-bolts. Lever handles to be made of solid material with no plastic fillers and latchbolt head to be one-piece stainless-steel construction encased within the lock body. Furnish with standard 2 3/4" backset, 1/2" throw latchbolt (3/4" at rated paired openings), and universal non-handed.
12. LOCK AND LATCH STRIKES:
- a. Strikes: Provide manufacturer's standard strike with strike box for each latch or lock bolt, with curved lip extended to protect frame, finished to match door hardware set, unless otherwise indicated, and as follows: Flat-Lip Strikes: For locks with three-piece anti-friction latchbolts, as recommended by manufacturer. Extra-Long-Lip Strikes: For locks used on frames with applied wood casing trim. Aluminum-Frame Strike Box: Provide manufacturer's special strike box fabricated for aluminum framing.
- b. Standards: Comply with the following: Strikes for Mortise Locks and Latches: BHMA A156.13. Strikes for Bored Locks and Latches: BHMA A156.2. Strikes for Auxiliary Deadlocks: BHMA A156.5. Dustproof Strikes: BHMA A156.16.
13. DOOR CLOSERS: All door closers specified herein shall meet or exceed the following criteria:
- a. General: Door closers to be from one manufacturer, matching in design and style, with the same type door preparations and templates regardless of application or spring size. Closers to be non-handed with full sized covers including installation and adjusting information on inside of cover.
- b. Standards: Closers to comply with UL-10C and UBC 7-2 for Positive Pressure Fire Test and be U.L. listed for use of fire rated doors.
- c. Cycle Testing: Provide closers which have surpassed 10 million cycles in a test witnessed and verified by UL.
- d. Size of Units: Comply with manufacturer's written recommendations for sizing of door closers depending on size of door, exposure to weather, and anticipated frequency of use. Where closers are indicated for doors required to be accessible to the physically handicapped, provide units complying with ANSI ICC/A117.1.
- e. Closer Arms: Provide heavy duty, forged steel closer arms unless otherwise indicated in Hardware Sets. Where closers are indicated to have mechanical dead-stop, provide heavy duty arms and brackets with an integral positive stop. Where closers are indicated to have mechanical hold open, provide heavy duty units with an additional built-in mechanical holder assembly designed to hold open against normal wind and traffic conditions. Holder to be manually selectable to on-off position. Where closers are indicated to have a cushion-type stop, provide heavy duty arms and brackets with spring stop mechanism to cushion door when opened to maximum degree. Closers shall not be installed on exterior or corridor side of doors, where possible install closers on door for optimum aesthetics. Provide drop plates or other accessories as required for proper mounting.
- f. Closer Accessories: Provide door closer accessories including custom templates, special mounting brackets, spacers and drop plates, and through-bolt or security type fasteners as specified in the door Hardware Sets.
- g. Door Closers, Surface Mounted (Commercial Duty): ANSI/BHMA 156.4, Grade 1 certified surface mounted, institutional grade door closers with complete spring power adjustment, sizes 1 thru 6, and fully operational adjustable according to door size, frequency of use, and opening force. Closers to be rack and pinion type, one-piece cast iron or aluminum alloy body construction, with adjustable backcheck, closing sweep, and latch speed control valves. Provide non-handed units standard.
14. ARCHITECTURAL TRIM: Door Protective Trim:
- a. General: Door protective trim units to be of type and design as specified below or in the Hardware Sets.
- b. Size: Fabricate protection plates (kick, armor, or mop) not more than 2" less than door width (LDW) on stop side of single doors and 1" LDW on stop side of pairs of doors, and not more than 1" less than door width on pull side. Coordinate and provide proper width and height as required where conflicting hardware dictates. Height to be as specified in the Hardware Sets. Metal Protection Plates: ANSI/BHMA A156.6 certified metal protection plates (kick, armor, or mop), beveled on four edges (B4E), fabricated from the following: Stainless Steel: .050-inch thick, with countersunk screw holes (CSK). Brass or Bronze: .050-inch thick, with countersunk screw holes (CSK). Laminated Plastic or Acrylic: 1/8-inch thick, with countersunk screw holes (CSK).
- c. Fasteners: Provide manufacturer's designated fastener type as specified in the Hardware Sets.
- d. Metal Door Edging: Door protection edging fabricated from a minimum .050-inch thick metal sheet, formed into an angle or "U" cap shape, surface or mortised mounted onto edge of door. Provide appropriate leg overlap to account for protection plates as required. Height to be as specified in the Hardware Sets.
15. DOOR STOPS AND HOLDERS:
- a. General: Door stops and holders to be of type and design as specified below or in the Hardware Sets.
- b. Door Stops and Bumpers: ANSI/BHMA A156.16, Grade 1 certified door stops and wall bumpers. Provide wall bumpers, either convex or concave types with anchorage as indicated, unless floor or other types of door stops are specified in Hardware Sets. Do not mount floor stops where they will impede traffic. Where floor or wall bumpers are not appropriate, provide overhead type stops and holders.
- c. Overhead Door Stops and Holders: ANSI/BHMA A156.6, Grade 1 certified overhead stops and holders to be surface or concealed types as indicated in Hardware Sets. Track, slide, arm and jamb bracket to be constructed of extruded bronze and shock absorber spring of heavy tempered steel. Provide non-handed design with mounting brackets as required for proper operation and function.
16. ARCHITECTURAL SEALS:
- a. General: Thresholds, weatherstripping, and gasket seals to be of type and design as specified below or in the Hardware Sets. Provide continuous weatherstrip gasketing on exterior doors and provide smoke, light, or sound gasketing on interior doors where indicated. At exterior applications provide non-corrosive fasteners and elsewhere where indicated.

Group:	01
Doors:	101.1
Scheduled Hardware:	
Hinges	
Kickplate	
Lockset (Function: Classroom)	
Silencers	

Group:	02
Doors:	101.2
Scheduled Hardware:	
Astragal	
Hinges	
Door Shoe	
Lockset (Function: Storeroom)	
Flush Bolts (Inactive Leaf)	
Threshold	
Weatherstripping	

092900 – GYPSUM BOARD

1. SUMMARY: Provide and install gypsum board where shown on the Drawings and as specified herein.
2. PANEL PRODUCTS: Provide in maximum lengths available to minimize end-to-end butt joints.
- a. Interior Gypsum Board: ASTM C 1396/ C 1396M, in thickness indicated, with manufacturer's standard edges.
3. ACCESSORIES:
- a. Metal Trim Accessories: ASTM C 1047, formed from galvanized or aluminum-coated steel sheet, rolled zinc, plastic, or paper-faced galvanized-steel sheet. For exterior trim, use accessories formed from hot-dip galvanized-steel sheet, plastic, or rolled zinc. Provide cornerbead at outside corners unless otherwise indicated. Provide LC-bead (J-bead) at exposed panel edges. Provide control joints where indicated.
- b. Joint-Treatment Materials: ASTM C 475/ C 475M.
- i. Joint Tape: Paper unless otherwise recommended by panel manufacturer.
- ii. Joint Compounds: Setting-type taping compound and drying-type, ready-mixed, compounds for topping.
- c. Fasteners: Screws complying with ASTM C954 or C1002.
- d. Adhesives: Liquid Nails Construction Adhesive by Macco Adhesives or equal, type as required for the material applied to.
- e. Other Materials: All other materials, not specifically described but required for a complete and proper installation of gypsum drywall, shall be as selected by the Contractor subject to approval of the Architect.
4. INSTALLATION: Install gypsum board panels in accordance with GA-216 and ASTM C840. Install all panels plumb, level, and with all vertical joints on bearing. Panels/patches smaller than 14 square inches may be cut without prior approval of Architect.
- a. Cutting: When cutting gypsum drywall is required, cut by scoring and breaking or by sawing, working from the face side. When cutting by scoring, cut through the face paper and then snap the panel back away from the cut face, then break the back paper by snapping the gypsum board in the reverse direction or by cutting the back paper. Smooth all cut ends and edges of panels as necessary to obtain a smooth joint. For cut-outs in panels for pipes, fixtures, and other small openings, make holes and cut-outs by sawing or by such other method as will not fracture the core or tear the covering and with such accuracy that plates, escutcheons, or trim will cover the edges. The use of "score-and-knockout" method will not be permitted.
- b. Fastening: Properly space all fasteners in careful accordance with the manufacturer's recommendations and code requirements, with heads driven slightly below the surface for proper cementing but without breaking the paper cover. Loosely butt all joints to be taped; firmly butt all joints to be left untreated. Stagger all end joints and the joints between panels to achieve a maximum of bridging and a minimum of continued joints.
- c. Ceiling: At those areas where gypsum drywall ceiling is indicated on the Drawings, and where it is possible to do so, install the ceiling prior to installing walls. Where possible, and where permitted by code, float the interior ceiling angles.
5. PATCH AND REPAIR: All patching shall be performed in accordance with ATSM C640.
- a. Where patching of existing gypsum board is required due to selective demolition identified as part of the scope of work, existing gypsum board shall be removed back to the nearest framing member or blocking, or additional framing/ blocking shall be installed so that any gypsum board patch is secured to framing at its perimeter.
- b. Patch shall be taped to adjacent existing gypsum board. Apply joint compound evenly, and sand smooth.
- c. Apply new texture to the entire wall or ceiling surface receiving a patch.
6. TAPING AND FINISHING: Match existing gypsum board finish.
7. CLEANING UP: Do not allow the accumulation of scraps and debris arising from the work of this Section but maintain the premises in a neat and orderly condition at all times; in the event of spilling or splashing compound onto other surfaces, immediately remove the spilled or splashed material and all trace of the residue to the approval of the Architect.

096513 – RESILIENT BASE AND ACCESSORIES

1. SUMMARY: Provide and install resilient base and accessories as shown on the Finish Schedule in the Drawings and specified herein.
2. ADDITIONAL STOCK: Deliver to Owner at least 10 linear feet, of each type and color of resilient wall base installed.
3. WALL BASE: Products: Mannington Commercial, BurkeBase Premium TS, Color and Pattern: See Drawings, ASTM F 1861, Type TS (rubber, vulcanized thermoset), Style: Cove (with top-set toe) 4 inches (101.6 mm) Lengths: Cut lengths 48 inches (1219.2 mm) long
4. INSTALLATION ACCESSORIES:
- a. Adhesives: Water-resistant type recommended by manufacturer to suit products and substrate conditions.
5. INSTALLATION: Adhesively install resilient wall base and accessories. Install wall base in maximum lengths possible. Apply to walls, columns, pilasters, casework, and other permanent fixtures in rooms or areas where base is required.

099100 – PAINTING AND COATING

1. SUMMARY: Provide painting as shown on the Finish Schedule in the Drawings and specified herein. The type of material to be used and the number of coats to be applied are listed in the "Painting Schedule" in Part 5.00 of this Section of these Specifications. The term "paint", as used herein, included enamels, epoxies, paints, sealers, fillers, emulsions, and other coatings, whether used as prime, intermediate, or finish coats.
2. INDOOR AIR POLLUTANT CONTROL REQUIREMENTS:
- a. VOC Limits: Architectural paints and coatings shall comply with VOC limits in Table 1 of the ARB Architectural Coatings Suggested Control Measure, as shown in Table 5.504.4.3 of the 2016 California Green Building Standards Code, unless more stringent local limits apply. The VOC content limit for coatings that do not meet the definitions for the specialty coatings categories listed in Table 5.504.4.3 shall be determined by classifying the coating as a Flat, Nonflat or Nonflat-High Gloss coating, based on its gloss, as defined in Subsections 4.21, 4.36 and 4.37 of the 2007 California Air Resources Board, Suggested Control Measure, and the corresponding Flat, Nonflat or Nonflat-High Gloss VOC limit in Table 5.504.4.3 shall apply.
- b. Aerosol Paints and Coatings: Aerosol paints and coatings shall meet the PWMIR Limits for ROC in Section 94522(a)(3) and other requirements, including prohibitions on use of certain toxic compounds and ozone depleting substances, in Sections 94522(c)(2) and (d)(2) of California Code of Regulations, Title 17, commencing with Section 94520, and in areas under the jurisdiction of the Bay Area Air Quality Management District additionally comply with the percent VOC by weight of product limits of Regulation 8 Rule 49.
3. MOCK-UPS: Mockups: Full-coat finish Sample of each type of coating, color, and substrate, applied where directed.
4. PROJECT CONDITIONS: The General Contractor is responsible to ensure all materials used in this Section meet current California V.O.C. (volatile organic compounds/chemicals) Regulations. The Architect shall be immediately notified of all V.O.C. conflicts. Work shall not proceed until conflicts are resolved.
5. EXTRA STOCK: Upon completion of this portion of the Work, deliver to the Owner an extra stock of one gallon of each color and gloss used in each coating material used, with all such extra stock tightly sealed in clearly labeled containers.
6. PAINT MATERIALS:
- a. Manufacturer: All paint materials selected for coating systems for each type of surface shall be the product of a single manufacturer. Paint materials listed herein, unless otherwise designated in the "Painting Schedule", are the product of Benjamin Moore and require no further approval as to manufacturer or catalog number. Equivalent products of other major paint manufacturers may be used subject to approval by the Architect of the materials list and manufacturers' recommendations required to be submitted under Article 1.03 above. Equivalent product manufacturers must provide a manufacturers product reference guide demonstrating the equivalence of the product substituted to the one specified.
- b. Compatibility: All paint materials and equipment shall be compatible in use; finish coats shall be compatible with prime coats; prime coats shall be compatible with the surface to be coated; all tools and equipment shall be compatible with the coating to be applied. Thinners, when used, shall be only those thinners recommended for that purpose by the manufacturer of the material to be thinned.
- c. Colors and glosses: All colors and glosses shall be indicated on the Painting Schedule and Finishes Schedule.
7. PREPARATION OF SURFACES, GENERAL: Prior to all surface preparation and painting operations, completely mask, remove or otherwise adequately protect all hardware, accessories, machined surfaces, plates, lighting fixtures, and similar items in contact with painted surfaces but not scheduled to receive paint. Spot prime all exposed nails and other metals which are to be painted with emulsion paints, using a primer recommended by the manufacturer of the coating system. Before applying paint or other surface treatment, thoroughly clean all surfaces involved. Schedule all cleaning and painting so that dust and other contaminants from the cleaning process will not fall on wet, newly painted surfaces.
8. PREPARATION OF METAL SURFACES:
- a. Galvanized metal: Clean all surfaces thoroughly with solvent until they are completely free from dirt, soil, and grease. Thoroughly treat the cleaned surface with phosphoric acid etch. Remove all excess etching solution and allow to dry completely before application of paint.
- b. Other metals: Thoroughly clean all surfaces until they are completely free from dirt, oil, grease and old paint. Allow to dry thoroughly before application of paint.
9. PAINT APPLICATION:
- a. General: Paint all surfaces, except glass, flat concrete, and similar items, not prefinished and not called out as unfinished. Paint all grilles and other prefinished items where the factory prefinish is not in accordance with the Painting Schedule and color selection or where a prefinished item is not the same color as the adjacent surface. Paint to match adjacent surface.



WMB ARCHITECTS

5757 Pacific Avenue
Suite 226
Stockton, CA 95207

2000 L Street
Suite 125
Sacramento, CA 95811

T 209.944.9110
F 209.944.5711
www.wmbarchitects.com

CITY PROJECT NO. 24-010 FIRE STATION NO. 31, SCBA COMPRESSOR ROOM

540 E MARSHALL ST.
TURLOCK, CA 95380

WMB Project No. 24-023



PUBLISH HISTORY

DATE PURPOSE
11/08/24 BLDG PERMIT APP
1 02/18/25 PLAN CHECK #1

Structural Notes

S0.0

General Notes:

- These drawings have been prepared using standards of professional care and completeness normally exercised under similar conditions by a reputable Engineer. They necessarily assume the work depicted will be performed by an experienced Contractor and/or workman who has a working knowledge of the applicable code, standards and requirements of industry acceptable standards of good installation/construction practices. As not every condition or detail is (or can be) explicitly shown on these drawings, it is understood that the Contractor will use acceptable industry standard good practice for all miscellaneous work not shown on the plans.
- Calculations and design of miscellaneous non-structural items, such as stairs, railings, non-structural walls and prefabricated items, such as roof trusses or floor trusses, are not included and are to be provided by others unless specifically noted on these drawings.
- These drawings represent the finished structure. They do not explain the method of construction. The Contractor shall be solely responsible for construction means, methods, techniques, sequences, schedule and procedures. It shall be the Contractor's responsibility to design and provide adequate shoring, bracing, form-work, etc. as required for the protection of life and property during construction. Visits to the site by the Engineer shall not include inspection of this item.
- During construction materials shall be uniformly spread out such that the design live load per square foot as stated herein is not exceeded. Visits to the site by the Engineer shall not include inspection of this item.
- The Contractor shall be responsible for all excavation procedures including shoring and protection of adjacent property, structures, streets and utilities in accordance with local building codes, the local building department and/or OSHA requirements.
- The Contractor shall be responsible for verification of all dimensions, conditions and elevations within architectural and/or structural drawings prior to the start of construction. The Contractor shall inform the Architect or Engineer in writing of any discrepancies or omissions noted on the drawings. Any such discrepancy, omission or variance not reported before the start of the construction shall be the responsibility of the Contractor. If discrepancies exist on these drawings, notes and details shall take precedence over the general notes.
- Where reference is made to codes or test standards for materials of construction, the latest edition and/or addendum adopted by the governing agency shall be used.
- Any options stated or drawn are for the Contractor's convenience. If the option is used the Contractor shall use the latest code, test standard or manufacturer's recommendations.
- Typical details and notes shall apply, though not necessarily indicated at a specific location on the drawings. Where no details are shown, construction shall conform to similar work on the project. Details may show only one side of the detail or may omit information for clarity.
- Verify and establish all openings, inserts or offsets for Architectural, Mechanical, Electrical or Plumbing, etc., with appropriate trades, drawings and Subcontractors prior to construction.
- All inspections required by the Codes, Local Building Department or the Plans shall be provided by an independent qualified inspection agency or the Building Department. Site visits by the Engineer do not constitute an inspection, unless specifically contacted for.
- Shop Drawings shall be submitted for all structural items upon written request or as detailed in Contract Documents. Shop drawings are reviewed only for general compliance with the structural drawings. Review does not indicate that the drawings are correct or complete. Responsibility shall rest with the Contractor. Any changes, substitutions, or deviations from the Contract Drawings shall be noted. Any of the aforementioned shall not be considered approved by the Engineer unless specially noted. The shop drawings do not supersede or replace the original Contract Drawings. Any engineering provided by others and submitted for review shall bear the seal of the appropriate Registered Engineer. JCVagner & Associates shall not be responsible for the adequacy of engineering designs performed by others. Allow 5 working days for the Engineer's review. One copy of each submittal shall be retained for Engineer's records.

Wood

- Sawn framing lumber shall comply w/ the latest edition of the grading rules of Western Wood Products Association or the West Coast Lumber Inspection Bureau. All sawn lumber shall be stamped with the grade mark of an approved lumber grading agency. Sawn lumber shall have the following minimum grade (UNO):

Size	Species & Grade
2x4 studs, blocking & top plates	Doug Fir-Larch, No. 2
2x6 studs, blocking & top plates	Doug Fir-Larch, No. 2
Joists and all other sawn lumber	Doug Fir-Larch, No. 1
4x posts	Doug Fir-Larch, No. 2
6x posts	Doug Fir-Larch, No. 2
- Glued-Laminated beams (GLB) shall be Douglas Fir-Larch Combination 24F-V4 at simple span beams and 24F-V8 at cantilever and multi-span beams. UNO, and shall have the minimum properties:
 $F_b = 2,400 \text{ psi}$ $F_v = 265 \text{ psi}$ $F_c[\text{Perpendicular}] = 650 \text{ psi}$ $E = 1,800 \text{ ksi}$

Fabrication and handling shall comply with the latest AISC and ASTM standards. Beams shall be manufactured with 2000' radius min. camber unless specifically noted on the plans. All laminations shall be 1-1/2" thick (min.).

Structural-use panels shall be performance rated by the American Plywood Association (APA). Panels shall comply with I.C.B.O. report No. NER-108, Exposure 1. Install per manufacturer recommendations. Structural-use panels shall conform to IBC standard 23-2 and 23-3. Plywood shall be five-ply sheathing lay up plywood with face grain perpendicular to supports. Plywood may be oriented per shearwall schedule. Oriented strand board (OSB) may be used as an alternate to plywood. Provide blocking at panel edges where indicated on plans. Panels shall conform to the following nominal thickness, span rating and nailing pattern unless noted otherwise:

Thickness	Grade/Materials	Use	Span Rating	Edge Nailing	Field Nailing
1/4"	rated sheathing	walls	-	6d @ 6" O.C.	6d @ 12" O.C.
3/8"	rated sheathing	walls	-	8d @ 6" O.C.	8d @ 12" O.C.
7/16"	rated sheathing	walls/roof	24/16	8d @ 6" O.C.	8d @ 12" O.C.
15/32"	rated sheathing	walls/roof	32/16	8d @ 6" O.C.	8d @ 12" O.C.
1/2"	rated sheathing	walls/roof	32/16	8d @ 6" O.C.	8d @ 12" O.C.
19/32"	rated sheathing	roof	40/20	10d @ 6" O.C.	10d @ 12" O.C.
5/8"	rated sheathing	roof	40/20	10d @ 6" O.C.	10d @ 12" O.C.
3/4" R	rated sheathing	roof	48/24	10d @ 6" O.C.	10d @ 12" O.C.
3/4" F	Structural I	floor	48/24	10d @ 6" O.C.	10d @ 12" O.C.

- Bottom plates resting on concrete or masonry shall be pressure treated douglas fir-larch sole plates and shall be anchored per structural details and shear wall schedule.
- All bolts shall be installed in holes bored with a bit 1/16" larger than the diameter of the bolt. Bolts and nuts seating on wood shall have washers as specified by the plans under the nut. Ding threads or install additional nut to prevent loosening of nuts. Lag bolts shall be installed in pre-drilled holes with wrench.
- All exterior wood for the vision screen shall be pressure treated. All sheathing shall be exterior grade.
- Any location calling out a 16d nail may be substituted for a #8 wood screw of the same length unless otherwise noted except for Simpson connections.
- All light framing connections shall be per CBC Table 2304.10.2 unless otherwise stated on the plans.

Concrete:

- Min. 28 day compressive strength 4000 psi
Max. Water to Cement Ratio 0.50
Concrete Slump 4'-6"
- Concrete mix designs shall be done by a certified laboratory and approved by the Engineer.
- All concrete shall be regular weight of 145-150 pounds per cubic foot using aggregates conforming to ASTM C33. Water shall be clean and potable.
- Portland Cement shall be Type II and conform to ASTM C150.
- No more than 90 minutes shall elapse between concrete batching and placement, unless approved by Engineer or Authorized Testing Agency.
- Concrete mixing, transport, & placement shall be per ACI 304. Mechanically vibrate all concrete as necessary when placed to achieve a uniform placement minimizing voids. Remove all debris from forms before placing concrete. Concrete shall not be allowed to be dropped through reinforcing steel or greater than 5 feet or any situation that may adversely affect the air entrainment or structural properties of the concrete. Care must be taken when placing slabs on grade as to not disturb the subgrade material.
- All items to be cast in concrete such as reinforcing steel, ducts, anchor bolts, dowels, pipes, sleeves, conduits, etc., shall be securely fastened to prevent movement during the concrete placement.
- Concrete slab on grade control joints shall be placed such that the enclosed area is less than 150 square feet (~12' x 12'), unless otherwise stated on plans or an approved mix design allowing greater enclosed area is approved.
- Pipes shall not be embedded in structural concrete unless stated on the plans or approved by the Engineer. Maximum pipe size shall be 1/3 of the slab thickness, located at mid-depth. Minimum spacing shall 3 times the pipe diameter. Pipes/sleeves shall not impair the strength of the member.
- Protect concrete from hot or cold weather conditions, which can reduce strength or damage concrete, in accordance with ACI 305 and 306.
- Anchor bolts for general use and at hold down locations shall be ASTM F1554 Gr. 36 bolts, with A563 Grade A heavy hex nuts & F436 Type I washers.

Special Inspections:

Special Inspection shall be performed by qualified firm independent of the Contractor, Architect, Engineer of Record or Owner according to 2022 CBC Chapter 17. The Special Inspector shall observe the below list of items for conformance with the Contract Documents. The Special Inspector shall send reports to the Owner and all applicable parties. All discrepancies shall be brought to attention of the Contractor for correction. The Special Inspector shall submit a final report stating that the special inspection work, to the best of his knowledge, was performed in compliance with the plans, specifications, Codes and applicable workmanship of the CBC. Special inspection shall be provided for the below list of items:

	Required Inspections	Periodic	Continuous
1.	Post-installed anchor bolts	✓	
2.	Epoxy anchors	✓	
3.	Placement of concrete reinforcement	✓	
4.	Concrete placement and strength testing		✓

Basis For Design

Governing Building Code: 2022 CBC											
Risk Category: IV											
Loading Information											
Gravity											
Roof		Ceiling		Floors		Storage and Egress					
D	Lr	D	Lr	D	L	Storage	Egress				
15 psf	20 psf	N/A	N/A	N/A	N/A	-	-				
Live loads reduced as permitted by building code											
Seismic											
Seismic Force Resisting System				Analysis Procedure		Seismic Coefficients					
Mech Components (Compressor/Condensator)				ASCE 7-16 Chapter 13		[Compressor]		[Condensator]			
Ss	SDS	S1	SD1	Site Class	Seismic Design Category	Rp	ap	Rp	ap		
0.667	0.563	0.265	0.366	D	D	2.5	1	6	2.5		
Wind											
Main Wind Force Resisting System				Component & Cladding (PSF)							
V	exposure	qz	GCp1	N/A	N/A	N/A	N/A				
104 mph	B	13 psf	N/A	N/A	N/A	N/A	N/A				
Deflection Limits:											
Wood Roof Elements: Trusses and Joists											
Total load: L/240											
Live Load: L/360											



WMB ARCHITECTS

5757 Pacific Avenue
Suite 226
Stockton, CA 95207

2000 L Street
Suite 125
Sacramento, CA 95811

T 209.944.9110
F 209.944.5711
www.wmbarchitects.com

CITY PROJECT NO.
24-010
FIRE STATION NO. 31,
SCBA COMPRESSOR
ROOM

540 E MARSHALL ST.
TURLOCK, CA 95380


WMB Project No. 24-023

PUBLISH HISTORY


No.	DATE	PURPOSE
1	11/08/24	BLDG PERMIT APP
1	02/18/25	PLAN CHECK #1

Equipment Anchorage Plan

S1.0

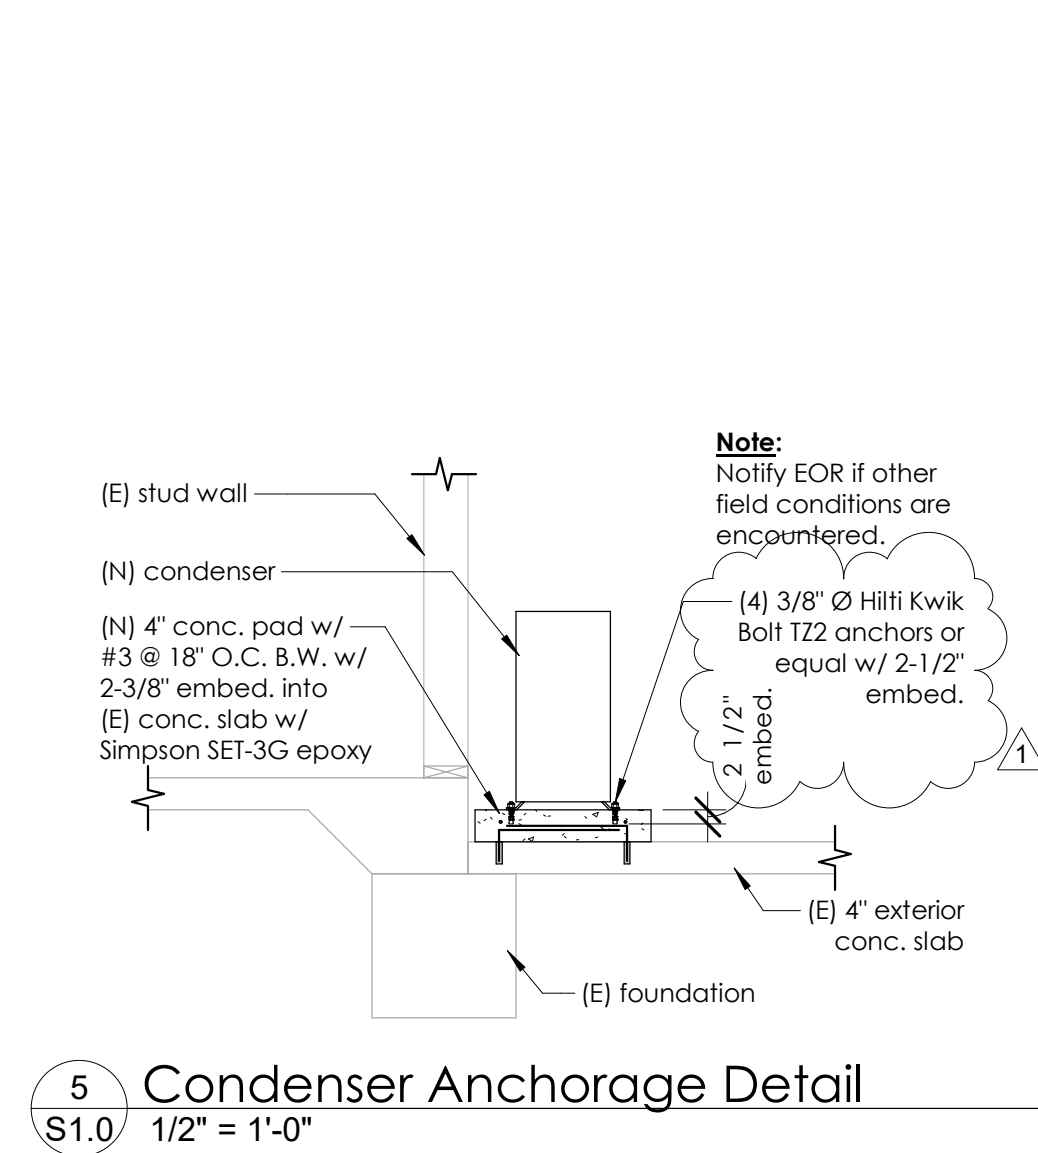


5 Condenser Anchorage Detail
S1.0 1/2" = 1'-0"

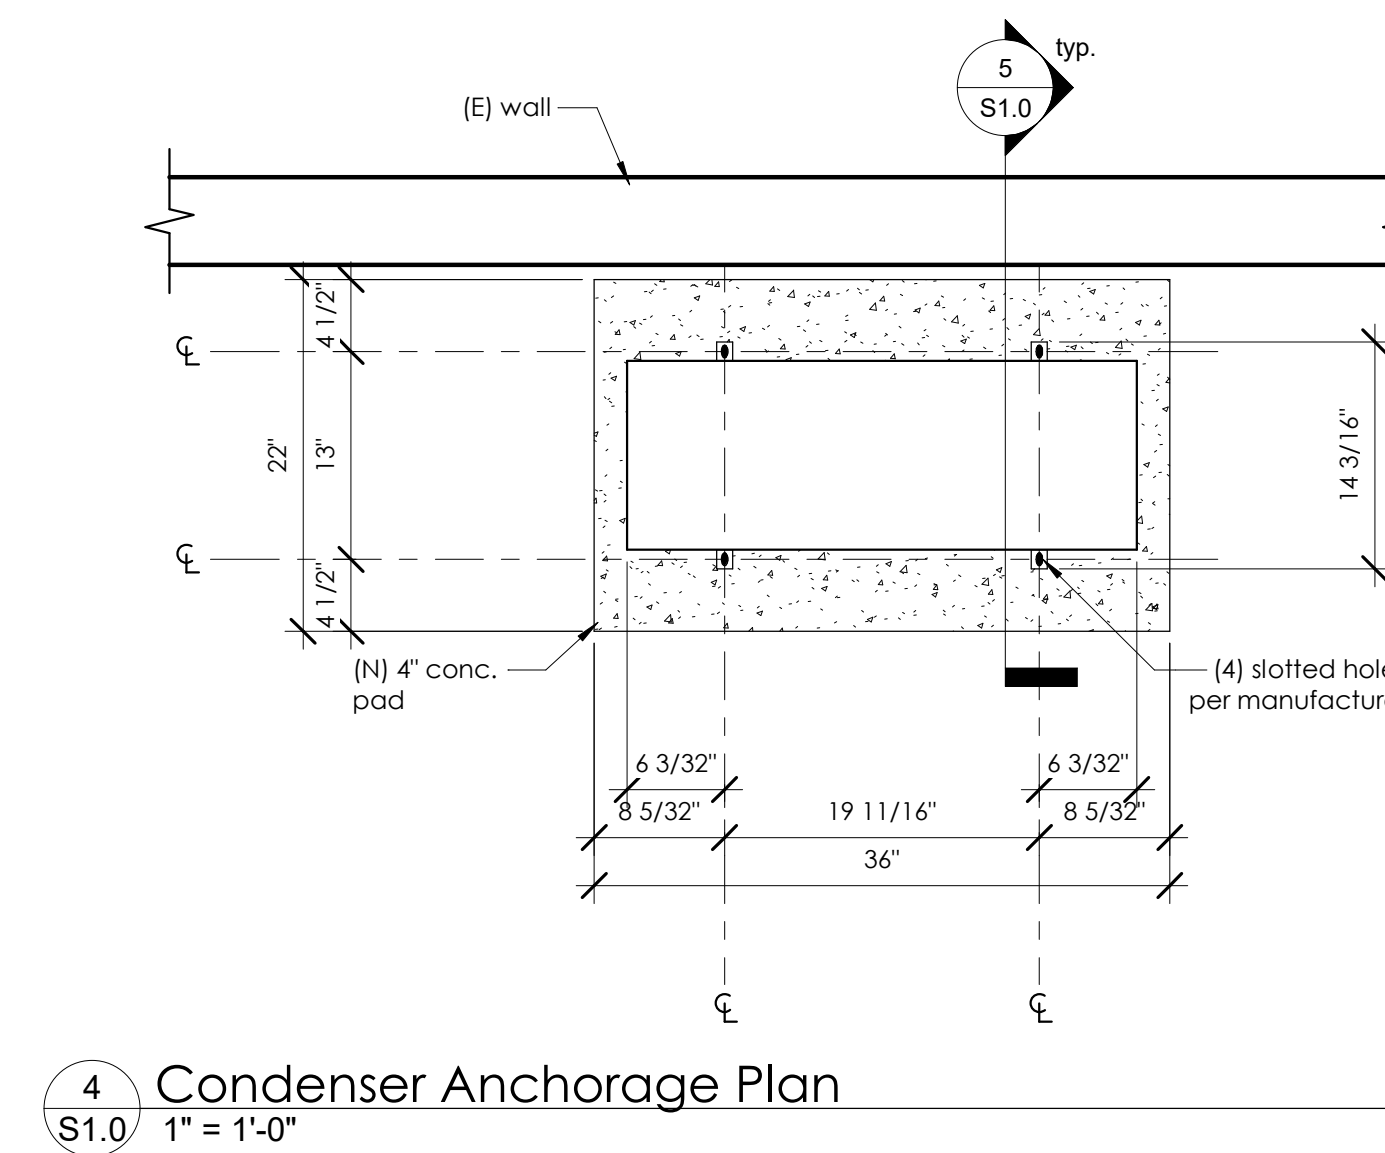


4 Condenser Anchorage Plan
S1.0 1" = 1'-0"



3 Compressor Anchorage Detail
S1.0 1/2" = 1'-0"

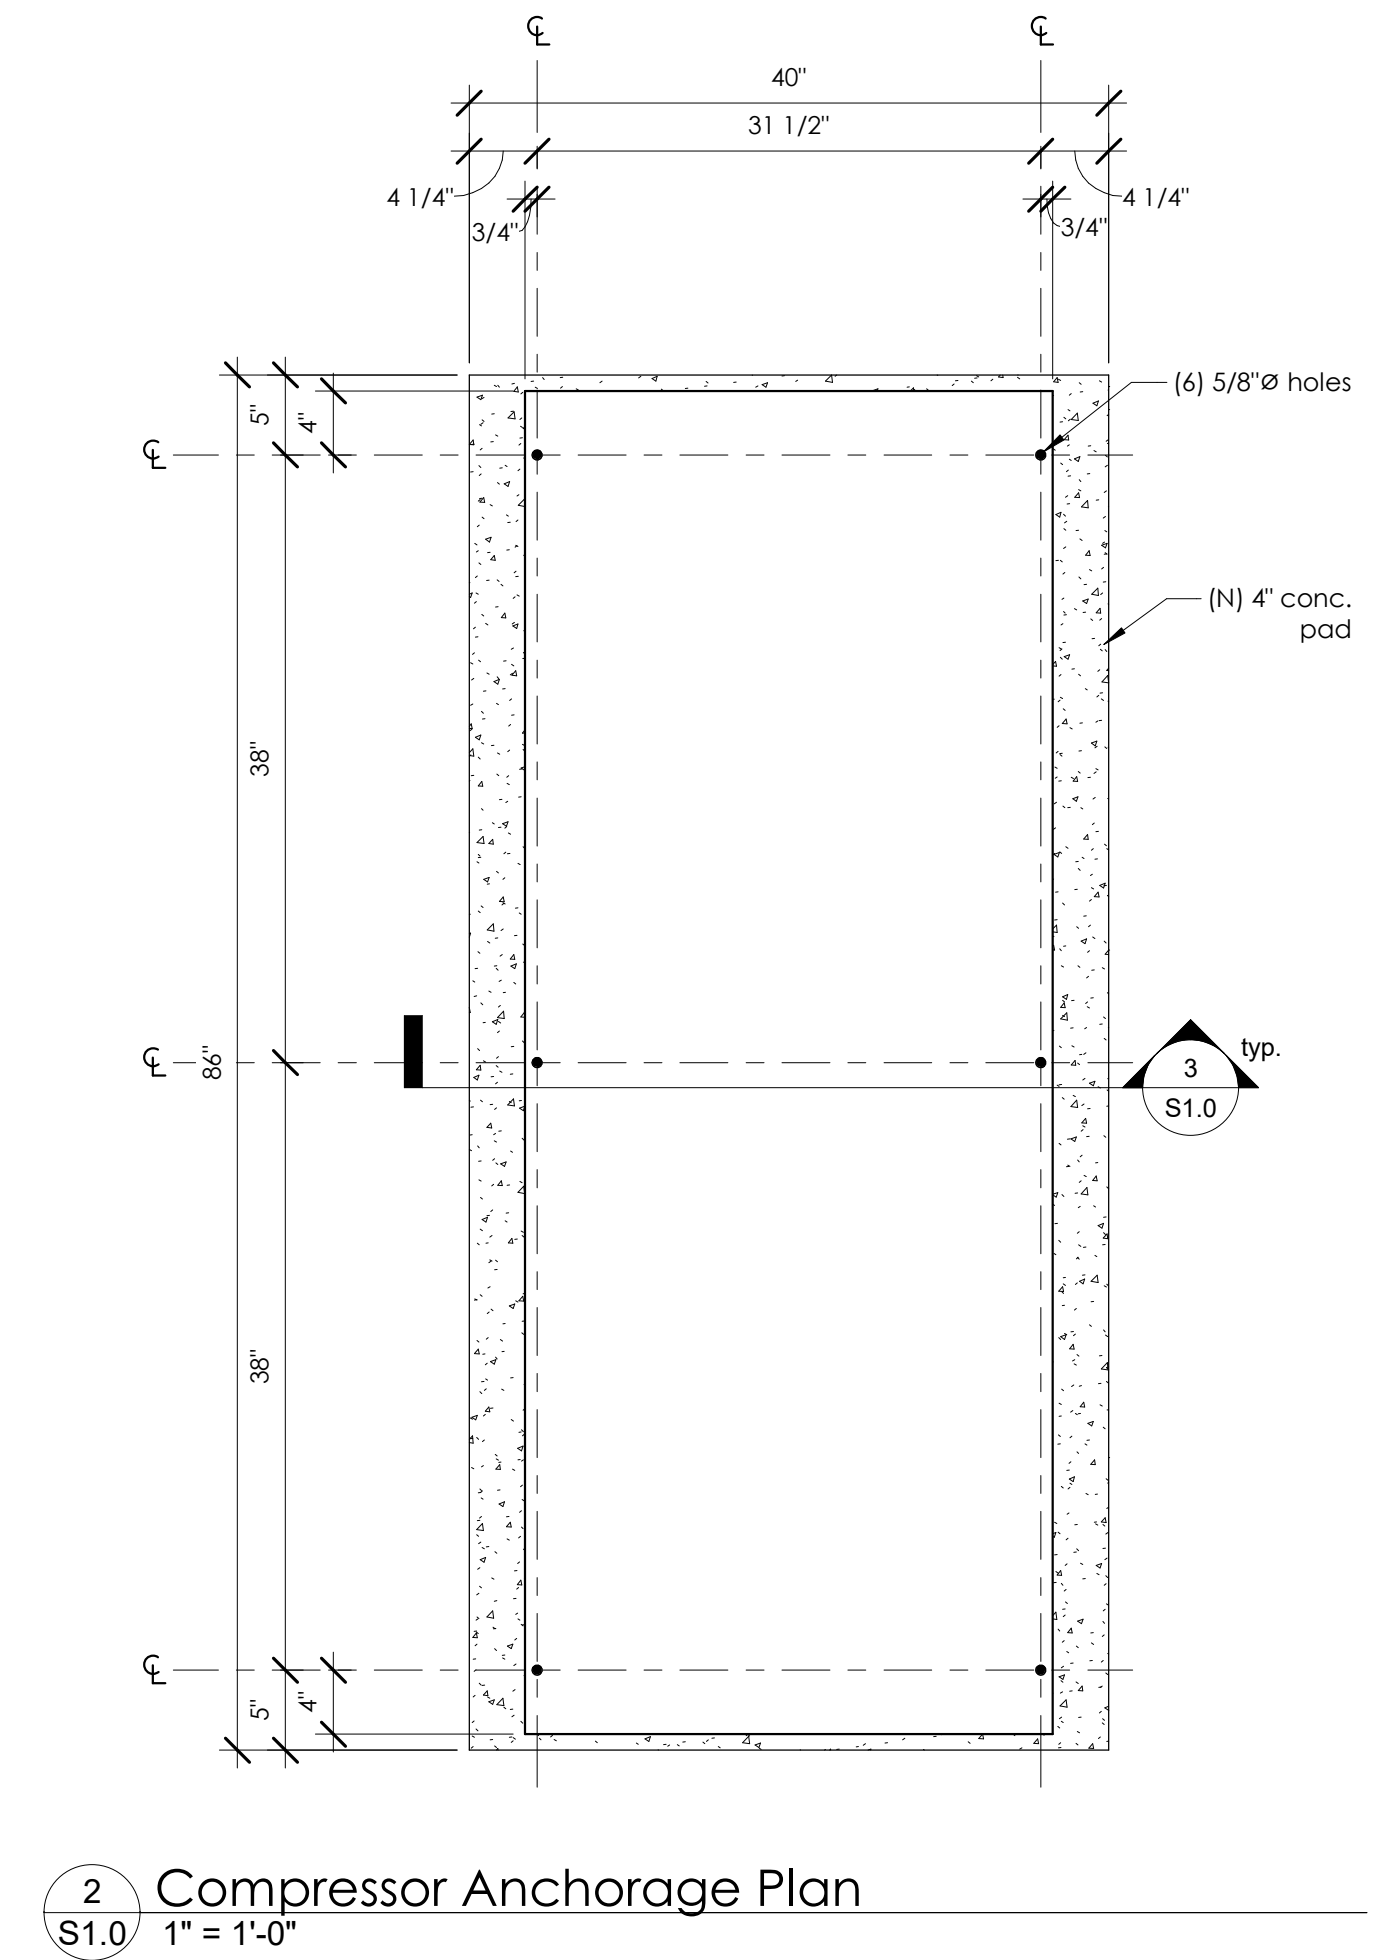

2 Compressor Anchorage Plan
S1.0 1" = 1'-0"

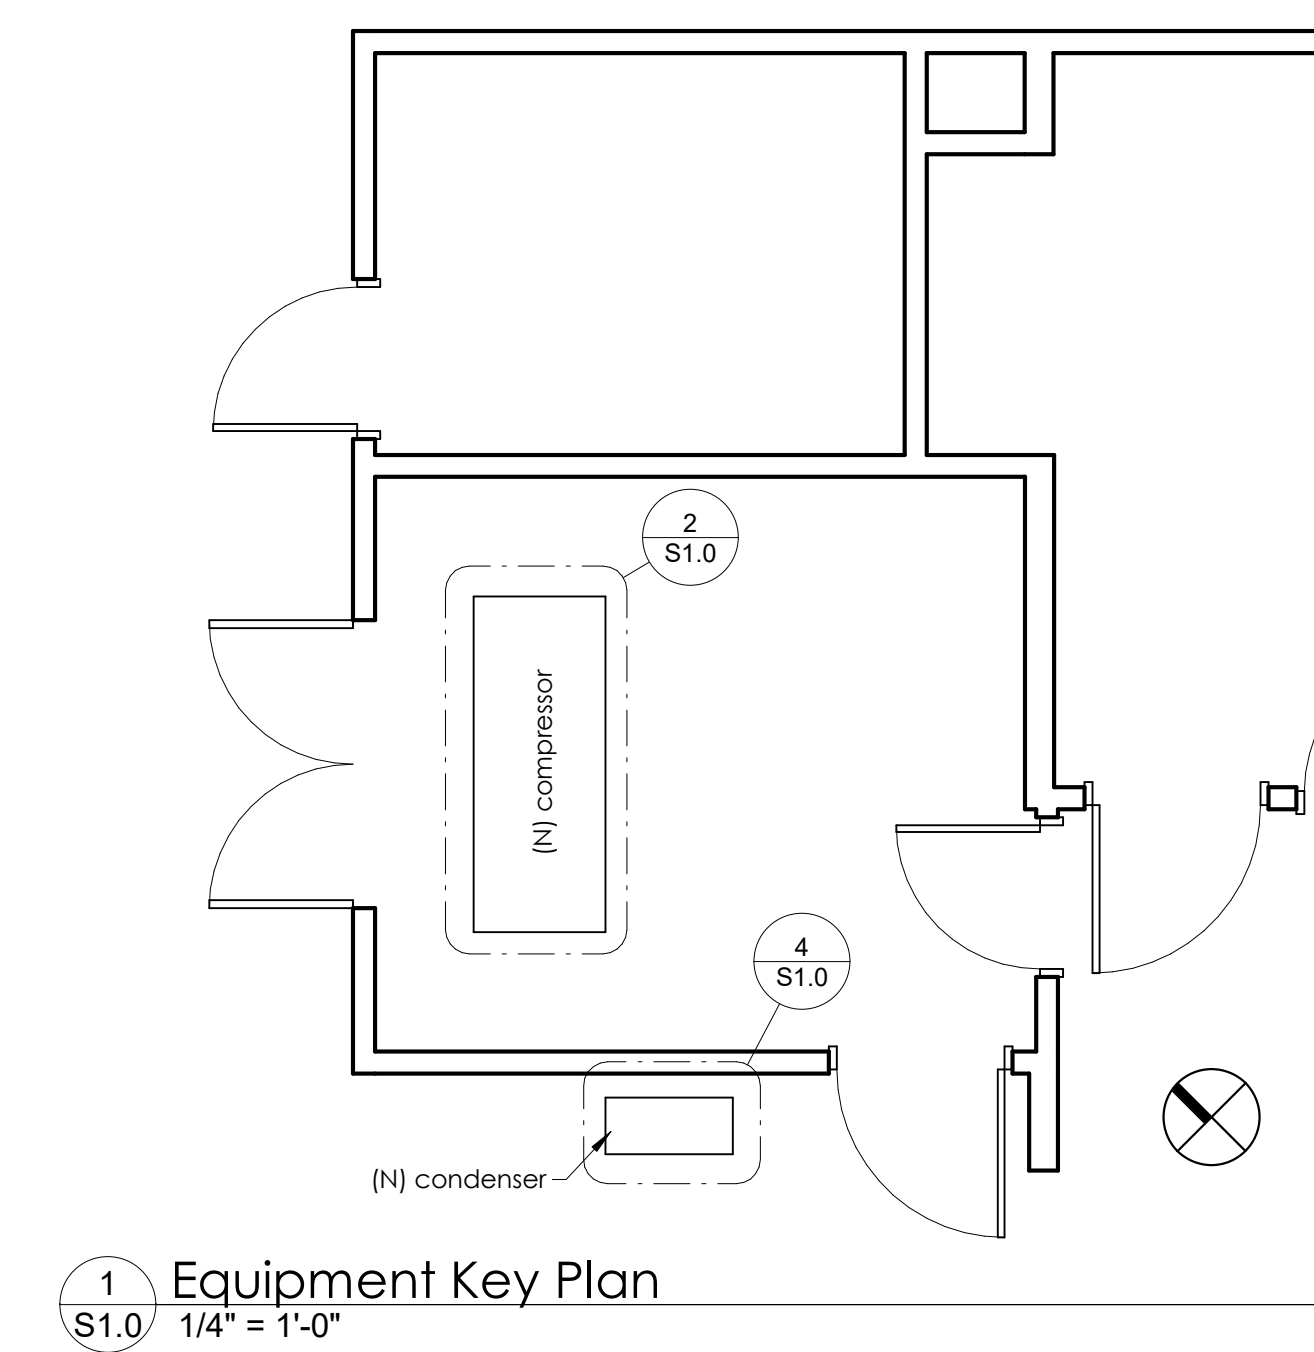

1 Equipment Key Plan
S1.0 1/4" = 1'-0"



WMB ARCHITECTS

5757 Pacific Avenue
Suite 226
Stockton, CA 95207

2000 L Street
Suite 125
Sacramento, CA 95811

T 209.944.9110
F 209.944.5711
www.wmbarchitects.com

CITY PROJECT NO.
24-010
FIRE STATION NO. 31,
SCBA COMPRESSOR
ROOM

540 E MARSHALL ST.
TURLOCK, CA 95380


WMB Project No. 24-023




PUBLISH HISTORY
DATE PURPOSE
11/08/24 BLDG PERMIT APP
1 02/18/25 PLAN CHECK #1

Shear Wall Plan


S2.0

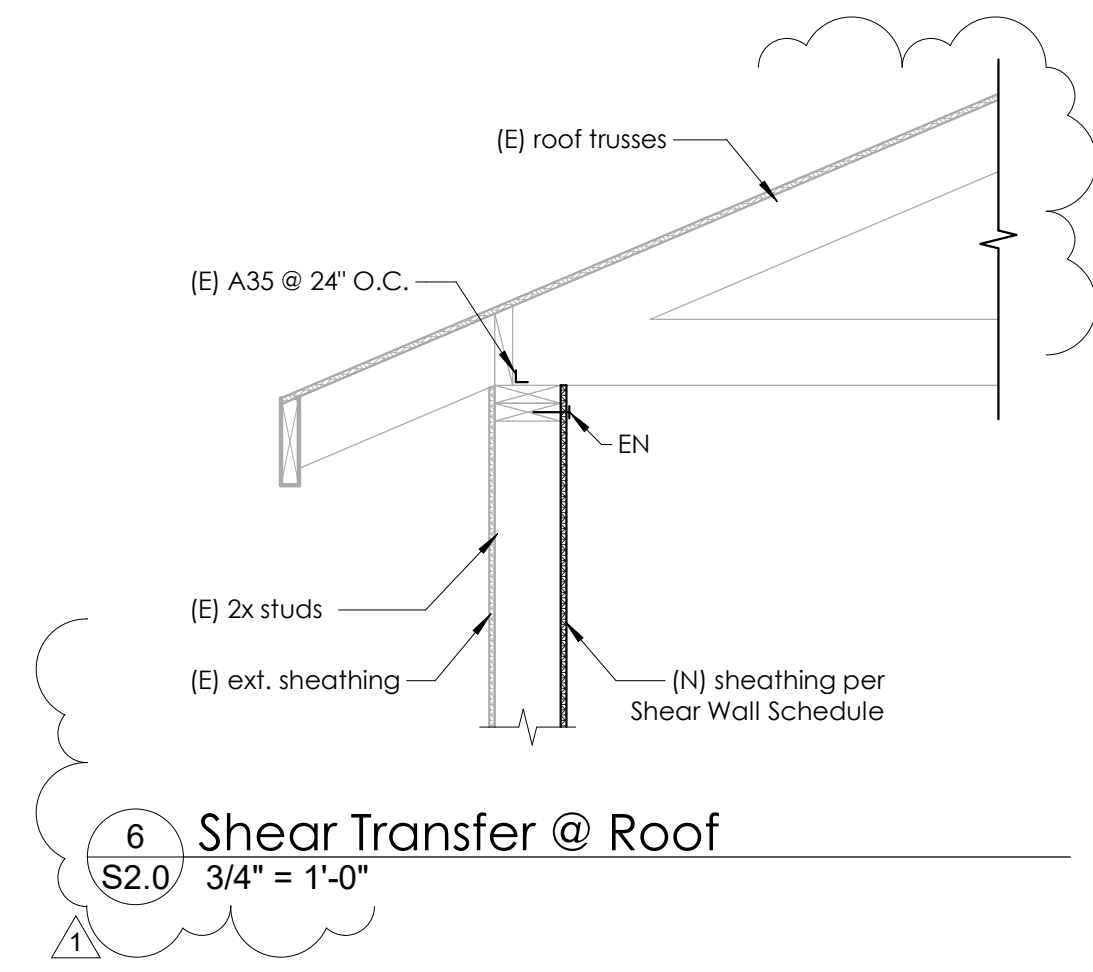

6 Shear Transfer @ Roof
S2.0 3/4" = 1'-0"

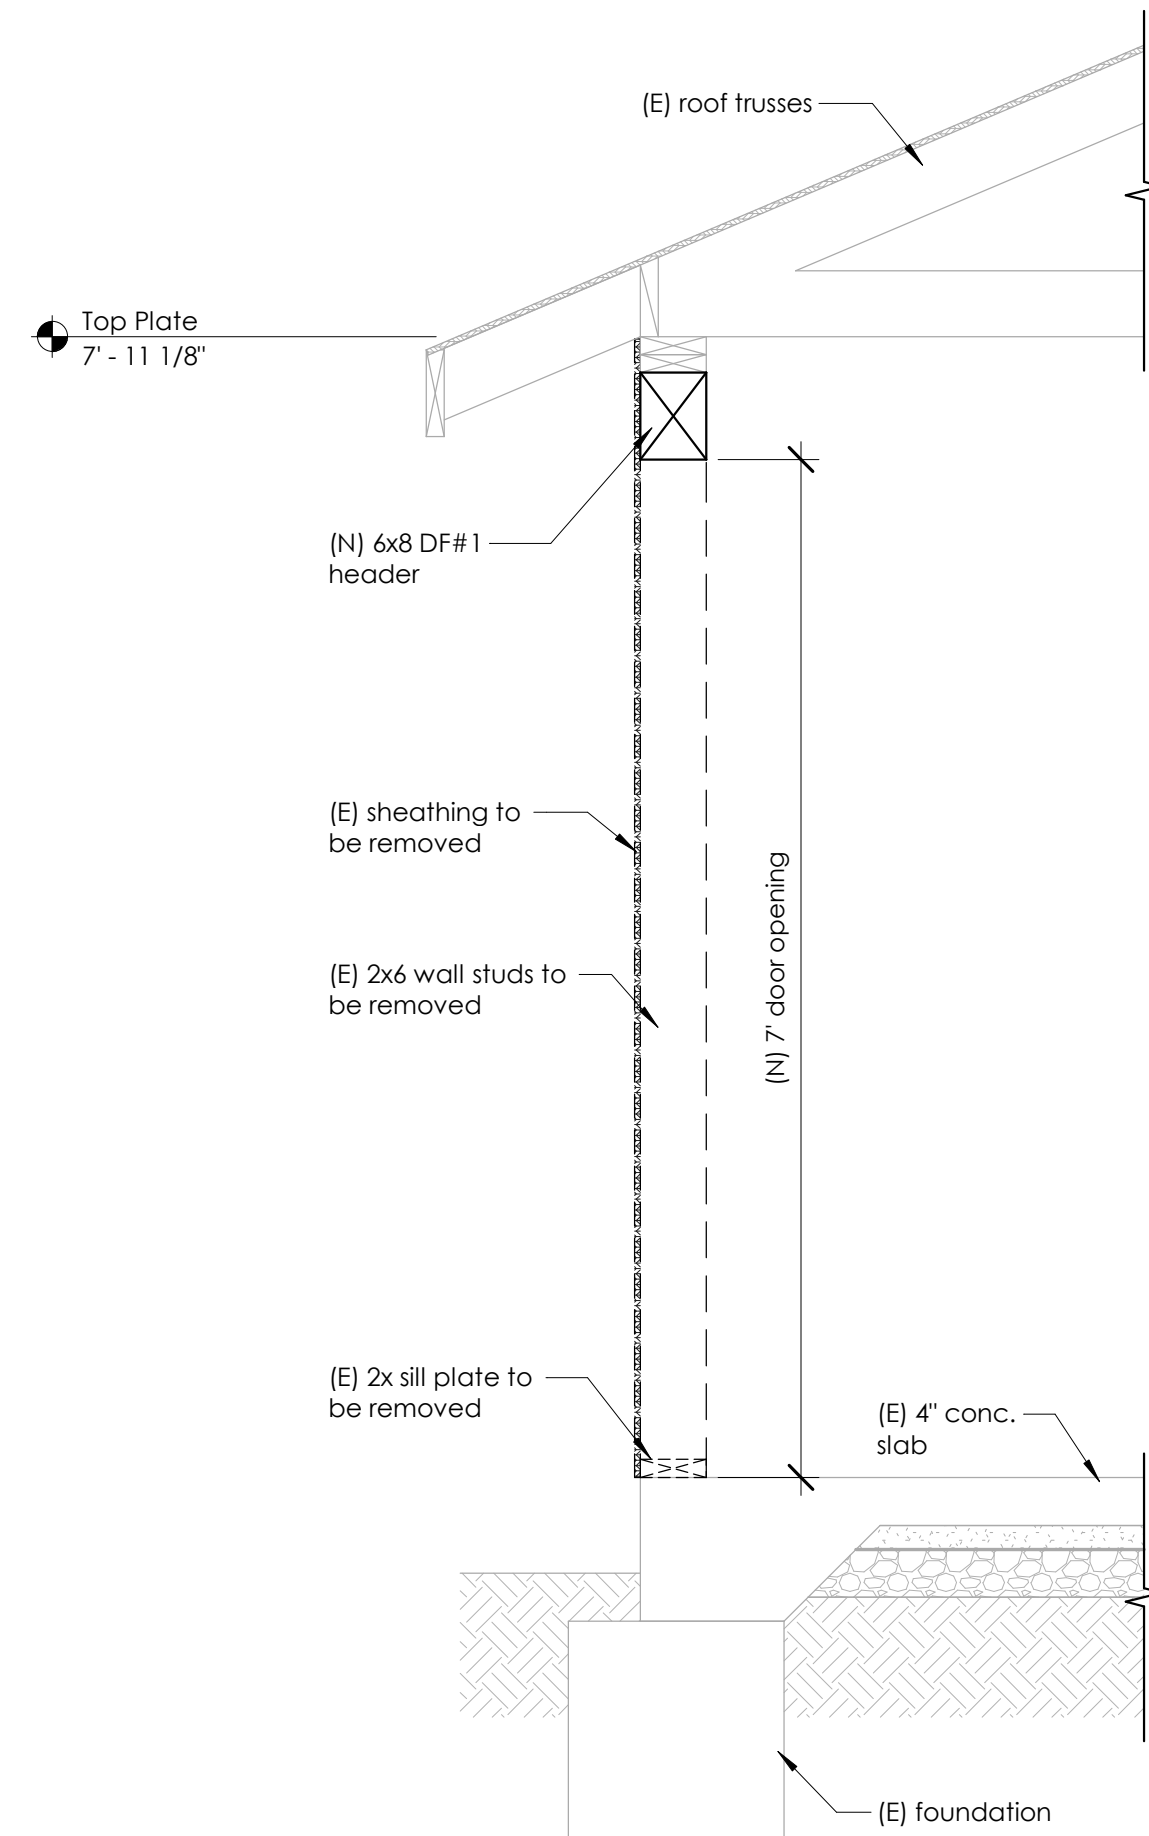

5 Exterior Wall Section @ (N) Door Opening - BID ALTERNATE #1
S2.0 3/4" = 1'-0"

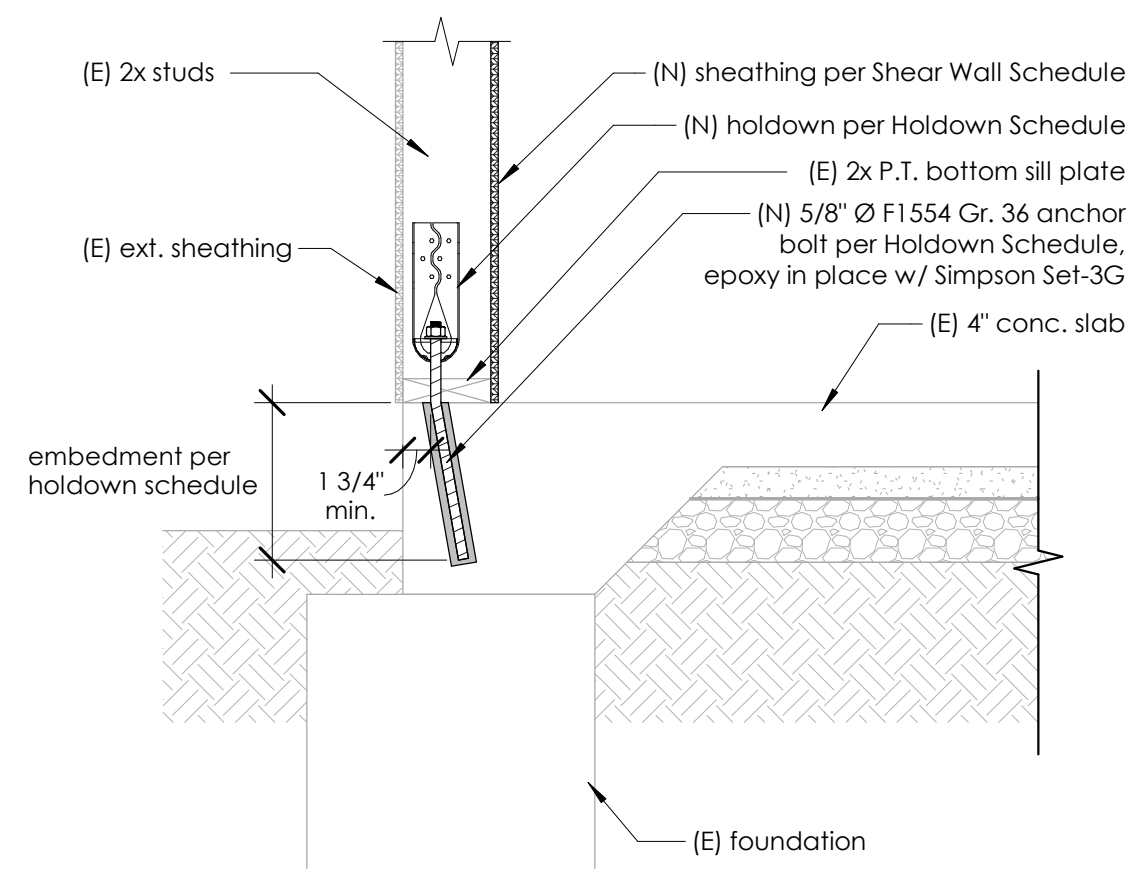

4 Post-Installed HD - BID ALTERNATE #1
S2.0 1" = 1'-0"

Shear Wall Schedule						
Type Mark	Panel Thickness	Nail/Screw Type	Min. Pen.	Nail Spacing (Field/Edge)	Shear Capacity ASD	Sill Anchorage/Anchor Bolts
A	15/32" OSB	10d	1-1/2"	12"/6"	310 plf	min (1) 5/8" x 10" AB in sill plate, if none exists - install (1) 5/8" Ø Strong-Bolt 2 w/ 10" embed. [ESR-3037]


Holdown Schedule					
	Post Size	Allowable Tension Load (ASD)	Min. Embed. Depth	Function	Comments
2	6x	3075 lb	12-5/8"	Exterior	Wood Fasteners: (4) 1/4" x 2-1/2" SDS Anchor Bolt Diameter: SET-3G w/ 5/8" Ø F1554 Gr. 36 AB w/ 10" min. embed. [ESR-4057]

Shear Wall Legend


- 2x shear wall w/ min. 15/32" sheathing
- (E) 2x shear wall to be removed
- Align

Notes:


1. All dimensions are approx. VIF all dimensions as necessary.

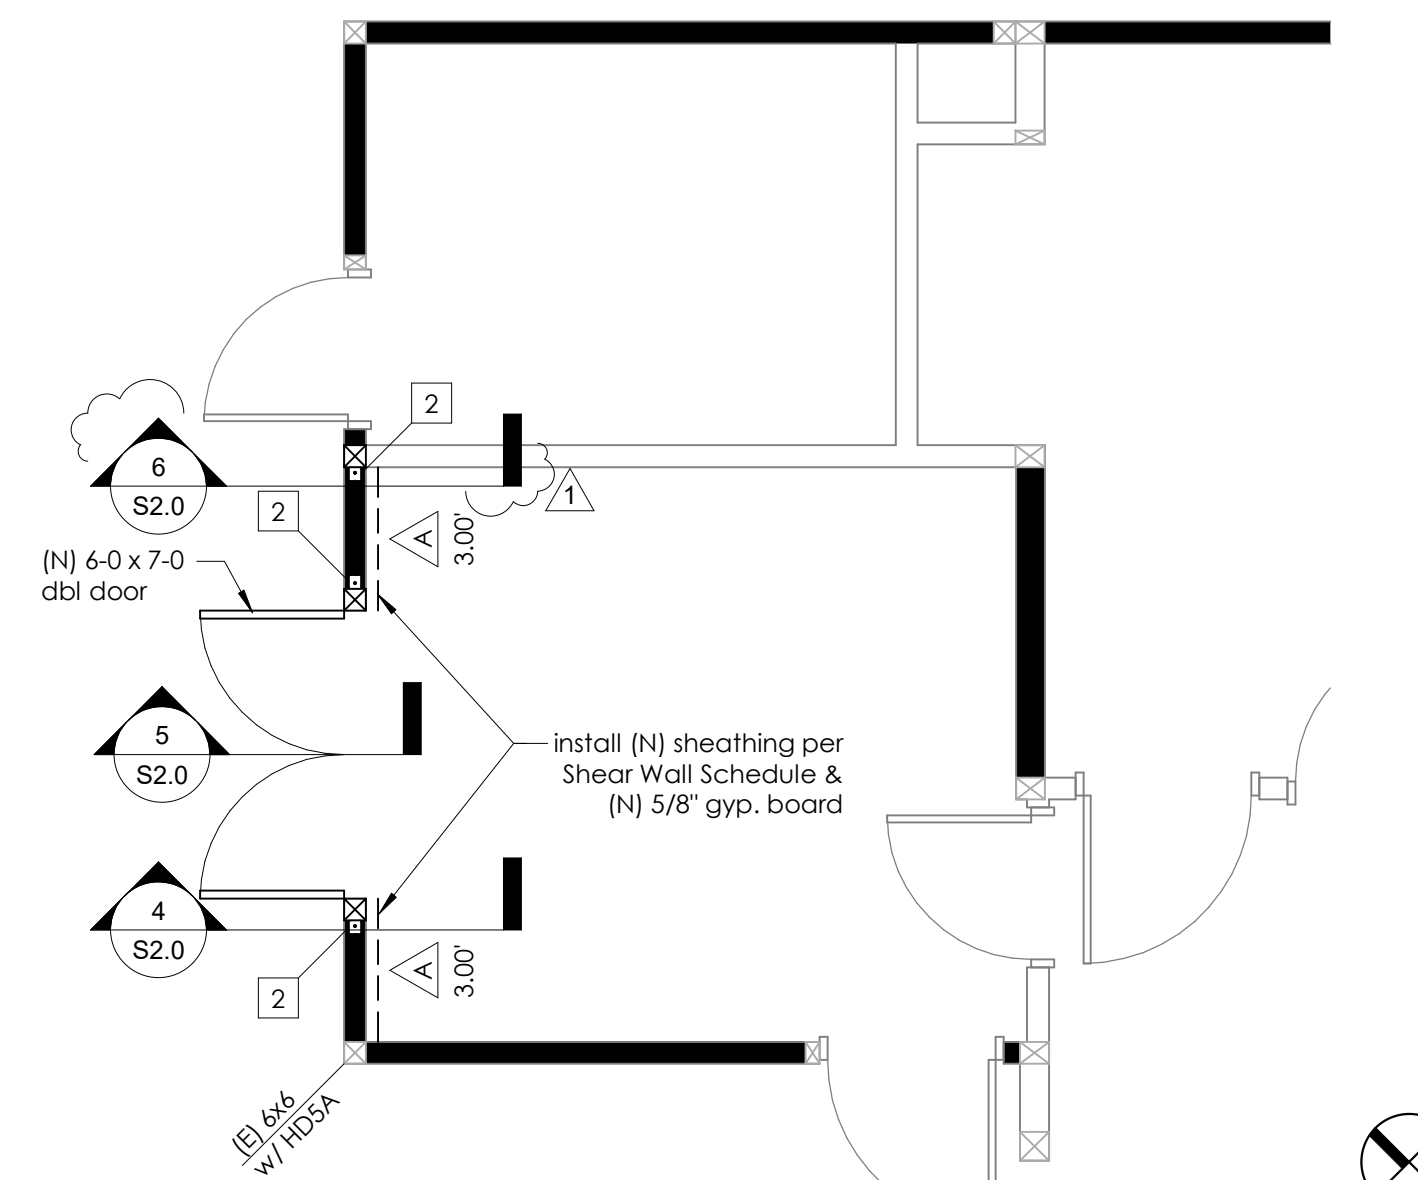

3 (N) Shear Wall Plan - BID ALTERNATE #1
S2.0 1/4" = 1'-0"

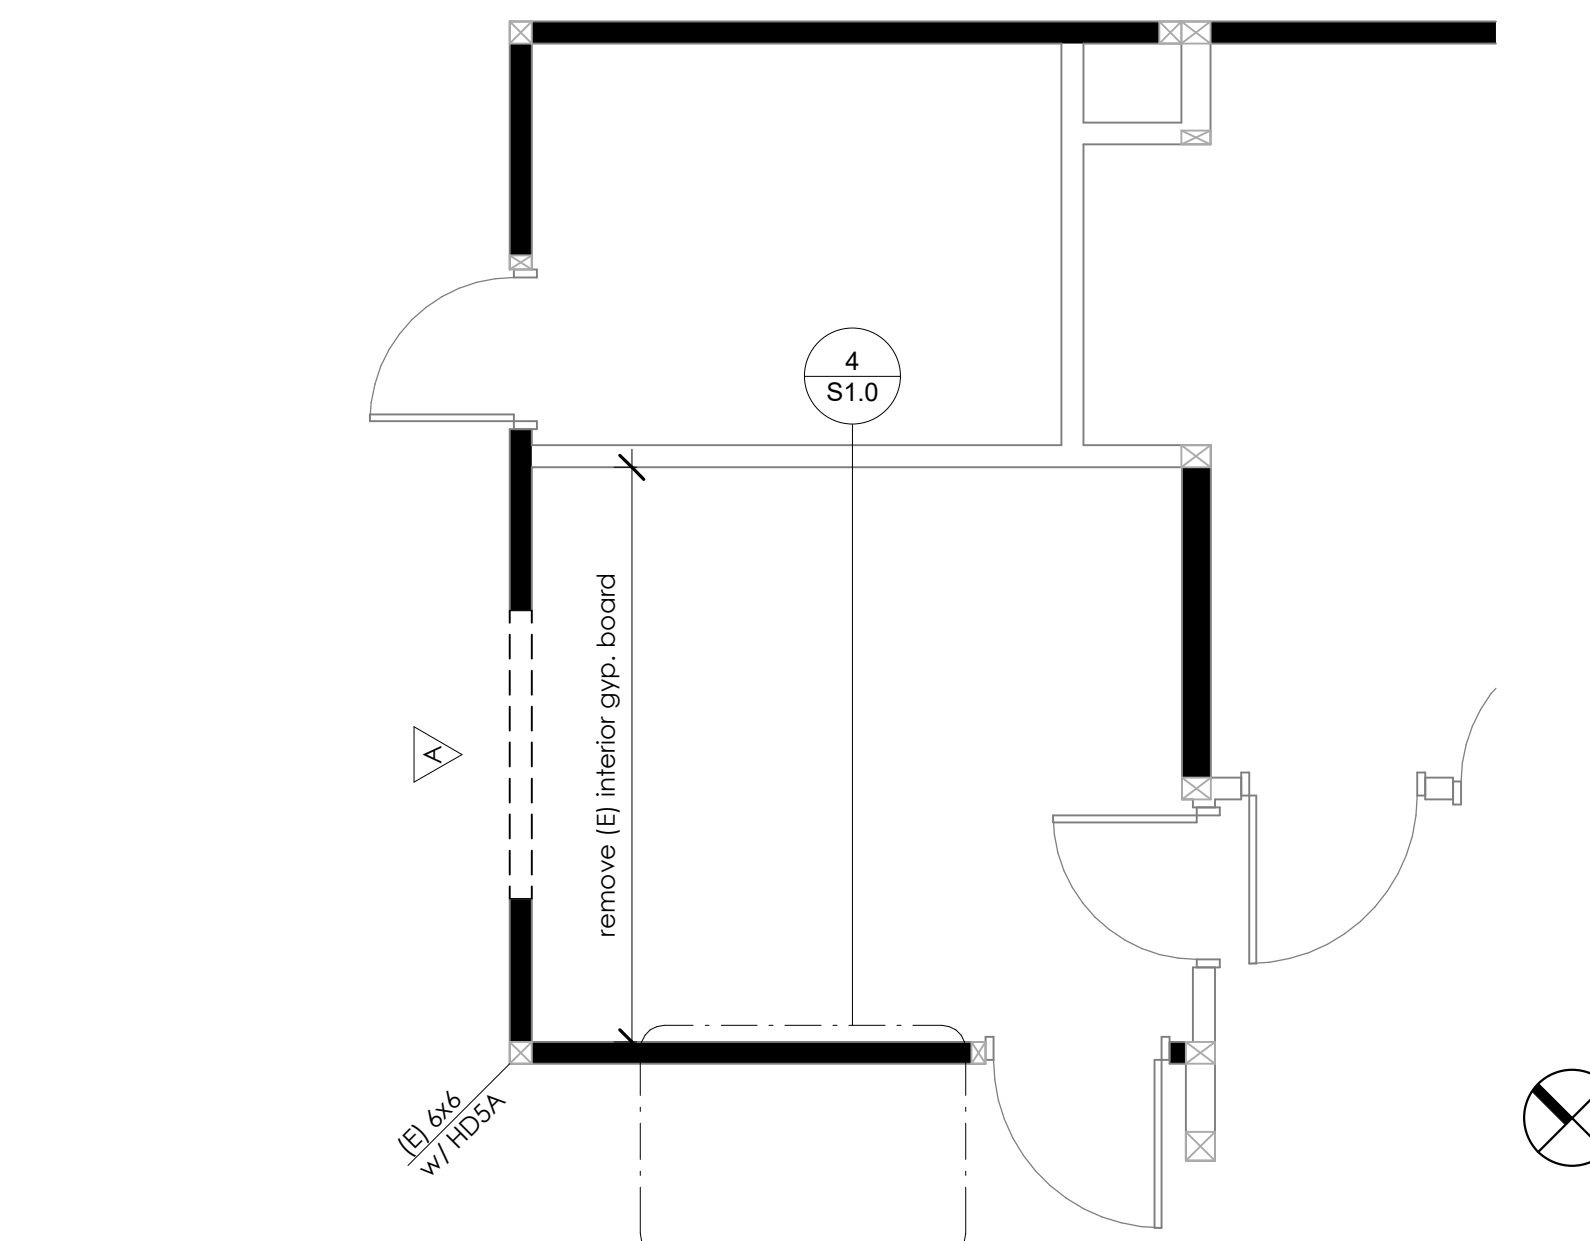

2 (E)/Demo Shear Wall Plan
S2.0 1/4" = 1'-0"

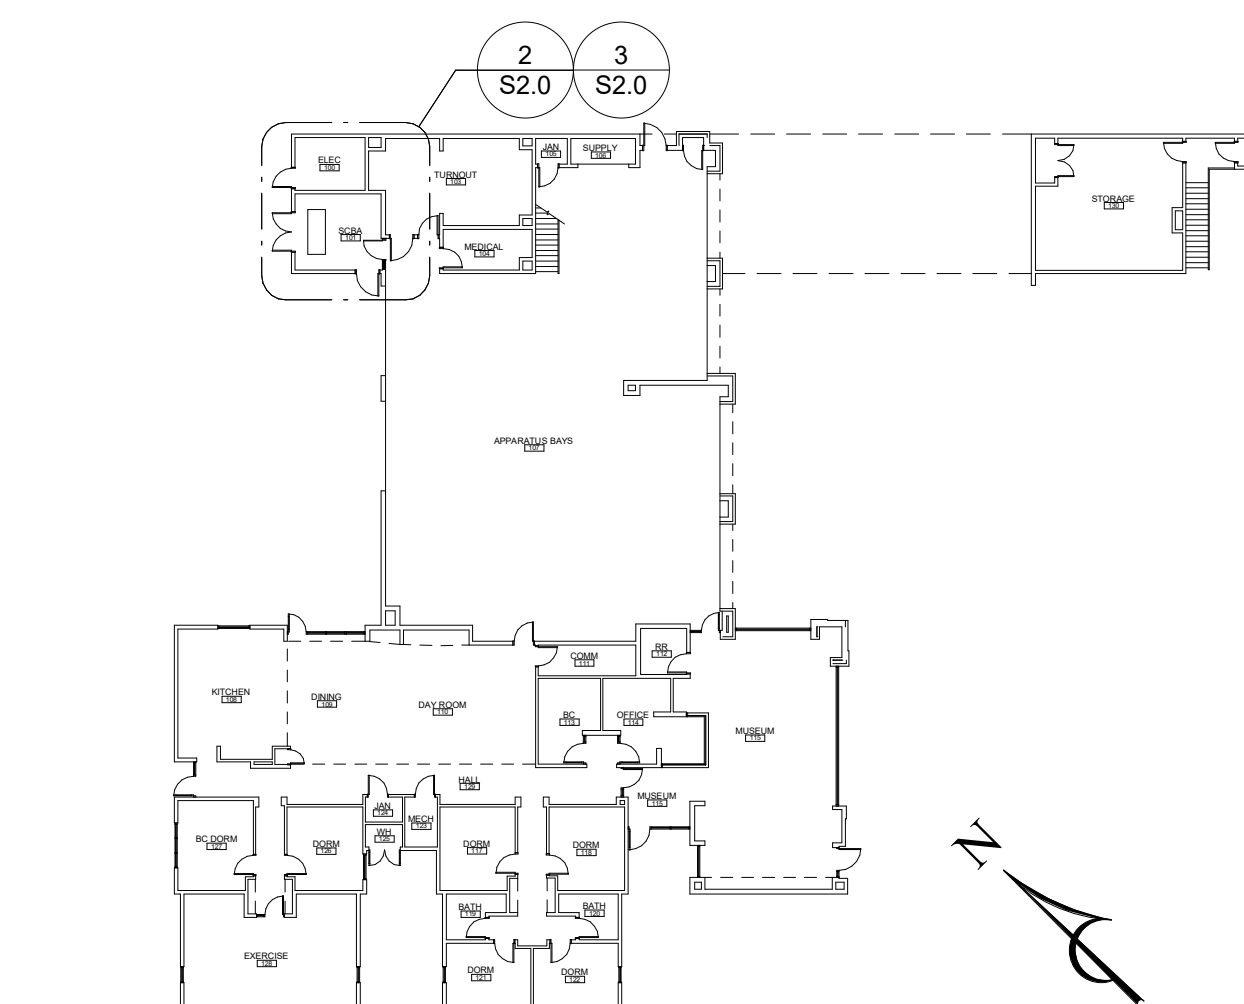

1 Shear Wall Key Plan - BID ALTERNATE #1
S2.0 1" = 30'-0"

AIR DISTRIBUTION DEVICE SCHEDULE (BASE BID)							
MK. NO.	MANUFACTURER & MODEL NO.	FRAME TYPE	BLOW PATTERN	OBD	MODULE SIZE	NECK SIZE	REMARKS
CE-1	TITUS #350FL	SURFACE	-	NO	SEE PLAN	SEE PLAN	ALUMINUM, WHITE FINISH. SEE NOTES #1 & #2

NOTES:
1. PROVIDE SQUARE TO ROUND TRANSITIONS AS REQUIRED.
2. PAINT ALL VISIBLE INTERIOR PORTIONS OF TERMINAL DEVICES & CANS WITH FLAT BLACK ENAMEL PAINT.

EXHAUST FAN SCHEDULE (BASE BID)											
MK. NO.	MANUFACTURER & MODEL NO.	DESCRIPTION	CFM	FAN RPM	SONES	S.P.	MOTOR HP	ELECTRICAL VOLT	OP. WEIGHT	REMARKS	
EF-1	COOK #166	DOWNBLAST CENTRIFUGAL FAN	2640	542	5.4	0.4"	1/3	115	1	106 LBS	SEE NOTE #1, #2, #3, #4

NOTES:
1. DISCONNECT BY ELECTRICAL.
2. PROVIDE WITH BACKDRAFT DAMPER AND INSECT SCREEN
3. PROVIDE WITH LINE VOLT THERMOSTAT SET AT 90°F.
4. PROVIDE WITH SLOPED ROOF CURB 5/12, "COOK RCG". FAN TO BE INSTALLED LEVEL.

LOUVER SCHEDULE (BASE BID)					
MK. NO.	MANUFACTURER & MODEL NO.	SIZE (W x H)	FREE AREA	VELOCITY	REMARKS
L-1	RUSKIN #ELF375DX	24" x 60"	5.30 SQ FT	500 FPM	SEE NOTE #1

NOTES:
1. STATIONARY EXHAUST LOUVER WITH ALUMINUM CONSTRUCTION. PROVIDE 1/2" BIRD SCREEN.

INDOOR FAN COIL SCHEDULE (BID ALTERNATE #2)													
MK. NO.	MANUFACTURER & MODEL NO.	QTY.	DESCRIPTION	COOL MBH	HEAT MBH	CFM (HI)	ELECTRICAL VOLTS	PH	HZ	MCA	R/LRS SIZE	OP. WEIGHT	REMARKS
FC-1	MITSUBISHI#TPKA0A0121LA10A	1	WALL MOUNTED DUCTLESS FAN COIL	12.0	18.0	385	208	1	60	1.0	1/4" 1/2"	28 LBS	SEE NOTES #1, #2

NOTES:
1. PROVIDE WITH FACTORY HARD WIRED THERMOSTAT. T-STAT TO BE ACCESSIBLE WITH TOP MOUNTED AT 48" A.F.F.
2. PROVIDE WITH CONDENSATE PUMP, ROUTE CONDENSATE OVERHEAD.

CONDENSING UNIT SCHEDULE (BID ALTERNATE #2)														
MK. NO.	MANUFACTURER & MODEL NO.	QTY.	DESCRIPTION	COOL MBH	HEAT MBH	NOM. TONS	ELECTRICAL VOLTS	PH	HZ	MCA	MOCP	SEER 2	OP. WEIGHT	REMARKS
CU-1	MITSUBISHI#TRUZA0121KA70NA	1	OUTDOOR CONDENSING UNIT	12.0	18.0	1	208	1	60	11.0	28.0	21.3	93 LBS	SEE NOTES #1, #2

NOTES:
1. REFRIGERANT TYPE R-410A
2. DISCONNECT BY ELECTRICAL

PLUMBING FIXTURE SCHEDULE (BID ALTERNATE #2)	
MARK	DESCRIPTION
WB-1	WALL BOX: GALVANIZED STEEL WASHING MACHINE BOX, CENTER DRAIN, IPS "GUY GRAY" #FB150 REFER TO DETAIL 4M-3.0 FOR CONNECTION/PIPING DIAGRAM
AG-1	AIR GAP FITTING: 3/4" INLET, 1-1/2" OUTLET, JR SMITH #281-S

* INDICATES ADA/HCP COMPLIANT FIXTURE.

PLUMBING MATERIAL SPECIFICATIONS	
A. DWV	PIPE: SERVICE WEIGHT CAST IRON SOIL PIPE PER ASTM A-74 FITTINGS: CAST IRON "NO-HUB" PER CISPI 310
B. DOMESTIC WATER	PIPE: COPPER TYPE L PER ASTM B-88 FITTINGS: WROUGHT COPPER PER ANSI 16.22 INSULATION (3/4" DIA. PIPE AND SMALLER): INSULATE HW & HWR WITH 1" FIBERGLASS INSULATION AND ALL-SERVICE-JACKET INSULATION (1" - 1-1/2" DIA. PIPE): INSULATE HW & HWR WITH 1-1/2" FIBERGLASS INSULATION AND ALL-SERVICE-JACKET INSULATION (2" DIA. PIPE AND LARGER): INSULATE HW & HWR WITH 2" FIBERGLASS INSULATION AND ALL-SERVICE-JACKET
C. CONDENSATE DRAIN	PIPE: COPPER TYPE L PER ASTM B-88 FITTINGS: WROUGHT COPPER PER ANSI 16.22

MECHANICAL GENERAL NOTES

- SCOPE:
A NEW COMPLETE HVAC SYSTEM, INCLUDING MECHANICAL EQUIPMENT & DUCTWORK AS GENERALLY DELINEATED ON THE DRAWINGS. EQUIPMENT SHALL COMPLY WITH TITLE 24 CALIFORNIA CODE OF REGULATIONS.
- CODES:
ALL WORK MATERIAL AND EQUIPMENT SHALL BE FURNISHED AND INSTALLED IN COMPLIANCE WITH THE FOLLOWING CODES AS ADOPTED AND AMENDED BY THE INSPECTING AUTHORITY HAVING JURISDICTION. NOTHING IN THESE PLANS SHALL BE CONSTRUED TO PERMIT THE INSTALLATION OF WORK, MATERIAL OR EQUIPMENT NOT CONFORMING TO THESE OR OTHER CODES APPLICABLE TO THIS PROJECT.
 - 2022 CALIFORNIA ADMINISTRATIVE CODE (CAC) PART 1, TITLE 24, CALIFORNIA CODE OF REGULATIONS (CCR)
 - 2022 CALIFORNIA BUILDING CODE (CBC) PART 2, TITLE 24, CCR BASED ON THE 2021 INTERNATIONAL BUILDING CODE (IBC)
 - 2022 CALIFORNIA ELECTRICAL CODE (CEC) PART 3, TITLE 24, CCR BASED ON THE 2020 NATIONAL ELECTRICAL CODE (NEC)
 - 2022 CALIFORNIA MECHANICAL CODE (CMC) PART 4, TITLE 24, CCR BASED ON THE 2021 UNIFORM MECHANICAL CODE (UMC)
 - 2022 CALIFORNIA PLUMBING CODE (CPC) PART 5, TITLE 24, CCR BASED ON THE 2021 UNIFORM PLUMBING CODE (UPC)
 - 2022 CALIFORNIA ENERGY CODE (CEC) PART 6, TITLE 24 CCR.
 - 2022 CALIFORNIA FIRE CODE (CFC) PART 9, TITLE 24, CCR BASED ON THE 2021 INTERNATIONAL FIRE CODE (IFC)
 - 2022 CALIFORNIA GREEN BUILDING STANDARDS (CGBCS) PART 11, TITLE 24, CCR
- WORKMANSHIP:
ALL WORKMANSHIP SHALL BE DONE IN A NEAT AND ORDERLY MANNER ACCORDING TO THE BEST TRADE PRACTICE BY THOSE SKILLED IN THE PARTICULAR TRADE. EQUIPMENT, DUCTS, GRILLES, ETC., SHALL BE PLUMB, LEVEL, SQUARE OR CENTERED ETC. TO GIVE A NEAT AND PLEASING APPEARANCE. ALL EQUIPMENT SHALL BE INSTALLED IN STRICT COMPLIANCE WITH MANUFACTURER'S RECOMMENDATIONS.
- AVAILABLE POWER:
THE MECHANICAL CONTRACTOR SHALL CONFIRM ALL SYSTEMS VOLTAGES BEFORE BIDDING OR ORDERING EQUIPMENT, AND SHALL ALLOW FOR BUCK & BOOST TRANSFORMERS IF REQUIRED.
- AIR BALANCE:
THE AIR DISTRIBUTION SYSTEM SHALL BE BALANCED TO DELIVER SPECIFIED AIR QUANTITIES FOLLOWING THE PROCEDURES OF THE LATEST EDITION OF THE SMACNA PUBLICATION PROCEDURAL STANDARDS FOR TESTING ADJUSTING & BALANCING OF ENVIRONMENTAL SYSTEMS. CONTRACTOR SHALL PROVIDE ACCESSIBLE & ADJUSTABLE VOLUME DAMPERS AS REQUIRED TO BALANCE THE SYSTEMS AND MAINTAIN A NOISE CRITERIA LEVEL NOT TO EXCEED 30.
THE AIR BALANCE TECHNICIAN SHALL BE RESPONSIBLE TO MODIFY ALL SUPPLY, RETURN, AND EXHAUST FAN SHEAVES & VFD OUTPUT FREQUENCY LIMITS AS APPLICABLE SUCH THAT THE DESIGN AIR FLOWS ARE MET. ALL SUPPLY FANS CONTROLLED FOR FILTER LOADING SHALL SIMILARLY BE MODIFIED TO ENSURE THE FULL RANGE OF MOTOR POWER IS AVAILABLE TO THE CONTROL SYSTEM. RATED MAXIMUM FAN SPEED SHALL NOT BE EXCEEDED.
- PERMITS AND UTILITY SERVICE FEES:
CONTRACTOR TO ARRANGE AND PAY FOR ALL PERMITS, INSPECTIONS AND SERVICE CHARGES REQUIRED IN THE INSTALLATION OF THE WORK.
- EXISTING INFORMATION:
LOCATION, SIZE, MATERIAL, ETC. OF EXISTING SYSTEMS, ETC., IS PROVIDED FROM SOURCES DEEMED TO BE RELIABLE BUT IS NOT GUARANTEED. CONTRACTOR SHALL FIELD VERIFY ALL DATA BEFORE PROCEEDING WITH ANY WORK. NO EXTRA COST WILL BE ALLOWED FOR CONDITIONS NOT AS SHOWN.
- ACCURACY:
PLANS ARE DIAGRAMMATIC. CONTRACTOR SHALL CONFIRM ALL DIMENSIONS AND LOCATIONS OF AC UNITS, EXHAUST FANS, WALLS, PARTITIONS ETC., AGAINST ARCHITECTURAL AND STRUCTURAL DESIGN PLANS FOR LOCATION CONSISTENCY & ACCURACY PRIOR TO COMMENCING WITH ANY WORK.
- PAINTING:
PAINT ALL VISIBLE INTERIOR PORTIONS OF TERMINAL DEVICES & CANS WITH FLAT BLACK ENAMEL PAINT.
- SIZES:
DUCTWORK SIZES ON PLANS ARE INSIDE NET FREE AREA.
- MECHANICAL EQUIPMENT:
ALL EQUIPMENT SHALL BE LISTED BY AN APPROVED TESTING AGENCY AND INSTALLED IN ACCORDANCE WITH ITS INSTALLATION INSTRUCTIONS AND LISTING.

DUCTWORK NOTES

- ALL WORK TO BE DONE IN ACCORDANCE WITH THE LATEST EDITION OF THE APPLICABLE SMACNA STANDARDS AND FABRICATION GUIDELINES. ALL METAL DUCTS SHALL BE CONSTRUCTED OF GALVANIZED SHEET METAL PER CALIFORNIA MECHANICAL CODE STANDARDS, UNLESS NOTED OTHERWISE.
- DUCT PRESSURE CLASS SHALL BE MINIMUM 2" W.C. AND SHALL EXCEED THE FAN SYSTEM DESIGN EXTERNAL STATIC PRESSURE WHERE APPLICABLE.
- PROVIDE TURNING VANES ON ALL SQUARE THROAT ELBOWS. RADIUS ELBOWS SHALL HAVE A THROAT RADIUS EQUAL TO OR GREATER THAN THE DUCT WIDTH. (USE SMACNA ELBOW TYPES RE 1 OR RE 2 ONLY, UNLESS NOTED OTHERWISE.)
- DIVIDED FLOW BRANCHES SHALL SPLIT WITH ELBOWS PER NOTE 3. (USE SMACNA TYPE 1, 2, OR 4A/4B UNLESS NOTED OTHERWISE.)
- BRANCH FITTING TAKEOFFS SHALL BE WYES, 45° LEAD IN, OR CONICAL/BELLMOUTH TAPS UNLESS NOTED OTHERWISE. DO NOT USE STRAIGHT TAPS.
- ALL SUPPLY AND RETURN DUCT SHALL BE INSULATED PER T24 THICKNESS AND R-VALUE REQUIREMENTS (CEC 120.4(a)):
 - SUPPLY DUCT: MIN. R-4.2, BUT R-8 WHERE EXPOSED TO EXTERIOR OR UNCONDITIONED SPACE.
 - RETURN DUCT: MIN. R-4.2, BUT R-8 WHERE EXPOSED TO EXTERIOR OR UNCONDITIONED SPACE.
 - EXHAUST DUCT: NO INSULATION EXCEPT AS SHOWN.
- EXTERNAL INSULATION EXPOSED TO WEATHER SHALL BE WEATHERPROOFED AND SHALL BE PAINTED TO MATCH ADJACENT SURFACE.
- PROVIDE DUCT LEAKAGE TEST PER CMC 603.9.2.

DEMOLITION NOTES

- THE CONTRACTOR SHALL VISIT THE PROJECT SITE AND MAKE HIMSELF AWARE OF ALL EXISTING CONDITIONS WHICH CAN BE OBSERVED. ADDITIONAL COSTS WILL NOT BE ALLOWED FOR CORRECTION OF ITEMS WHICH CAN BE OBSERVED AND THEREFORE SHOULD BE INCLUDED IN HIS BID. THE CONTRACTOR IS RESPONSIBLE FOR ALL DEMOLITION WORK REQUIRED TO COMPLETE THIS PROPOSED PROJECT.
- THE NOTES AND DRAWINGS CONTAINED ON THIS SHEET DESCRIBE IN A GENERAL SENSE THE EXTENT OF ITEMS TO BE MODIFIED, REMOVED OR INSTALLED. THIS DESCRIPTION DOES NOT NECESSARILY INCLUDE A DESCRIPTION OF ITEMS TO BE REPAIRED OR REFINISHED AS A RESULT OF THIS REMOVAL OR MODIFICATION. IN THE ABSENCE OF ANY SPECIFIC DIRECTION, THE CONTRACTOR SHALL REPAIR THE AFFECTED AREA(S) TO A CONDITION EQUAL TO THE ADJACENT AREA(S) AND/OR SIMILAR EXISTING CONDITIONS ON PROJECT.
- THE CONTRACTOR SHALL PROVIDE DUST AND DEBRIS CONTROL THROUGHOUT THE PROJECT'S CONSTRUCTION. THE CONTRACTOR SHALL COORDINATE HIS WORK WITH THE BUILDING OWNER TO PROVIDE THE LEAST INTERRUPTION OF EXISTING BUILDING OPERATIONS. COORDINATE WITH THE OWNER THE LOCATION OF ON-SITE STORAGE AND STAGING.
- NOT ALL REQUIRED PATCHING AND/OR REPAIRS ARE SPECIFICALLY NOTED ON THIS PLAN.
- COORDINATE DEMOLITION WORK WITH NEW PROPOSED FLOOR PLANS.
- CONTRACTOR SHALL DISCARD AND DISPOSE OF ALL DEMOLISHED ITEMS.
- EXISTING PIPING AND ELECTRICAL OR COMMUNICATION CONDUITS WHICH INTERFERE WITH THE WORK SHALL BE RE-ROUTED BY THE CONTRACTOR.

MECHANICAL LEGEND

DESCRIPTION	SYMBOL
SUPPLY AIR DUCT CROSS SECTION	
RETURN AIR DUCT CROSS SECTION	
EXHAUST AIR DUCT CROSS SECTION	
SUPPLY AIR DUCT - SINGLE LINE	
RETURN AIR DUCT - SINGLE LINE	
EXHAUST AIR DUCT - SINGLE LINE	
DUCT SIZE NET INSIDE DIMENSION	
FLEXIBLE DUCT CONNECTION	
DUCT DROP/RISE	
VOLUME DAMPER W/ LOCKING QUADRANT	
AUTO MOTORIZED CONTROLLED DAMPER	
FIRE DAMPER / CEILING FIRE DAMPER	
MOTORIZED FIRE / SMOKE DAMPER	

AIR REGISTER TAGS

1ST DIGIT - LOCATION
C-CEILING
W-WALL
F-FLOOR

2ND DIGIT - DUCT SYSTEM
S-SUPPLY
R-RETURN
E-EXHAUST

3RD DIGIT - IDENTIFIER
-1, -2, ETC.
SEE SCHEDULE

300 CFM = CUBIC FEET PER MINUTE
12"x12" = NECK/COLLAR SIZE

EXAMPLES

SMOKE DETECTOR

DUCT WITH ACOUSTICAL LINING

TO BE REMOVED

THERMOSTAT, MOUNT TOP AT +48" AFF

CONDENSATE DRAIN LINE

EQUIPMENT TAG

2-WAY CONTROL VALVE

3-WAY CONTROL VALVE

BALANCE VALVE

BUTTERFLY VALVE

CHECK VALVE

FLEXIBLE COUPLING

GLOBE VALVE

MANUAL AIR VENT - MAV

PETES PLUG

PRESSURE GAUGE

PRESSURE REDUCING VALVE - PRV

REDUCER

SHUT OFF COCK

SHUT OFF VALVE

STRAINER

THERMOMETER

UNION

CHILLED WATER SUPPLY

CHILLED WATER RETURN

CONDENSER WATER SUPPLY

CONDENSER WATER RETURN

HEATING HOT WATER SUPPLY

HEATING HOT WATER RETURN

HIGH PRESSURE STEAM

LOW PRESSURE STEAM

VENT

EXHAUST AIR

ABOVE FINISHED FLOOR

ACCESS DOOR / ACCESS PANEL

ANALOG INPUT / ANALOG OUTPUT

AUTOMATIC AIR VENT

CUBIC FEET PER HOUR

CUBIC FEET PER MINUTE

DIGITAL INPUT / DIGITAL OUTPUT

EXISTING

FLOW SWITCH

GALLONS PER MINUTE

THOUSANDS OF BTU'S PER HOUR

NEW

NOT IN MECHANICAL CONTRACT

OUTSIDE AIR

POINT OF CONNECTION

REFRIGERANT LIQUID / REFRIGERANT SUCTION

SHEET INDEX

SHEET NO.	DESCRIPTION
M-1.0	MECHANICAL - LEGEND, SCHEDULES, & NOTES
M-2.0	MECHANICAL - BASE BID DEMOLITION AND FLOOR PLANS
M-2.1	MECHANICAL - BID ALT. 1 DEMOLITION AND FLOOR PLANS
M-2.2	MECHANICAL - BID ALT. 2 DEMOLITION AND FLOOR PLANS
M-3.0	MECHANICAL - DETAILS



WMB ARCHITECTS

5757 Pacific Avenue
Suite 226
Stockton, CA 95207


2000 L Street
Suite 125
Sacramento, CA 95811

T 209.944.9110
F 209.944.5711
www.wmbarchitects.com

CITY PROJECT NO.
24-010
FIRE STATION NO. 31,
SCBA COMPRESSOR
ROOM

540 E MARSHALL ST.
TURLOCK, CA 95380

WMB Project No. 24-023

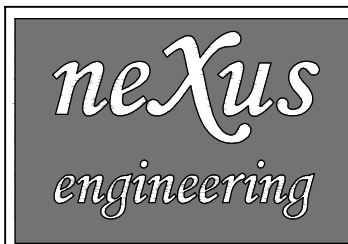

Consulting Mechanical Engineers
1400 Lone Palm Ave, Suite A
Modesto, CA 95351
Tel: 209.572.7399 Fax: 209.236.1579
www.nexusengineering.net
HVAC, Plumbing/Piping, Fire Sprinklers
Process/Plant Engineering, Refrigeration



PUBLISH HISTORY:

DATE	PURPOSE
11.08.24	BLDG PERMIT APP
1 02.18.25	PLAN CHECK #1

MECHANICAL - LEGEND,
SCHEDULES, & NOTES

M-1.0



WMB ARCHITECTS

5757 Pacific Avenue
Suite 226
Stockton, CA 95207


2000 L Street
Suite 125
Sacramento, CA 95811

T 209.944.9110
F 209.944.5711
www.wmbarchitects.com

CITY PROJECT NO.
24-010
FIRE STATION NO. 31,
SCBA COMPRESSOR ROOM

540 E MARSHALL ST.
TURLOCK, CA 95380

WMB Project No. 24-023

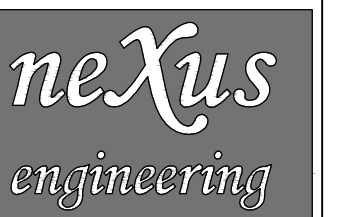

Consulting Mechanical Engineers
1400 Lone Palm Ave, Suite A
Modesto, CA 95351
Tel: 209.572.7399 Fax: 209.236.1579
www.nexusengineering.net
HVAC, Plumbing/Piping, Fire Sprinklers
Process/Plant Engineering, Refrigeration




PUBLISH HISTORY:


DATE	PURPOSE
11.08.24	BLDG PERMIT APP
1 02.18.25	PLAN CHECK #1

MECHANICAL - BASE BID
DEMOLITION AND FLOOR
PLANS


M-2.0

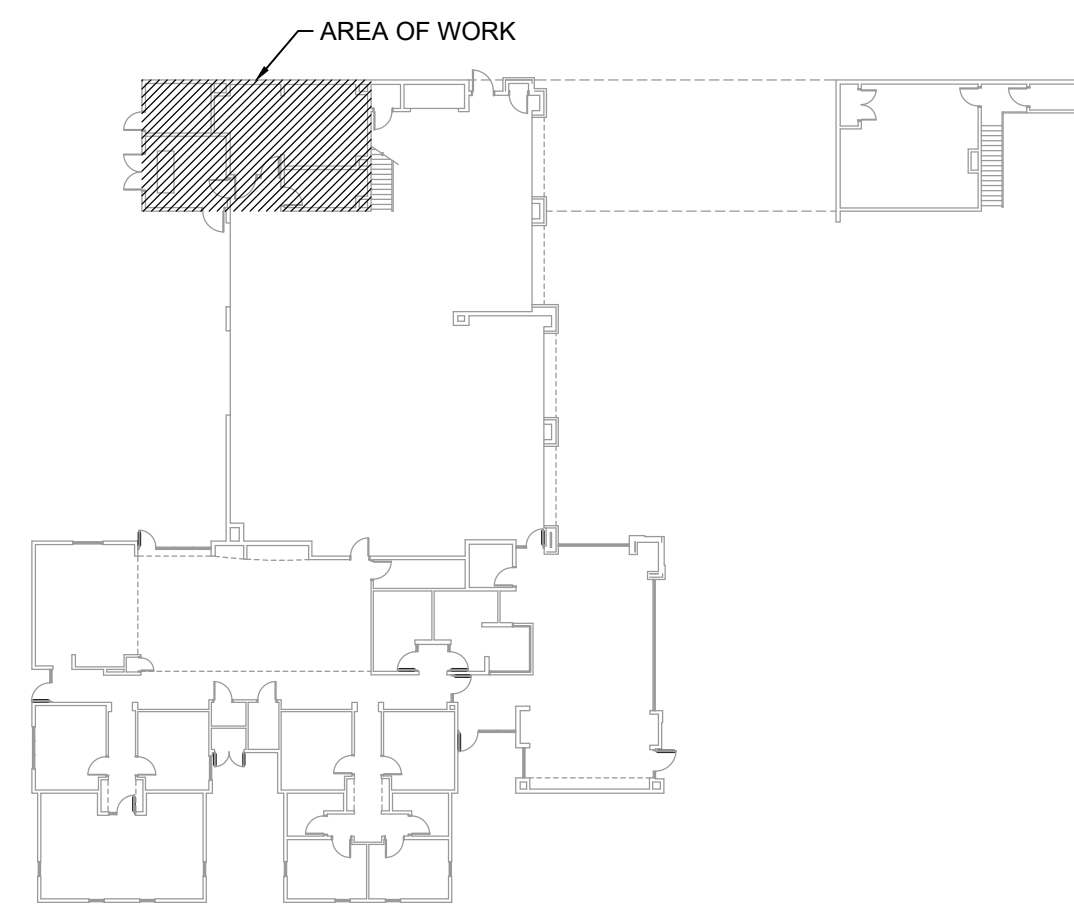

1 MECHANICAL - KEY PLAN
SCALE: 1/32" = 1'-0"

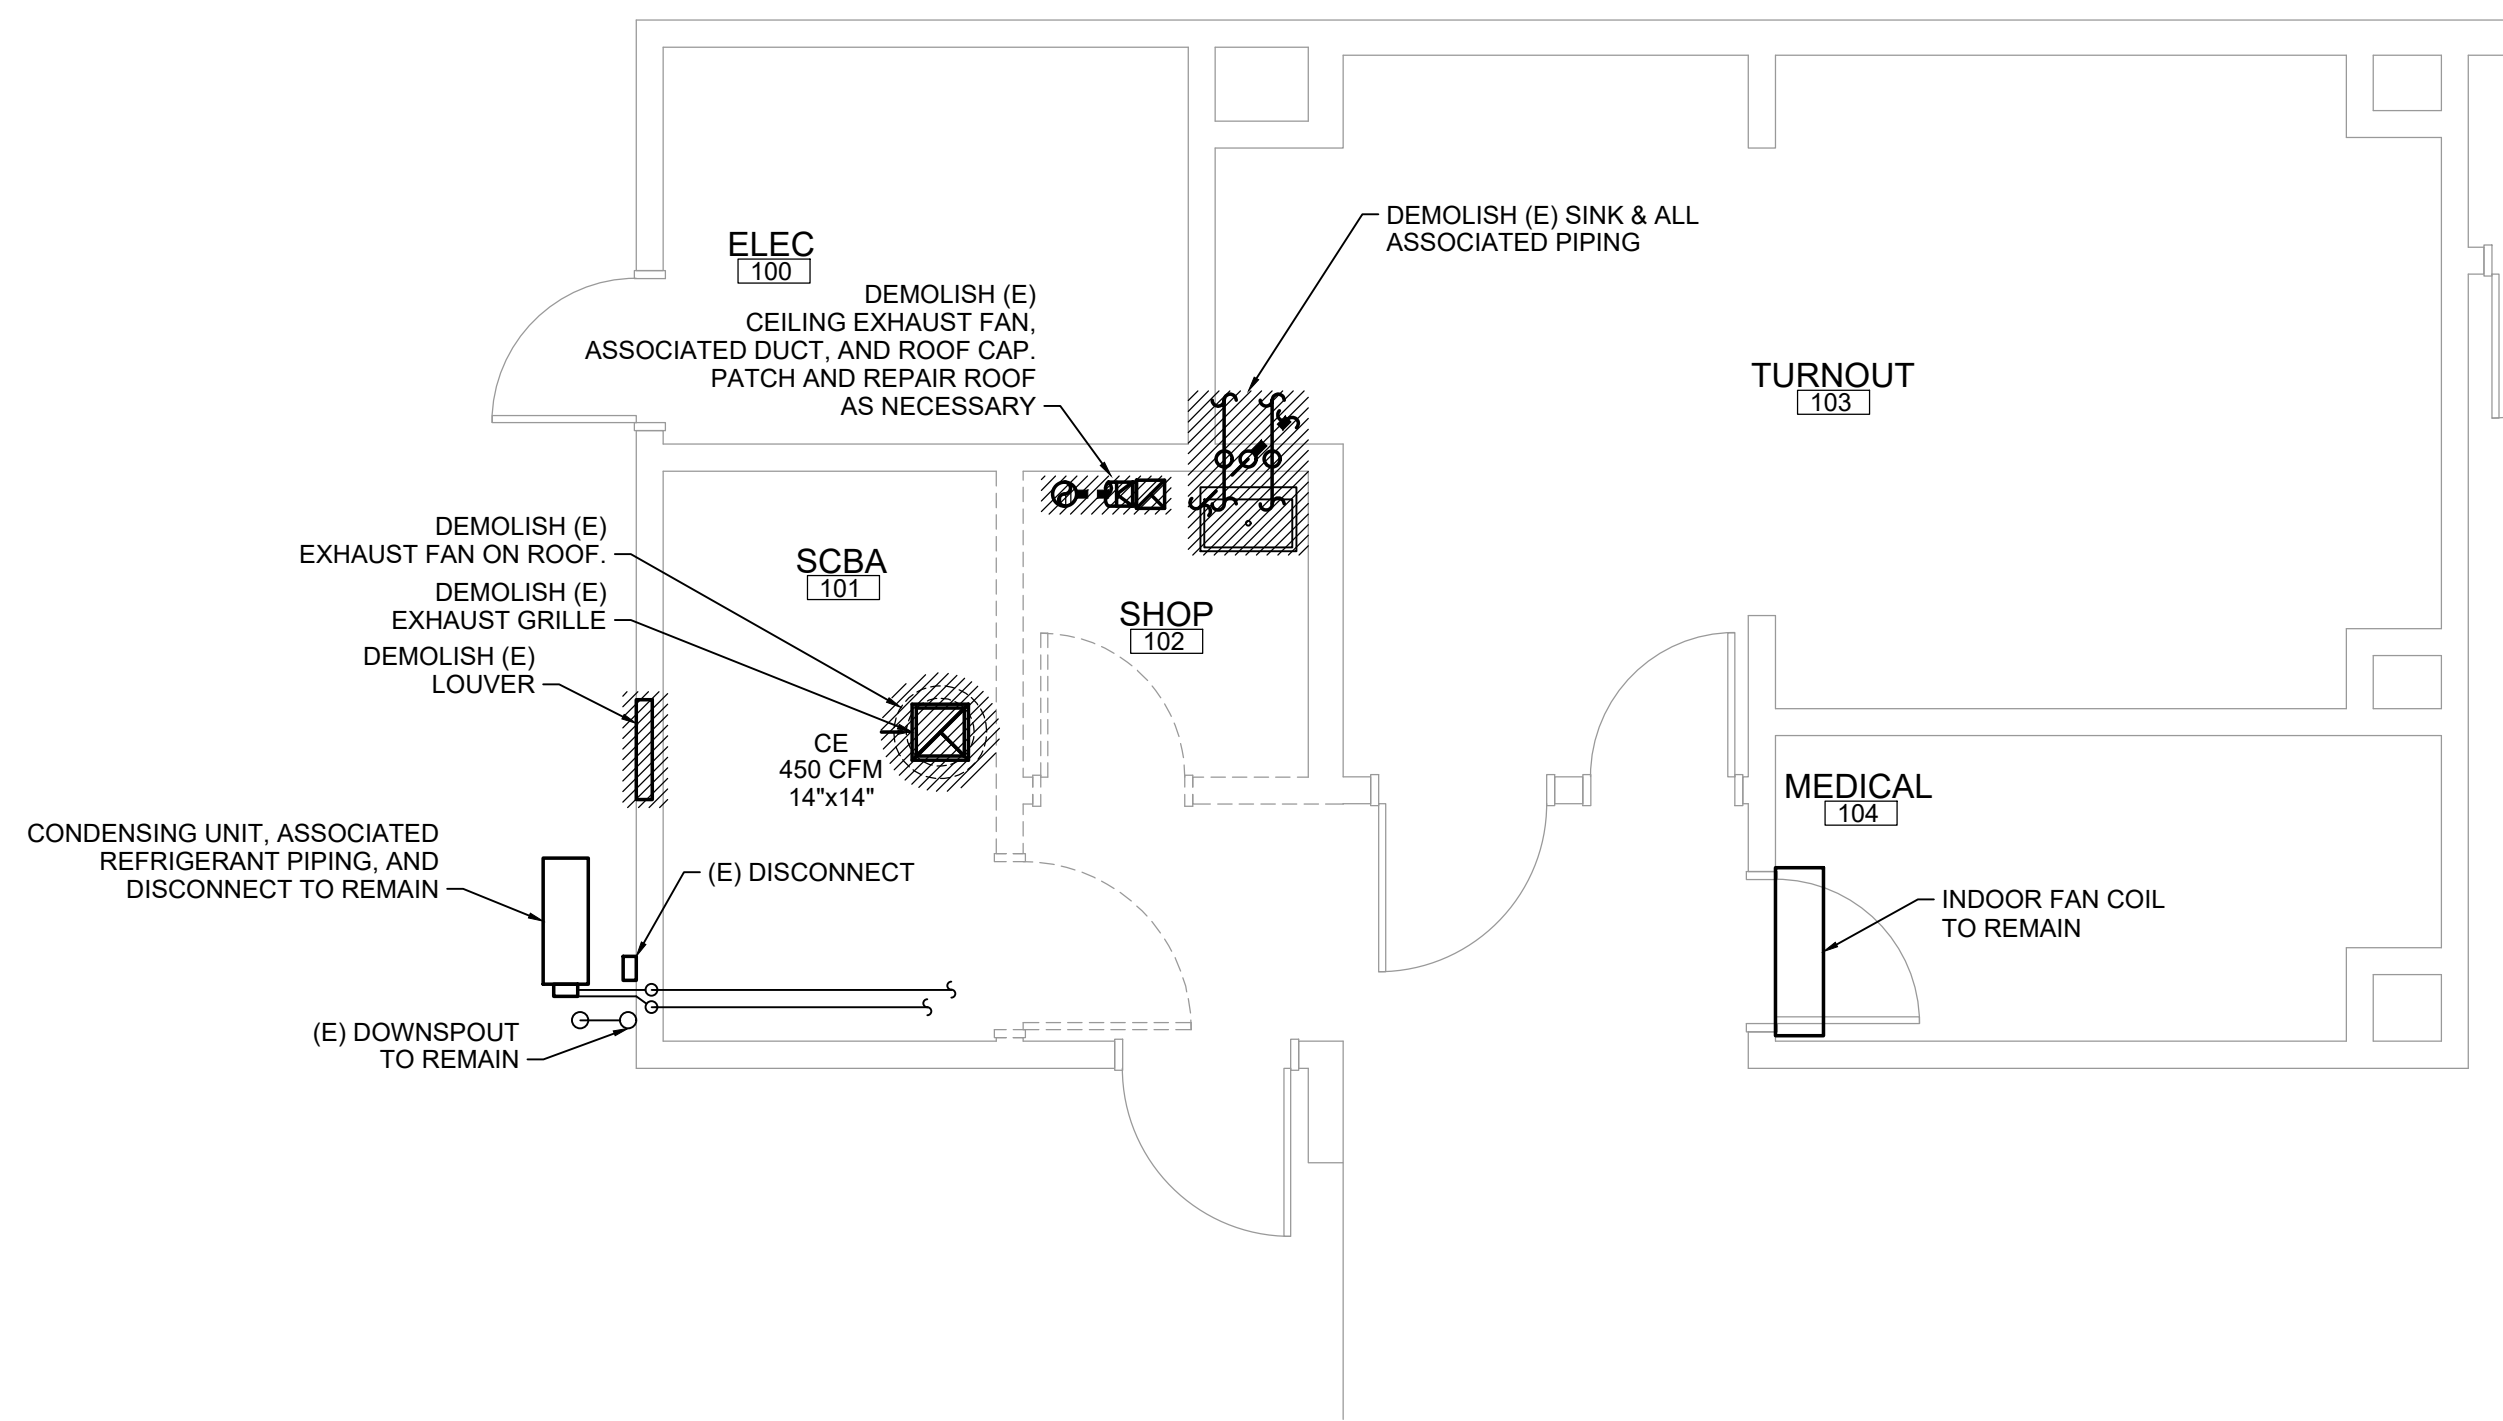

2 MECHANICAL - BASE BID DEMOLITION FLOOR PLAN
SCALE: 1/4" = 1'-0"

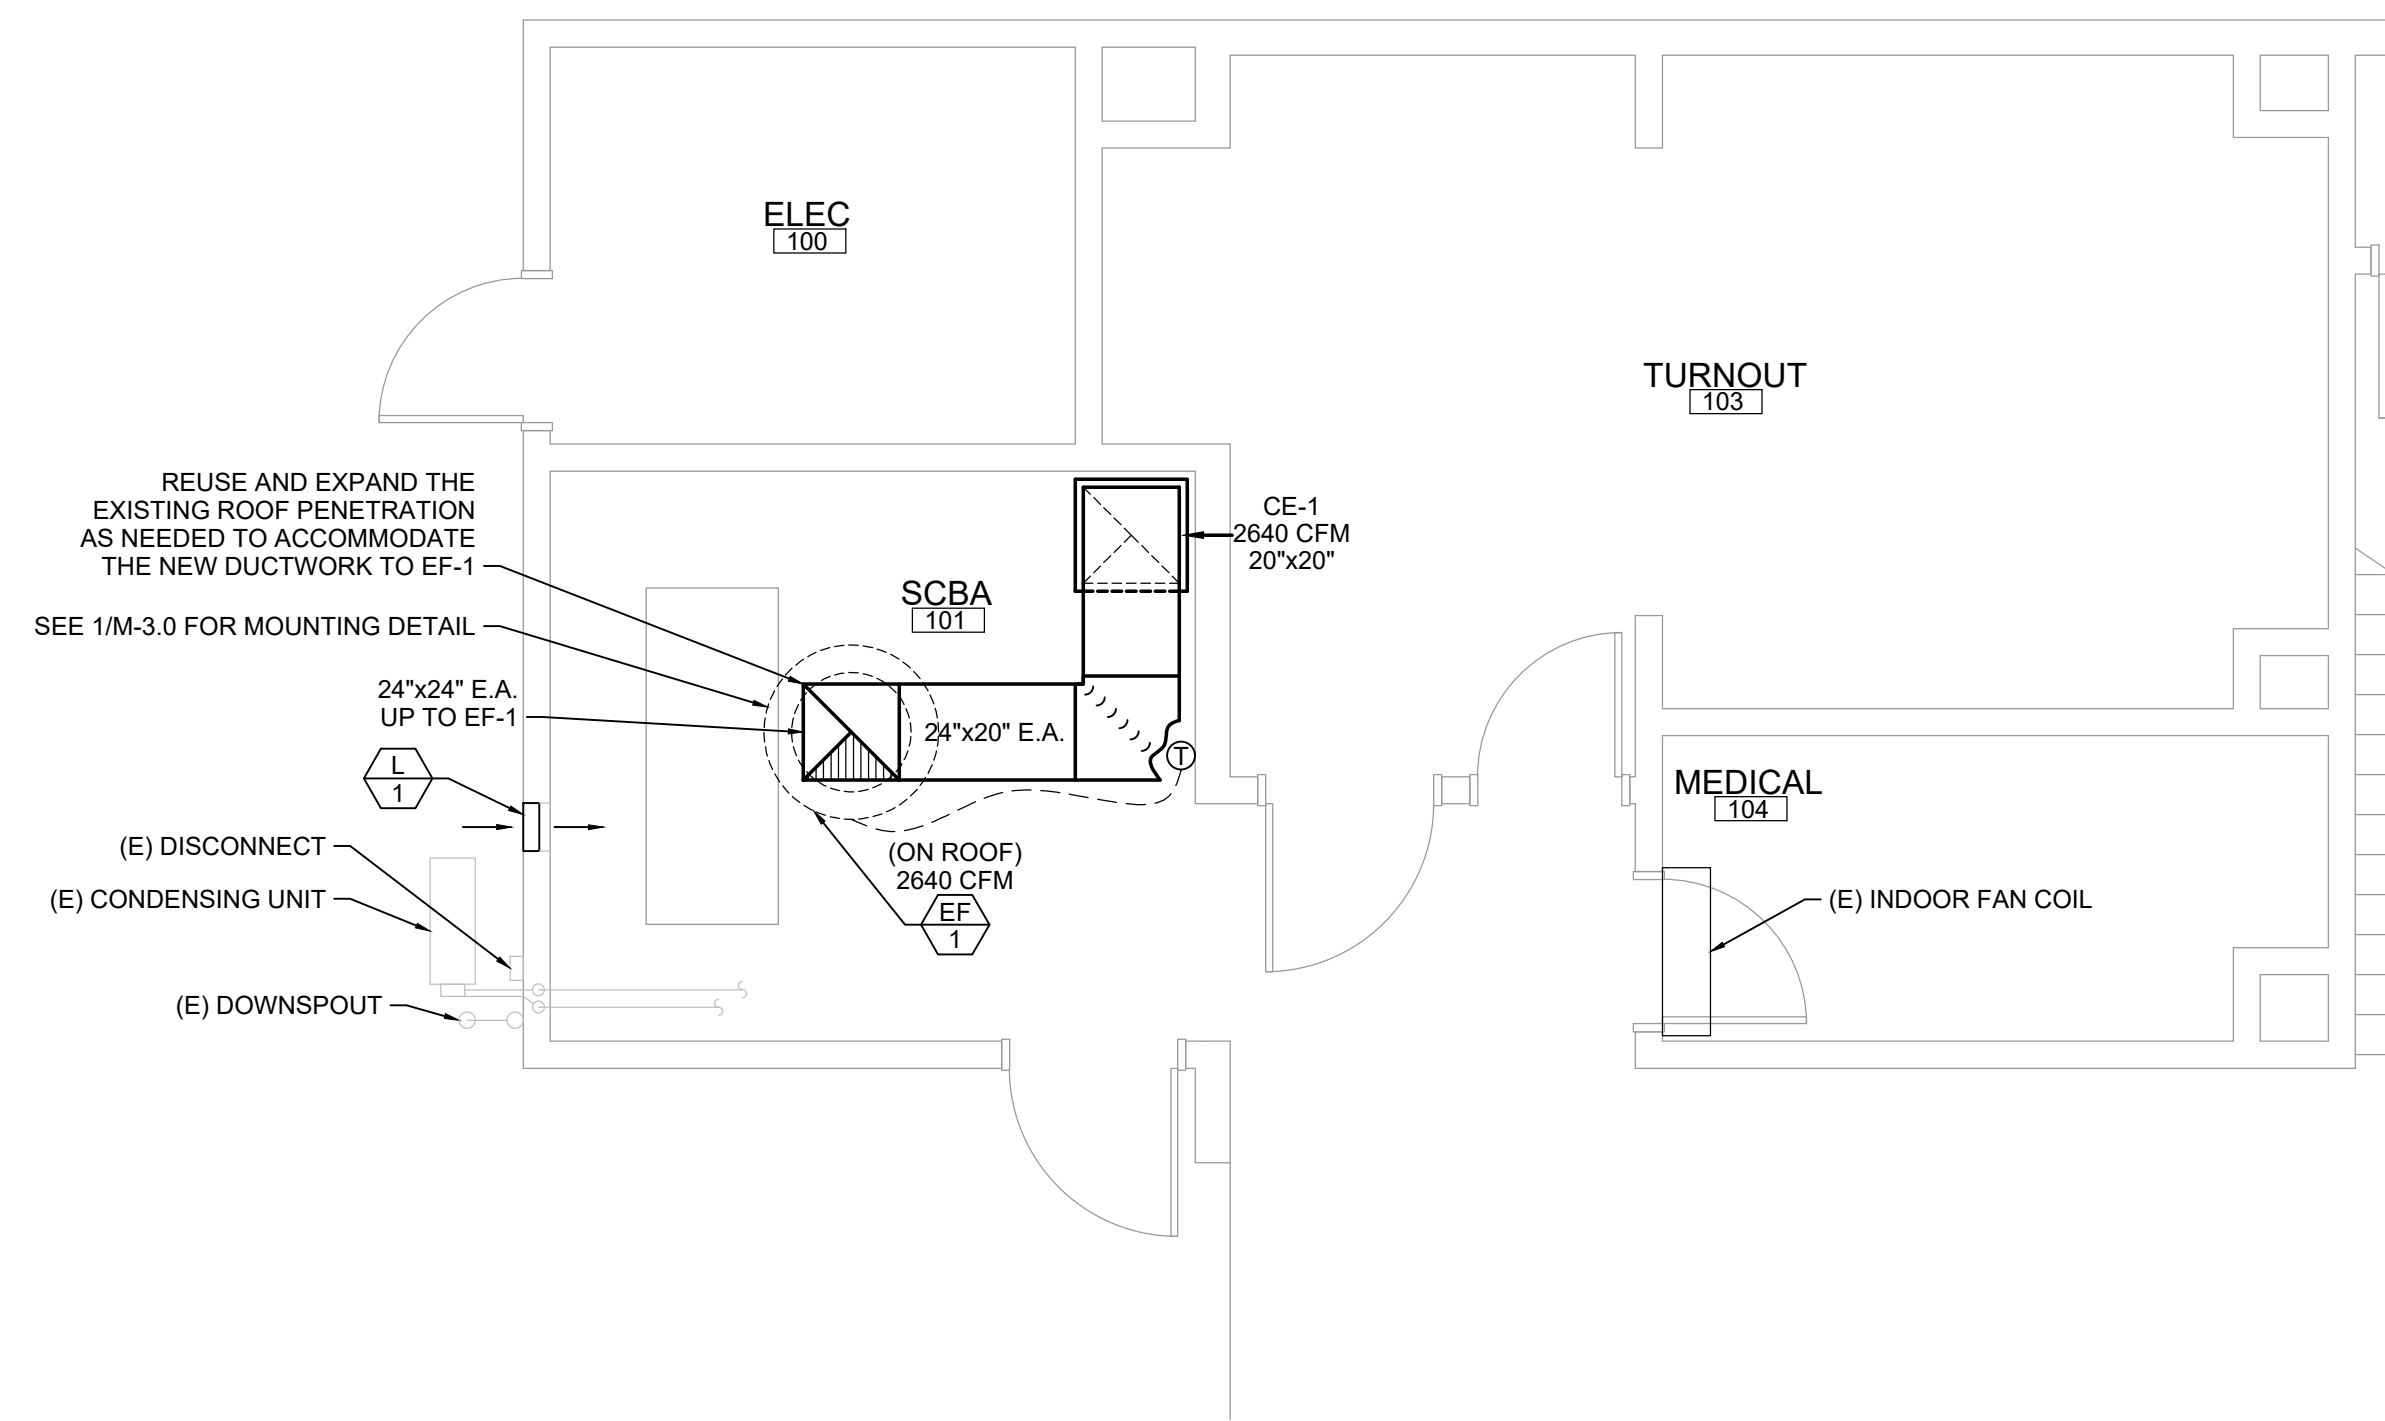

3 MECHANICAL - BASE BID FLOOR PLAN
SCALE: 1/4" = 1'-0"



J:\2024_Jobs\24189 - City of Turlock Fire Station 31 Compressor Room\24189 - Mechanical.dwg, 2/21/2025 10:53:15 AM, e.dejong



WMB ARCHITECTS

5757 Pacific Avenue
Suite 226
Stockton, CA 95207


2000 L Street
Suite 125
Sacramento, CA 95811

T 209.944.9110
F 209.944.5711
www.wmbarchitects.com

CITY PROJECT NO.
24-010
FIRE STATION NO. 31,
SCBA COMPRESSOR
ROOM

540 E MARSHALL ST.
TURLOCK, CA 95380

WMB Project No. 24-023

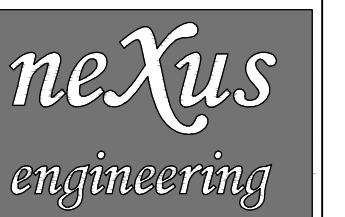

Consulting Mechanical Engineers
1400 Lone Palm Ave, Suite A
Modesto, CA 95351
Tel: 209.572.7399 Fax: 209.236.1579
www.nexusengineering.net
HVAC, Plumbing/Piping, Fire Sprinklers
Process/Plant Engineering, Refrigeration




PUBLISH HISTORY:


No.	DATE	PURPOSE
1	11.08.24	BLDG PERMIT APP
1	02.18.25	PLAN CHECK #1

MECHANICAL - BID ALT. 1
DEMOLITION AND FLOOR
PLANS


M-2.1

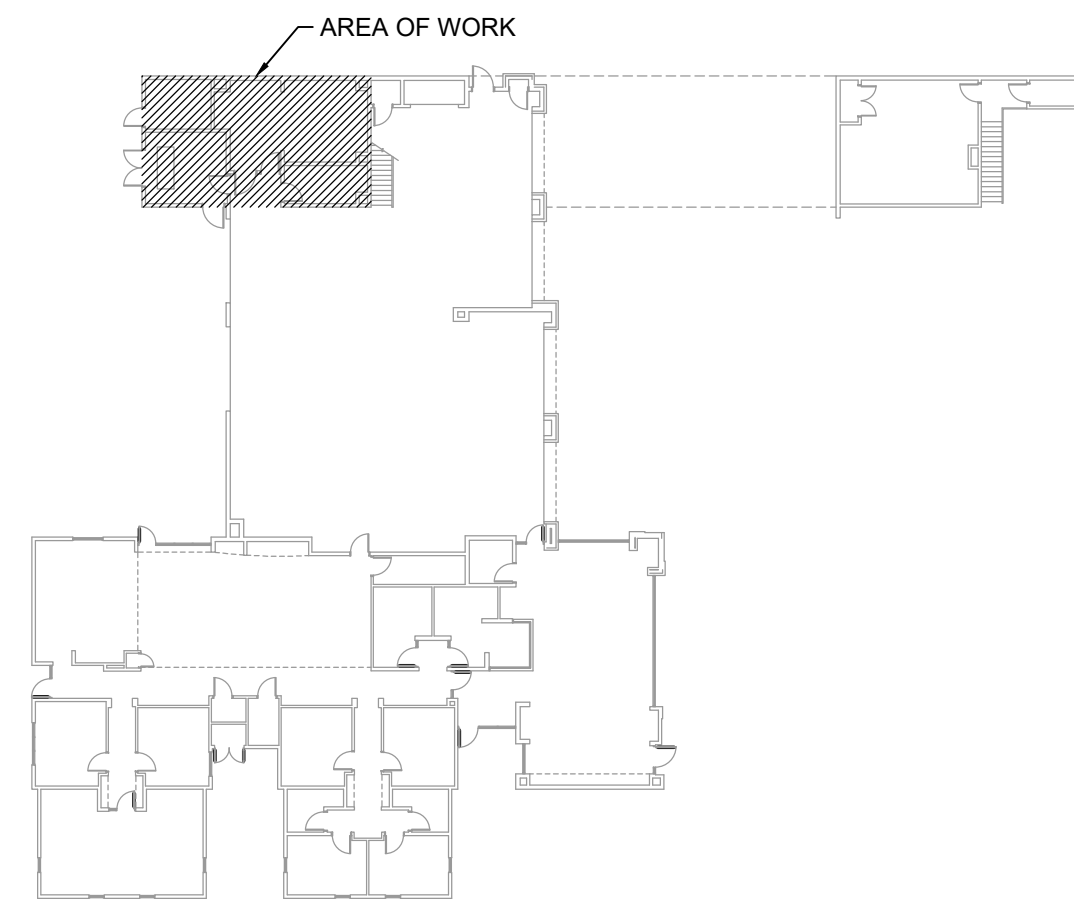

1 MECHANICAL - KEY PLAN
SCALE: 1/32" = 1'-0"

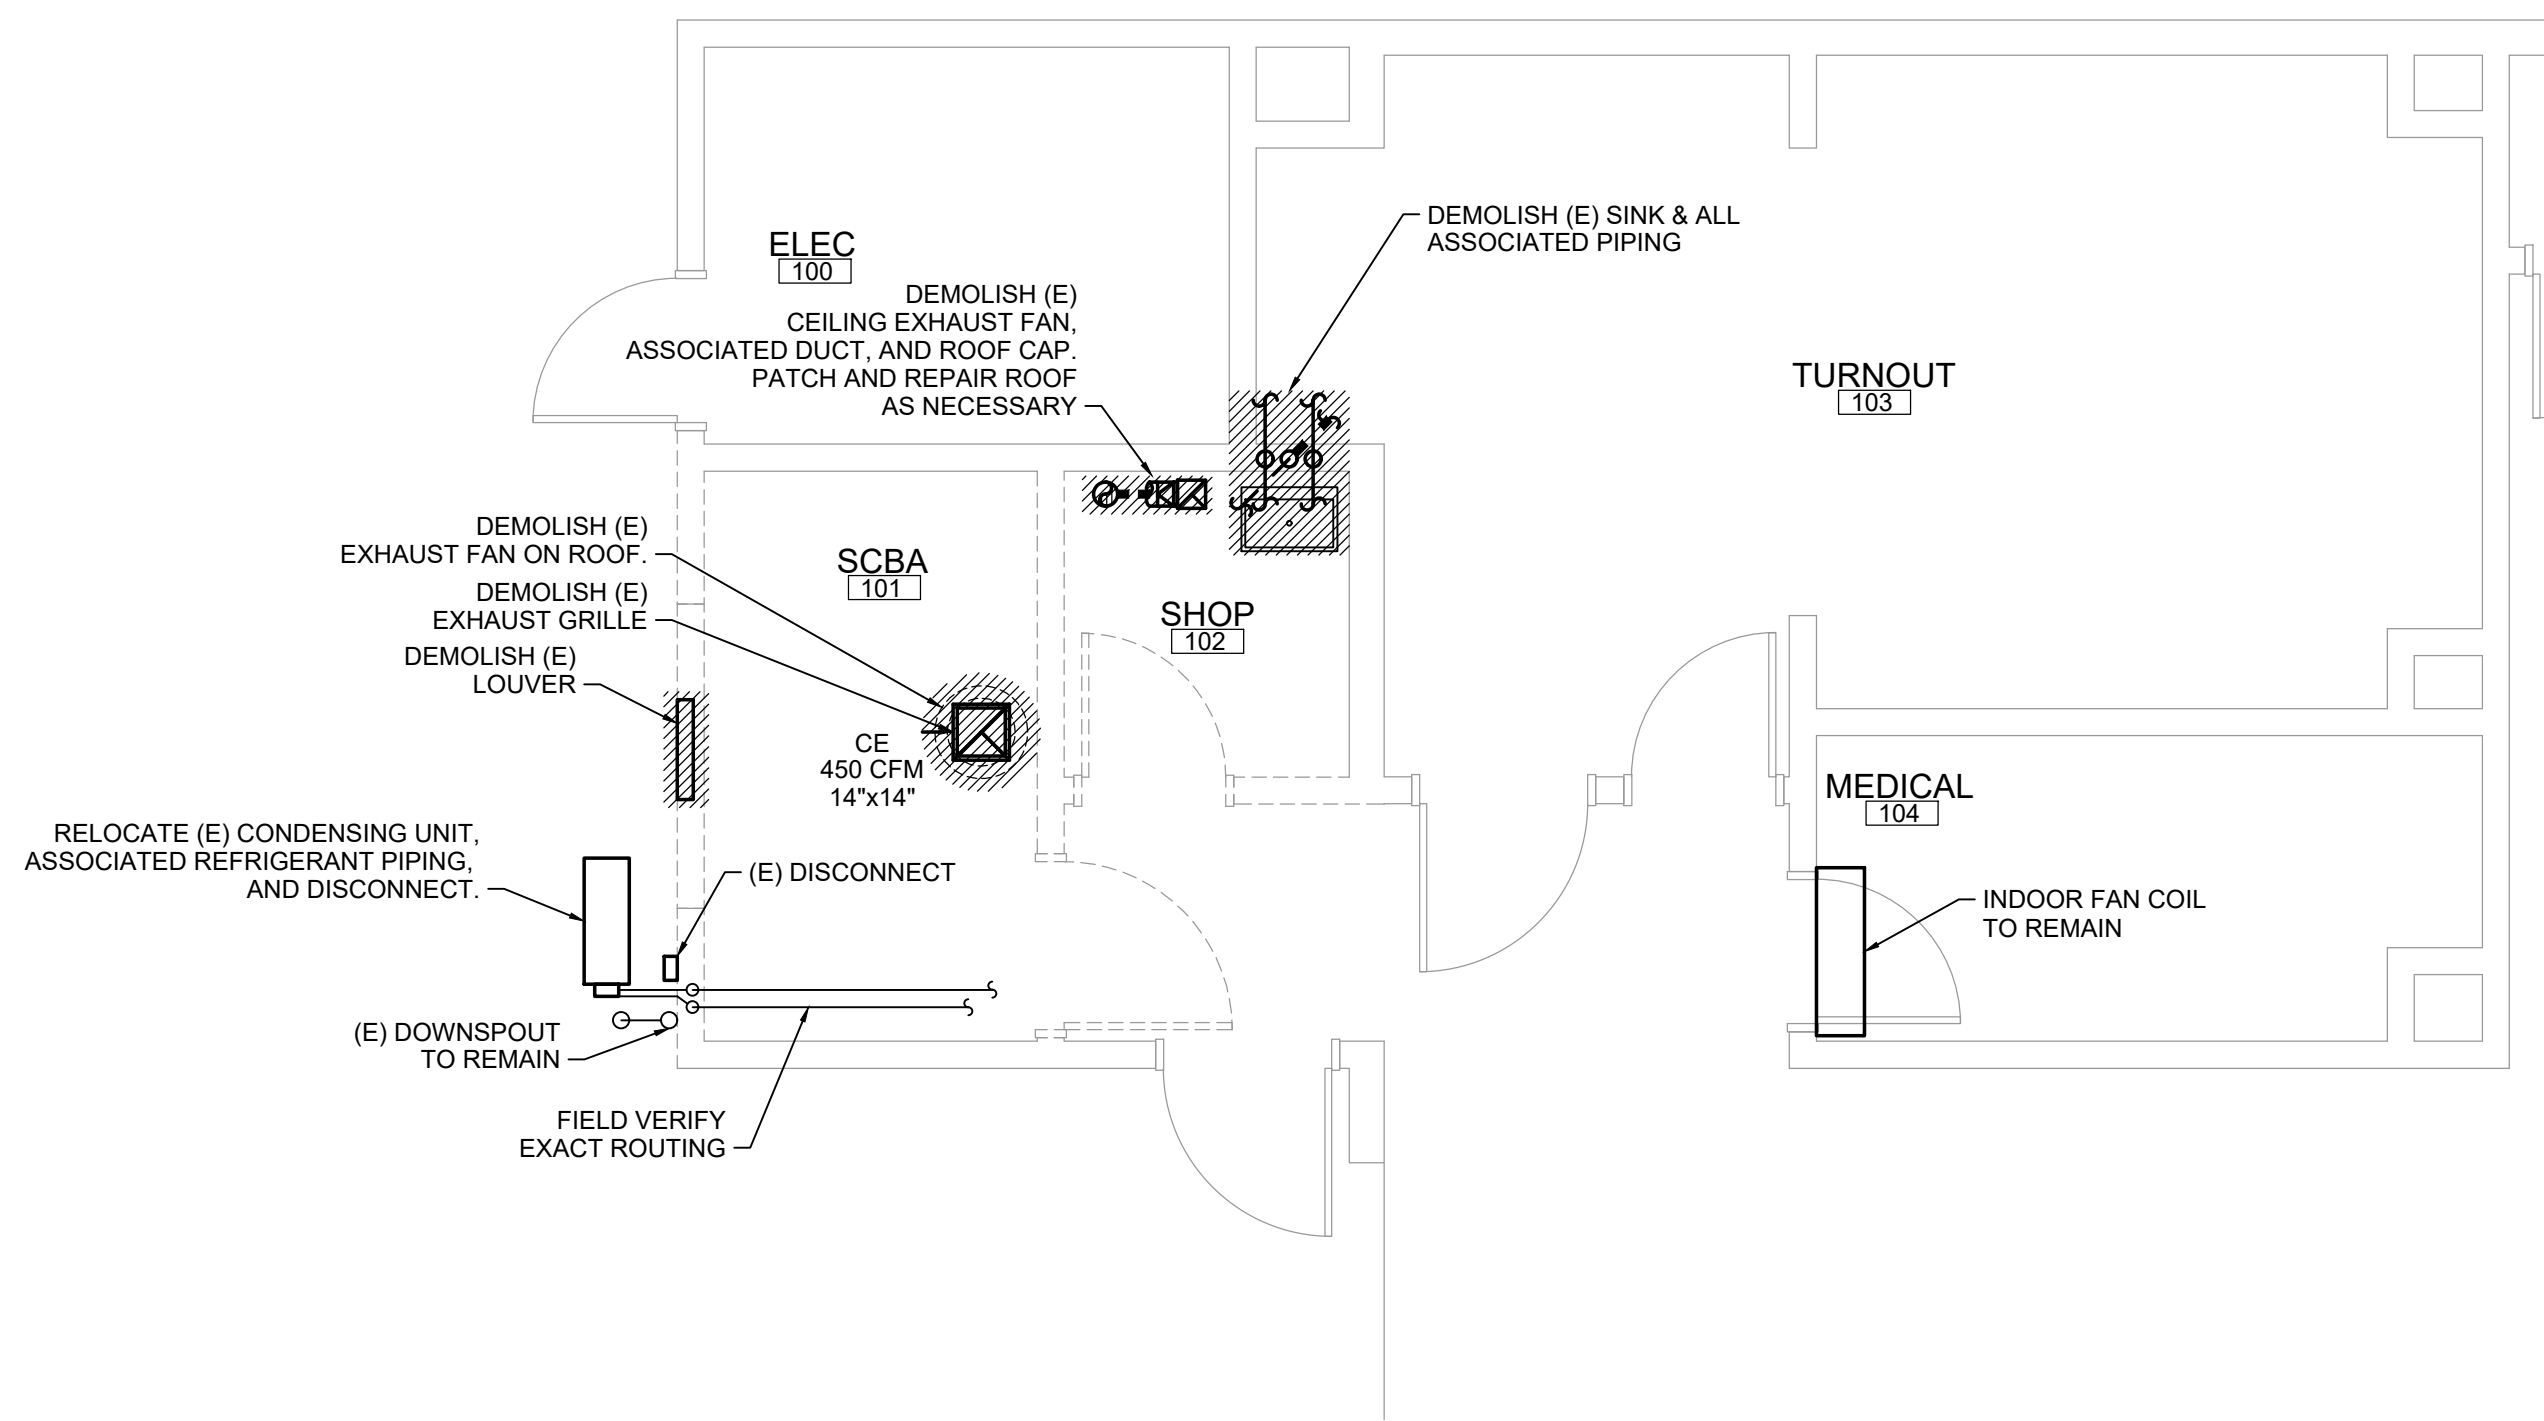

2 MECHANICAL - BID ALT. 1 DEMOLITION FLOOR PLAN
SCALE: 1/4" = 1'-0"

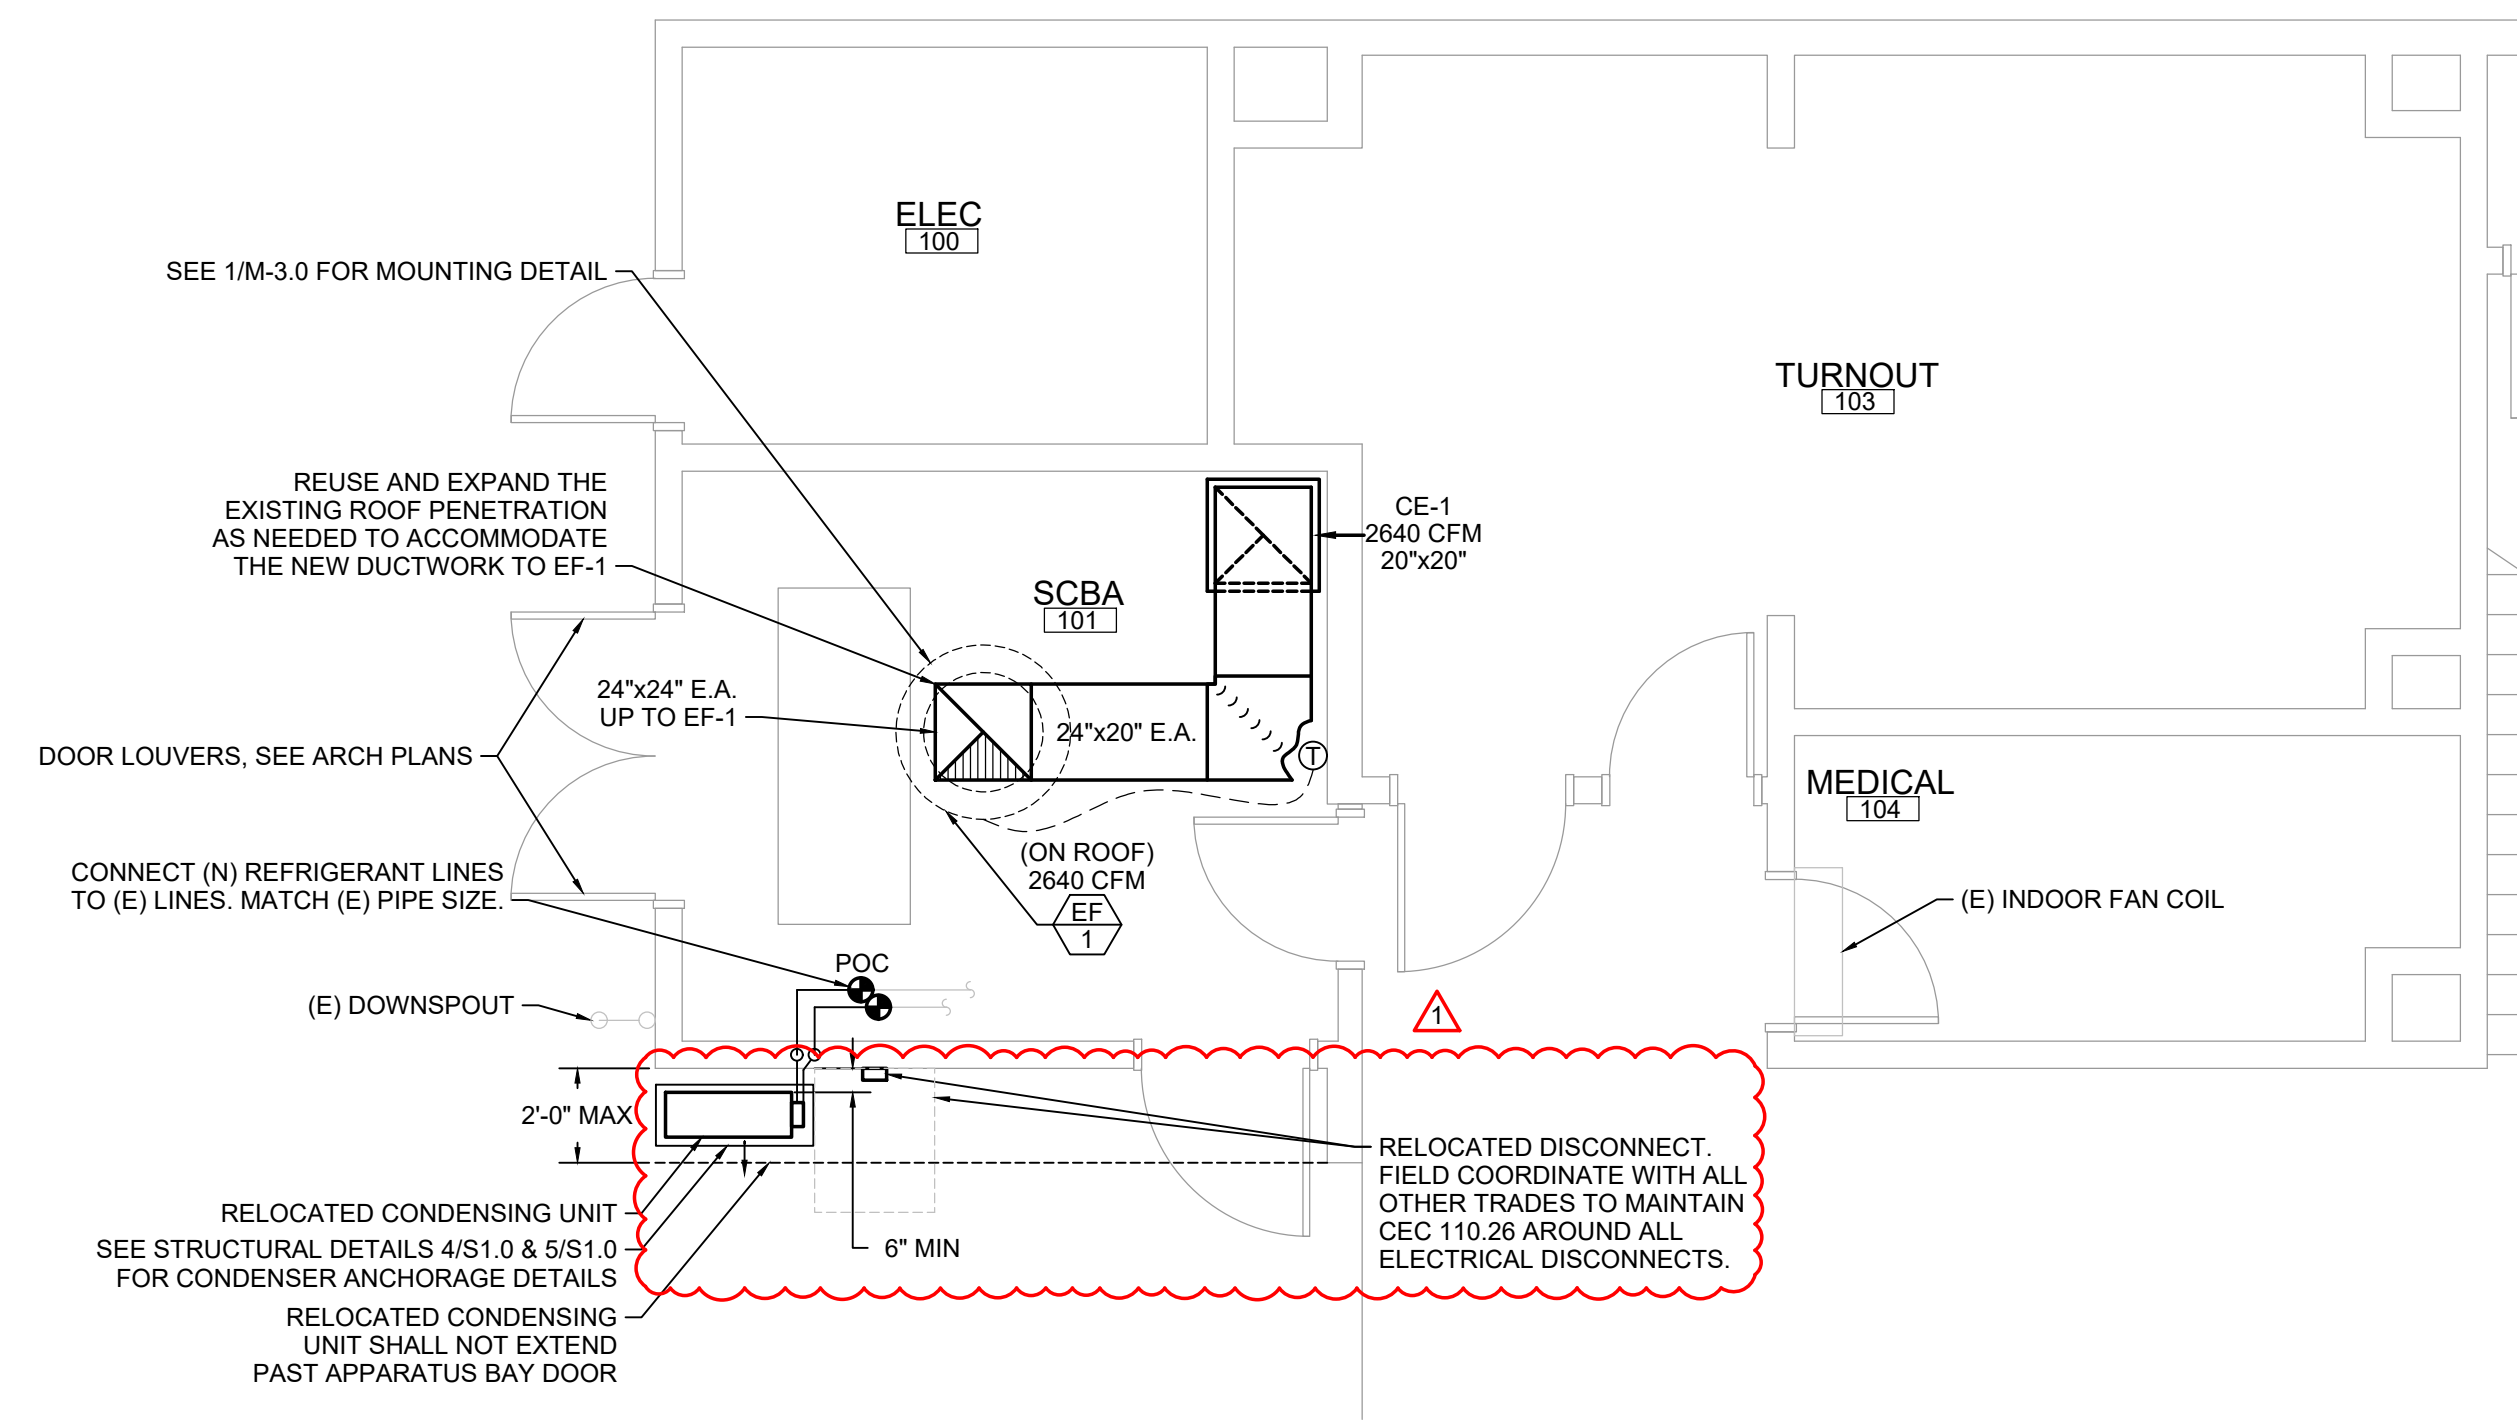

3 MECHANICAL - BID ALT. 1 FLOOR PLAN
SCALE: 1/4" = 1'-0"



J:\2024_Jobs\24189 - City of Turlock Fire Station 31 Compressor Room\24189 - Mechanical.dwg, 2/21/2025 10:53:21 AM, e.dejong



WMB ARCHITECTS

5757 Pacific Avenue
Suite 226
Stockton, CA 95207


2000 L Street
Suite 125
Sacramento, CA 95811

T 209.944.9110
F 209.944.5711
www.wmbarchitects.com

CITY PROJECT NO.
24-010
FIRE STATION NO. 31,
SCBA COMPRESSOR
ROOM

540 E MARSHALL ST.
TURLOCK, CA 95380

WMB Project No. 24-023

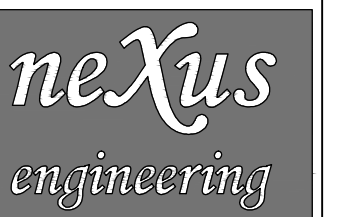

Consulting Mechanical Engineers
1400 Lone Palm Ave, Suite A
Modesto, CA 95351
Tel: 209.572.7399 Fax: 209.236.1579
www.nexusengineering.net
HVAC, Plumbing/Piping, Fire Sprinklers
Process/Plant Engineering, Refrigeration




PUBLISH HISTORY:


No.	DATE	PURPOSE
1	11.08.24	BLDG PERMIT APP
1	02.18.25	PLAN CHECK #1

MECHANICAL - BID ALT. 2
DEMOLITION AND FLOOR
PLANS


M-2.2

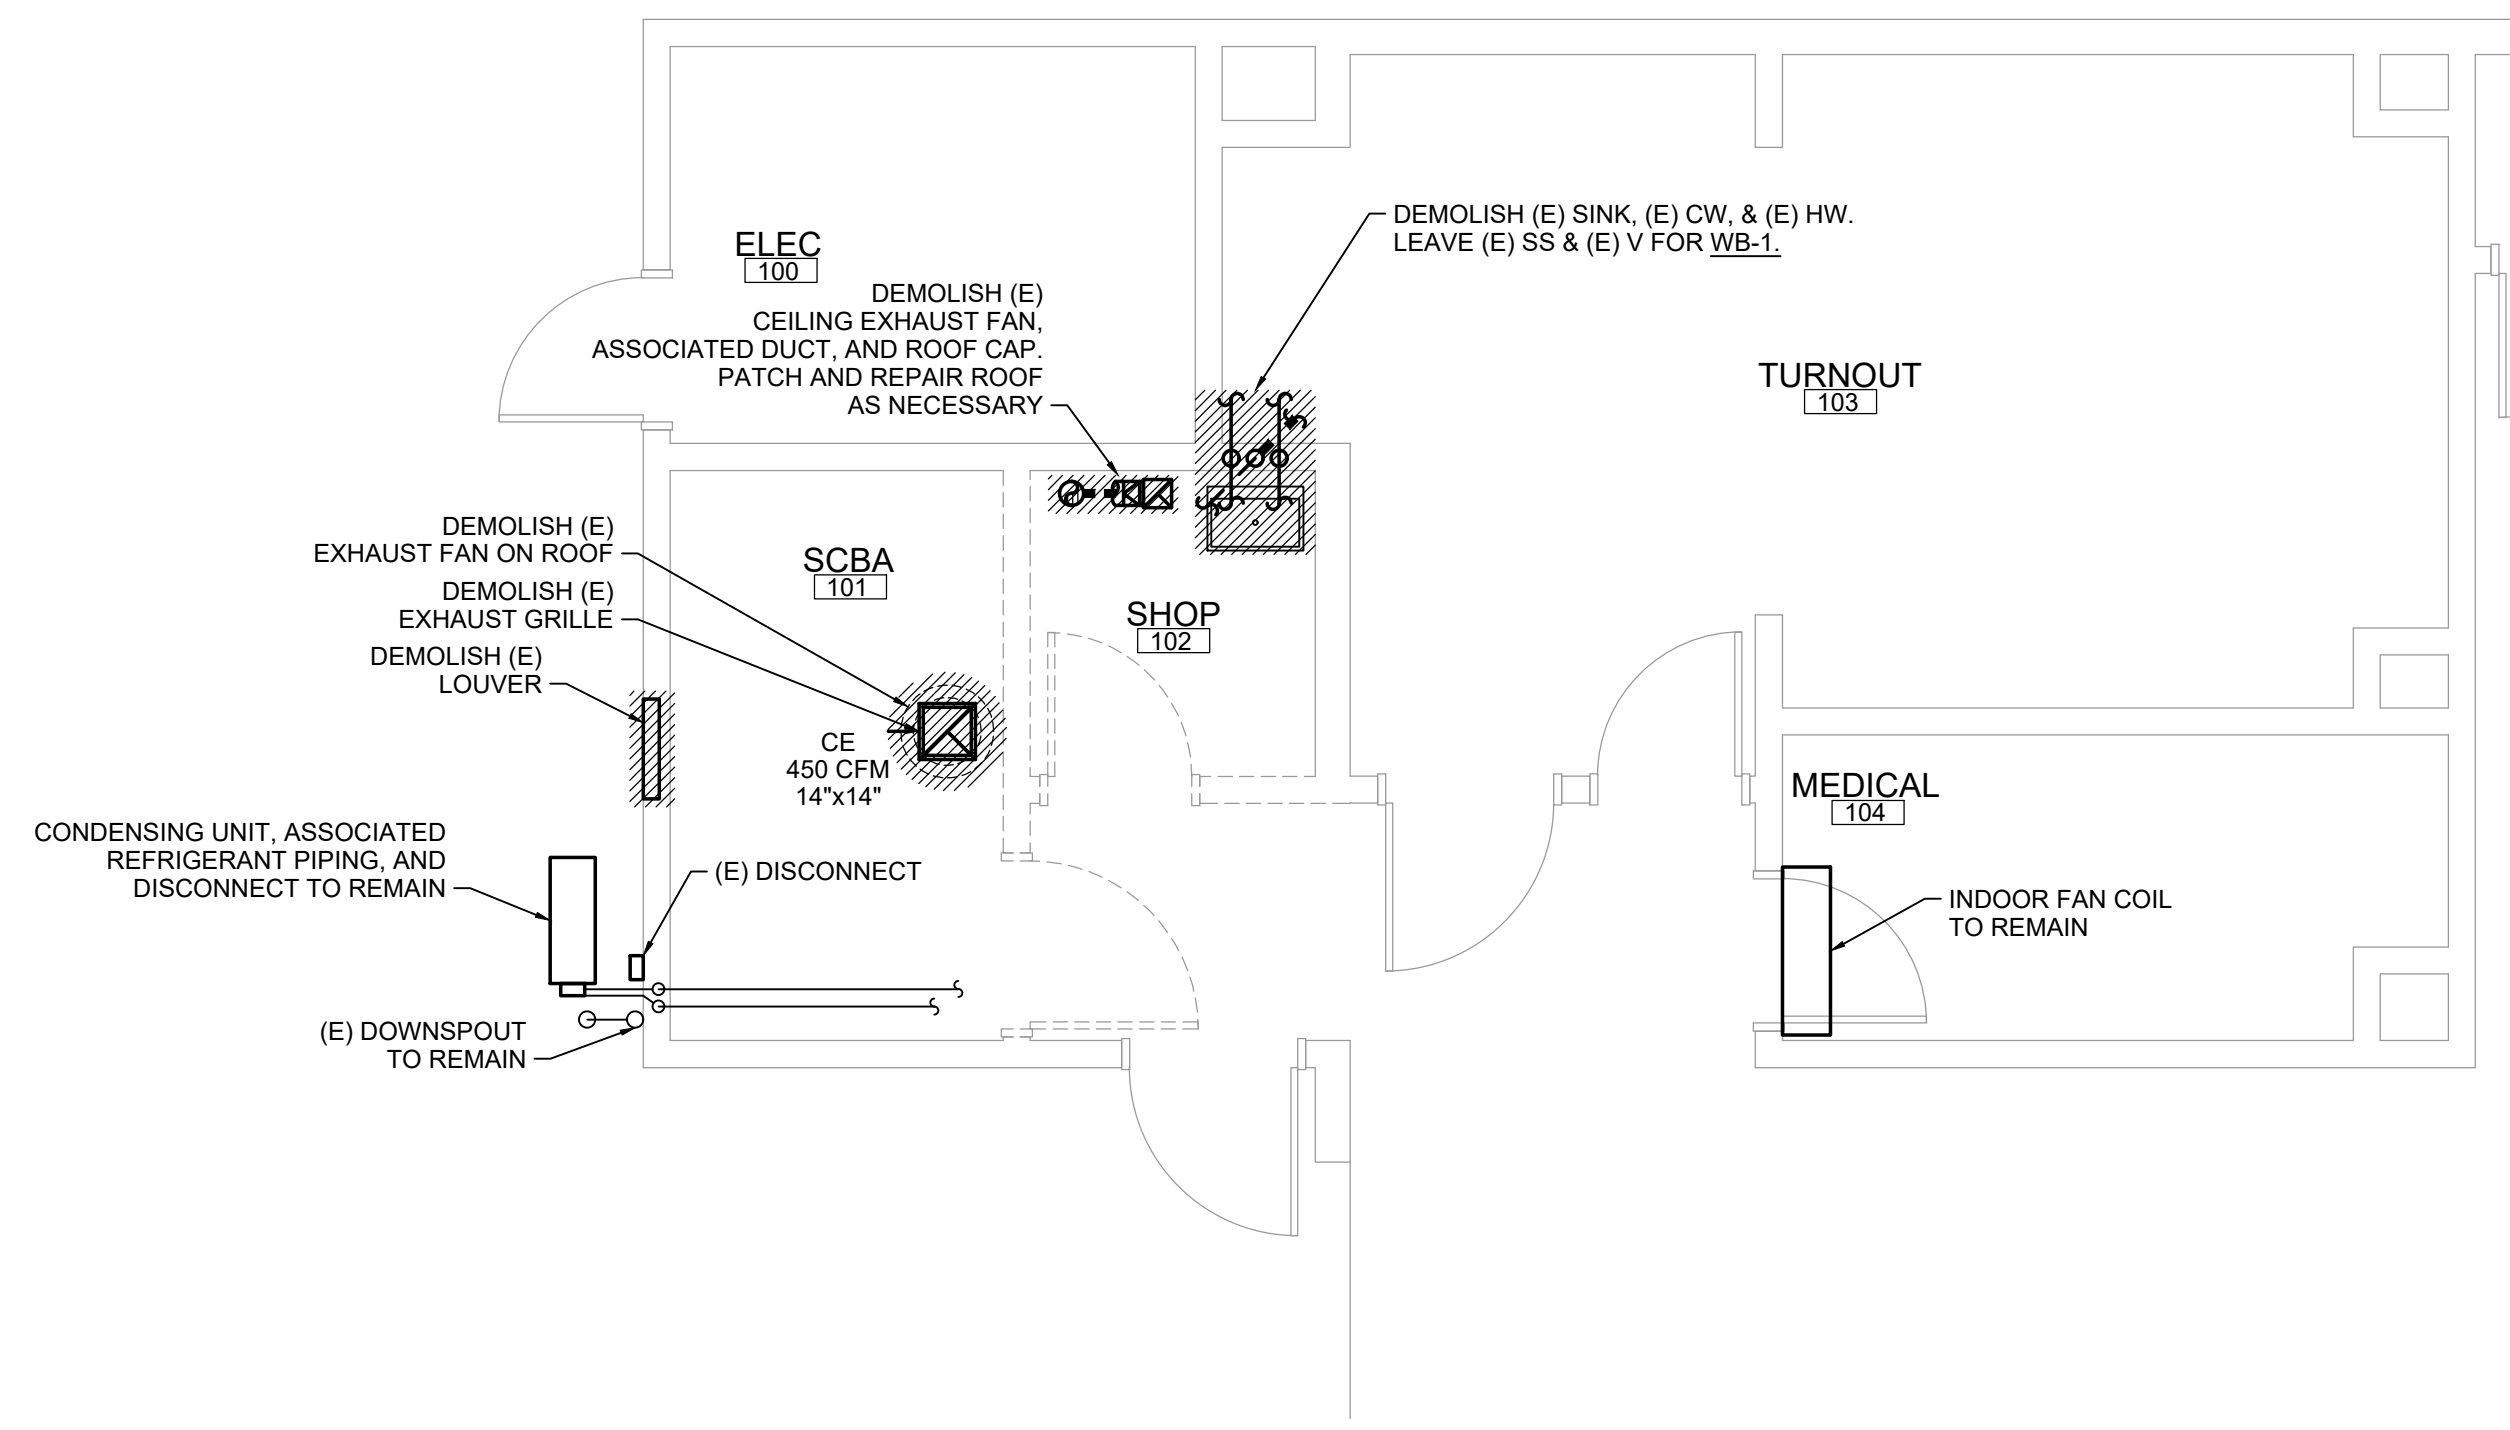


1 MECHANICAL - BASE BID & BID ALT. 2 DEMOLITION FLOOR PLAN
 SCALE: 1/4" = 1'-0"

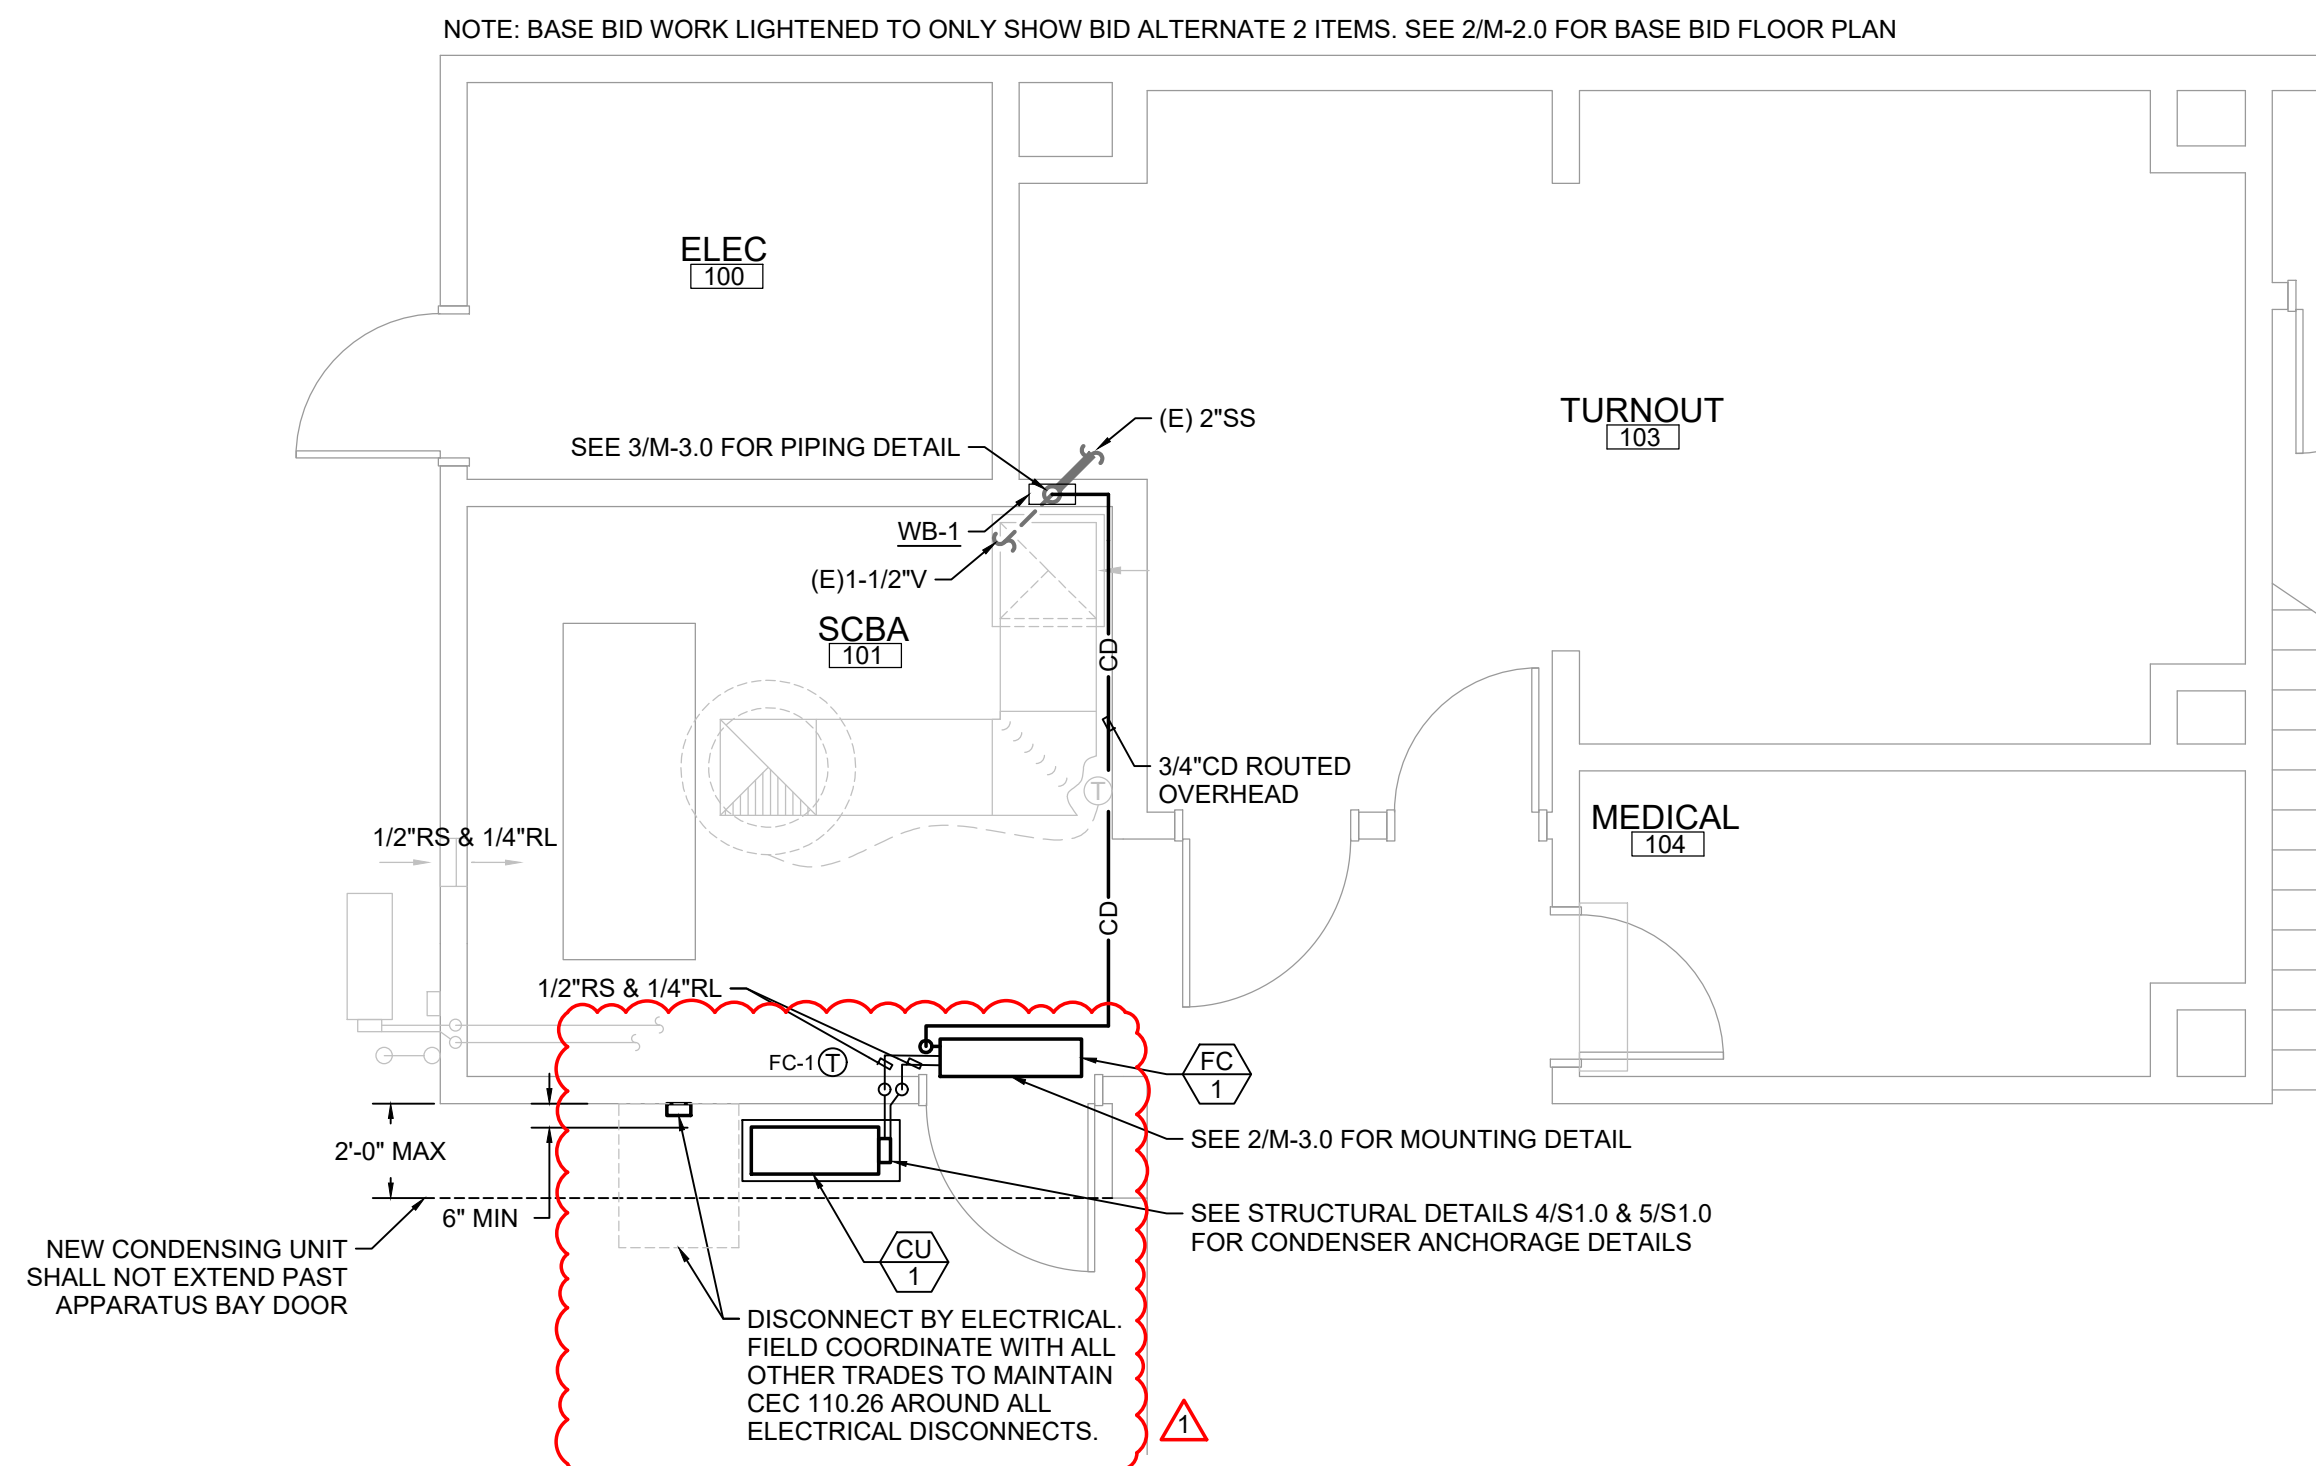

2 MECHANICAL - BASE BID & BID ALT. 2 FLOOR PLAN
 SCALE: 1/4" = 1'-0"

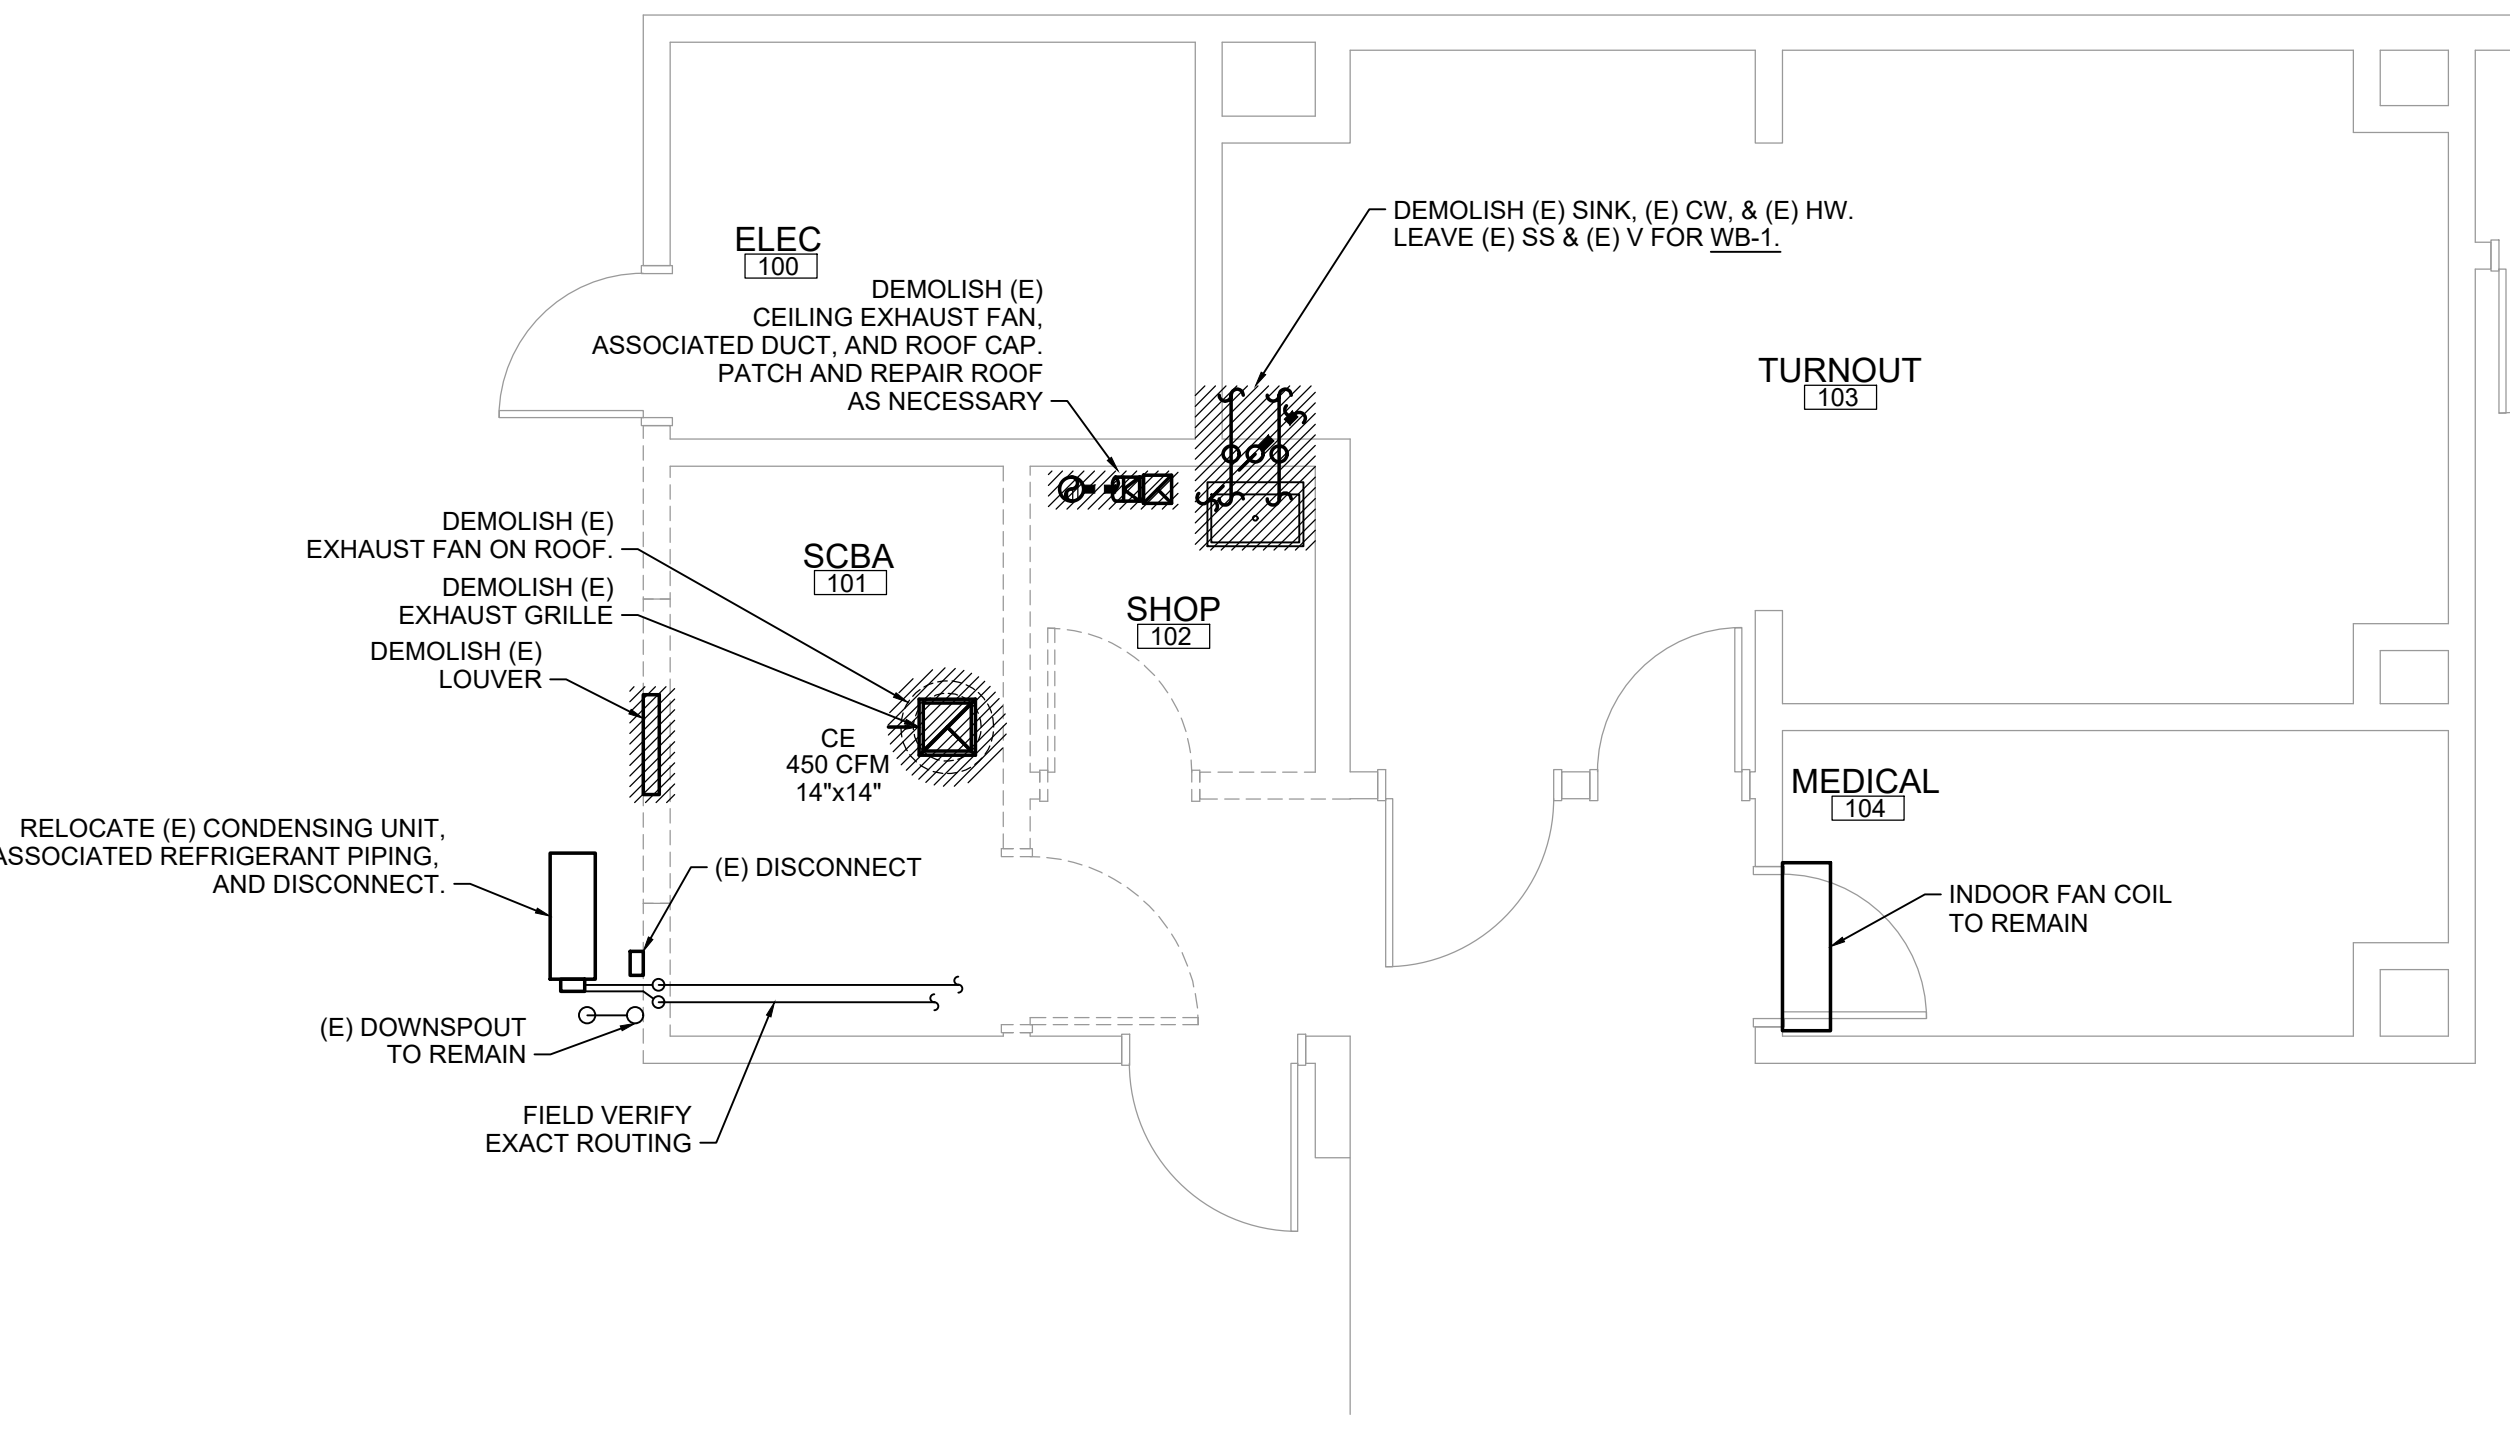

3 MECHANICAL - BID ALT. 1 & 2 DEMOLITION FLOOR PLAN
 SCALE: 1/4" = 1'-0"

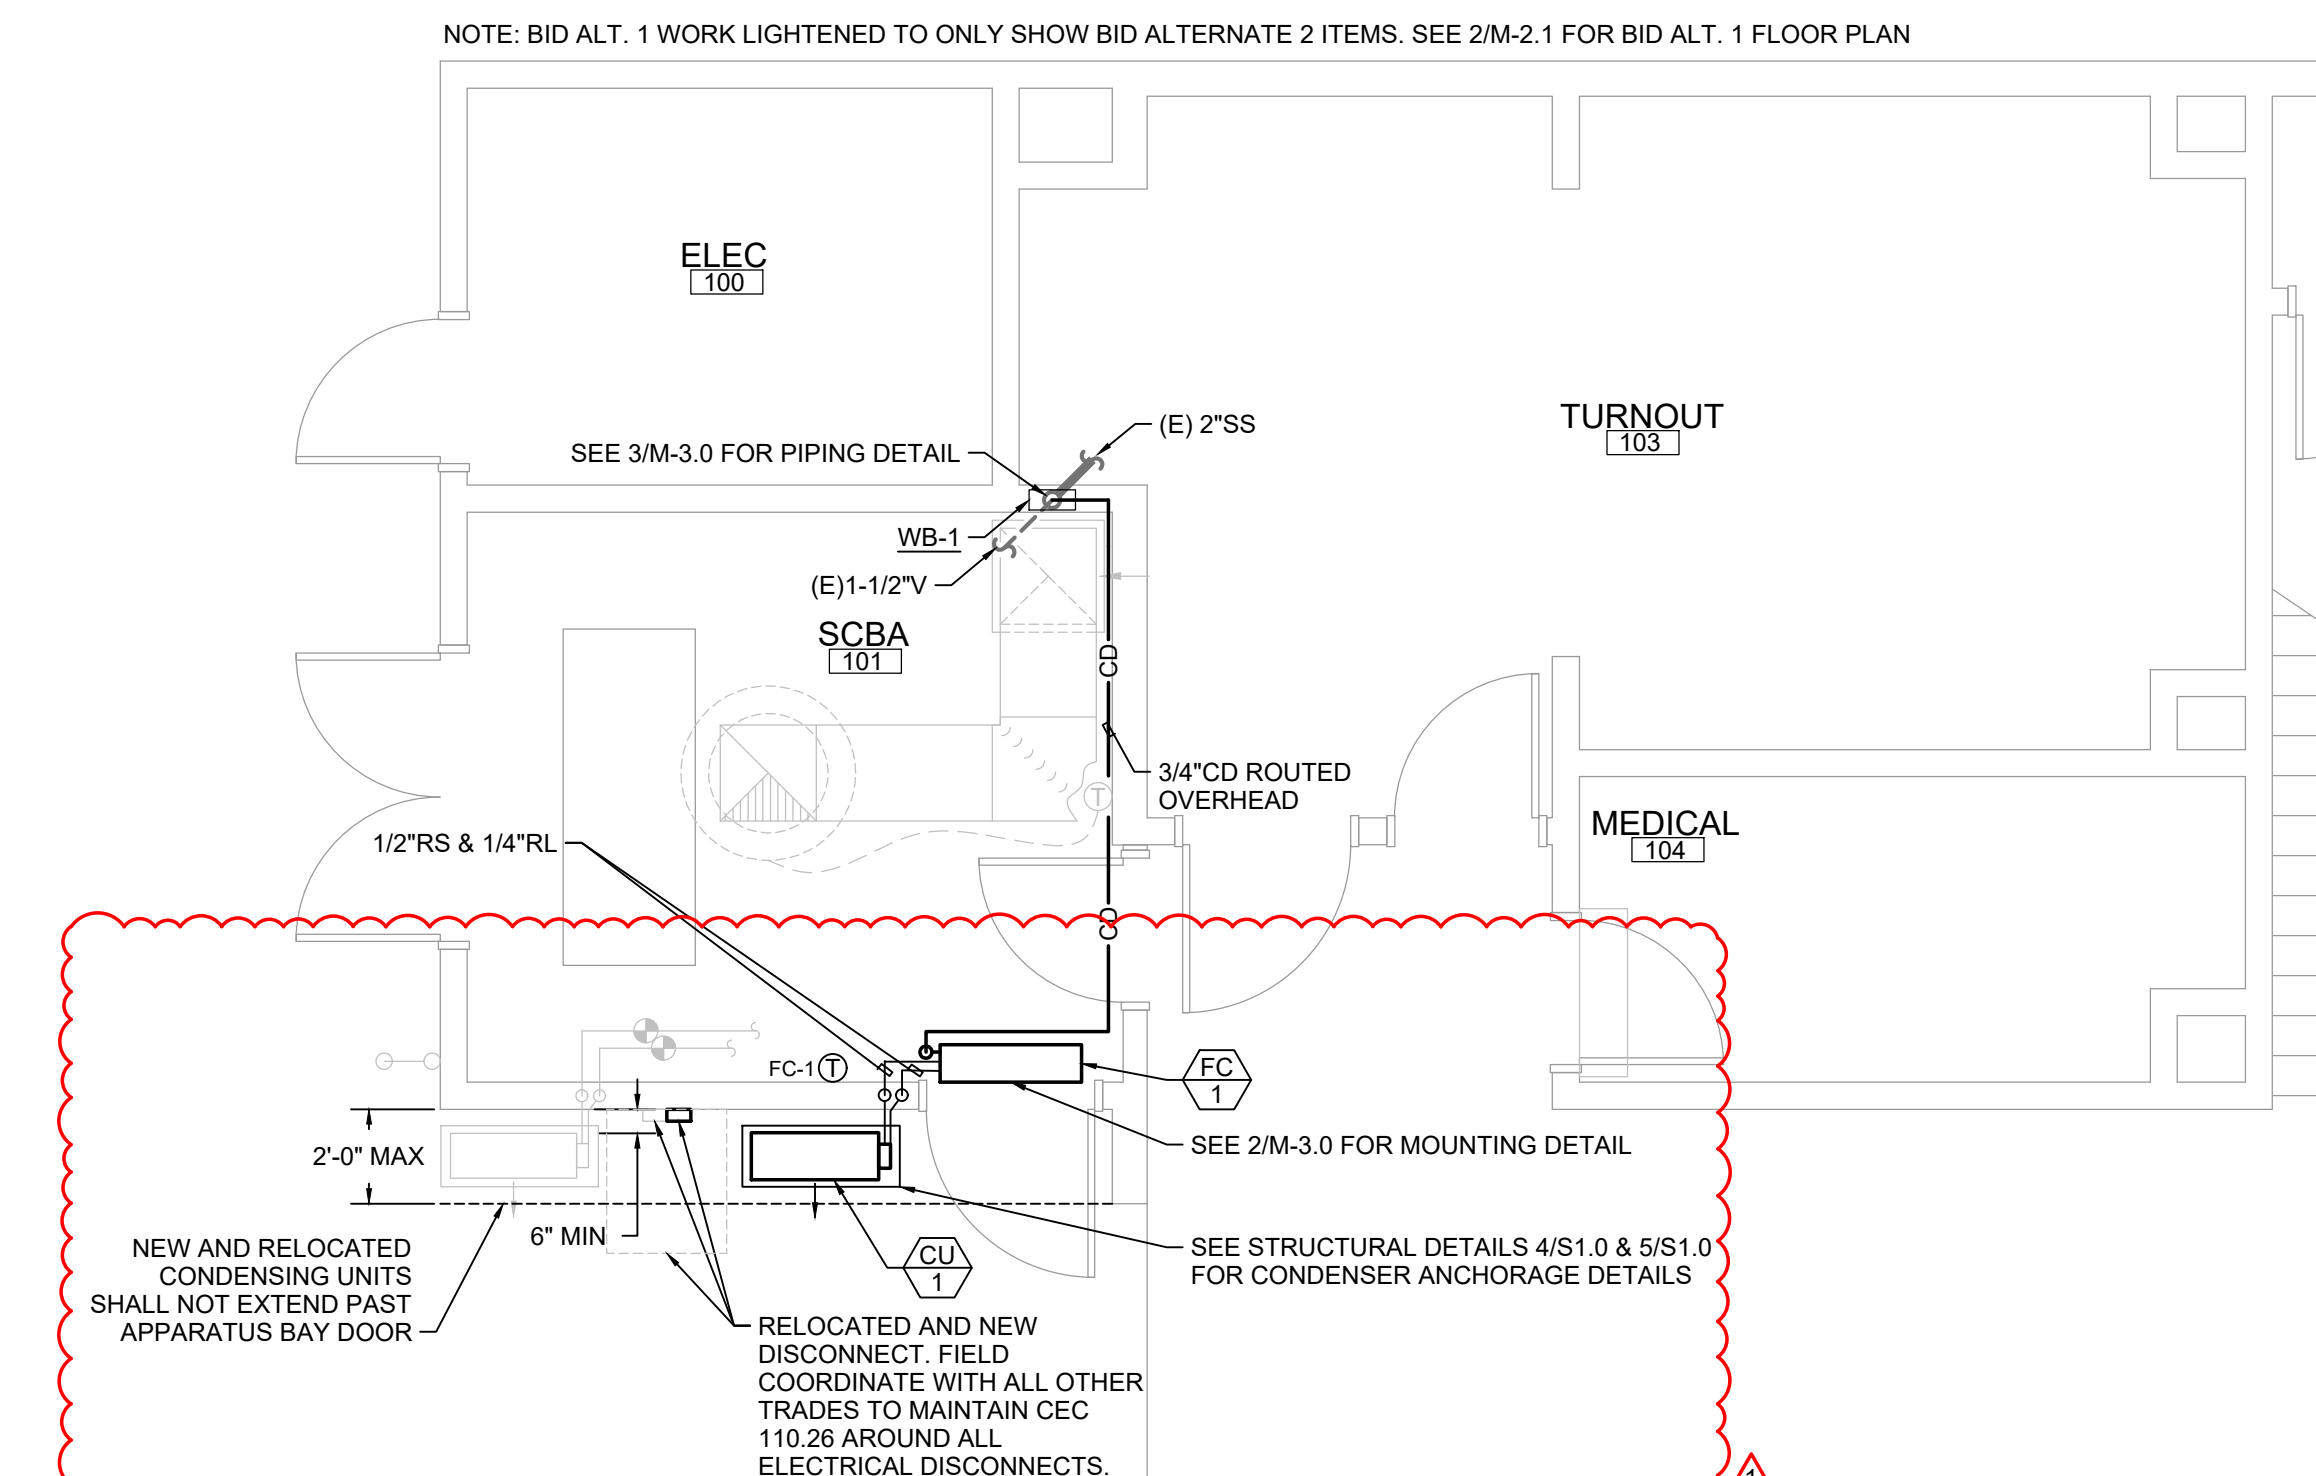

4 MECHANICAL - BID ALT. 1 & 2 FLOOR PLAN
 SCALE: 1/4" = 1'-0"



J:\2024_Jobs\24189 - City of Turlock Fire Station 31 - Compressor Room\24189 - Mechanical.dwg, 2/21/2025 10:53:09 AM, e.dejong



**WMB
ARCHITECTS**

5757 Pacific Avenue
Suite 226
Stockton, CA 95207


2000 L Street
Suite 125
Sacramento, CA 95811

T 209.944.9110
F 209.944.5711
www.wmbarchitects.com

CITY PROJECT NO.
24-010
FIRE STATION NO. 31,
SCBA COMPRESSOR
ROOM

540 E MARSHALL ST.
TURLOCK, CA 95380

WMB Project No. 24-023

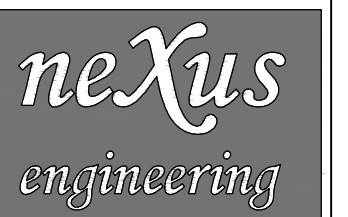

Consulting Mechanical Engineers
1400 Lone Palm Ave, Suite A
Modesto, CA 95351
Tel: 209.572.7399 Fax: 209.236.1579
www.nexusengineering.net
HVAC, Plumbing/Piping, Fire Sprinklers
Process/Plant Engineering, Refrigeration




PUBLISH HISTORY:


No.	DATE	PURPOSE
1	11.08.24	BLDG PERMIT APP
1	02.18.25	PLAN CHECK #1

MECHANICAL - DETAILS

M-3.0

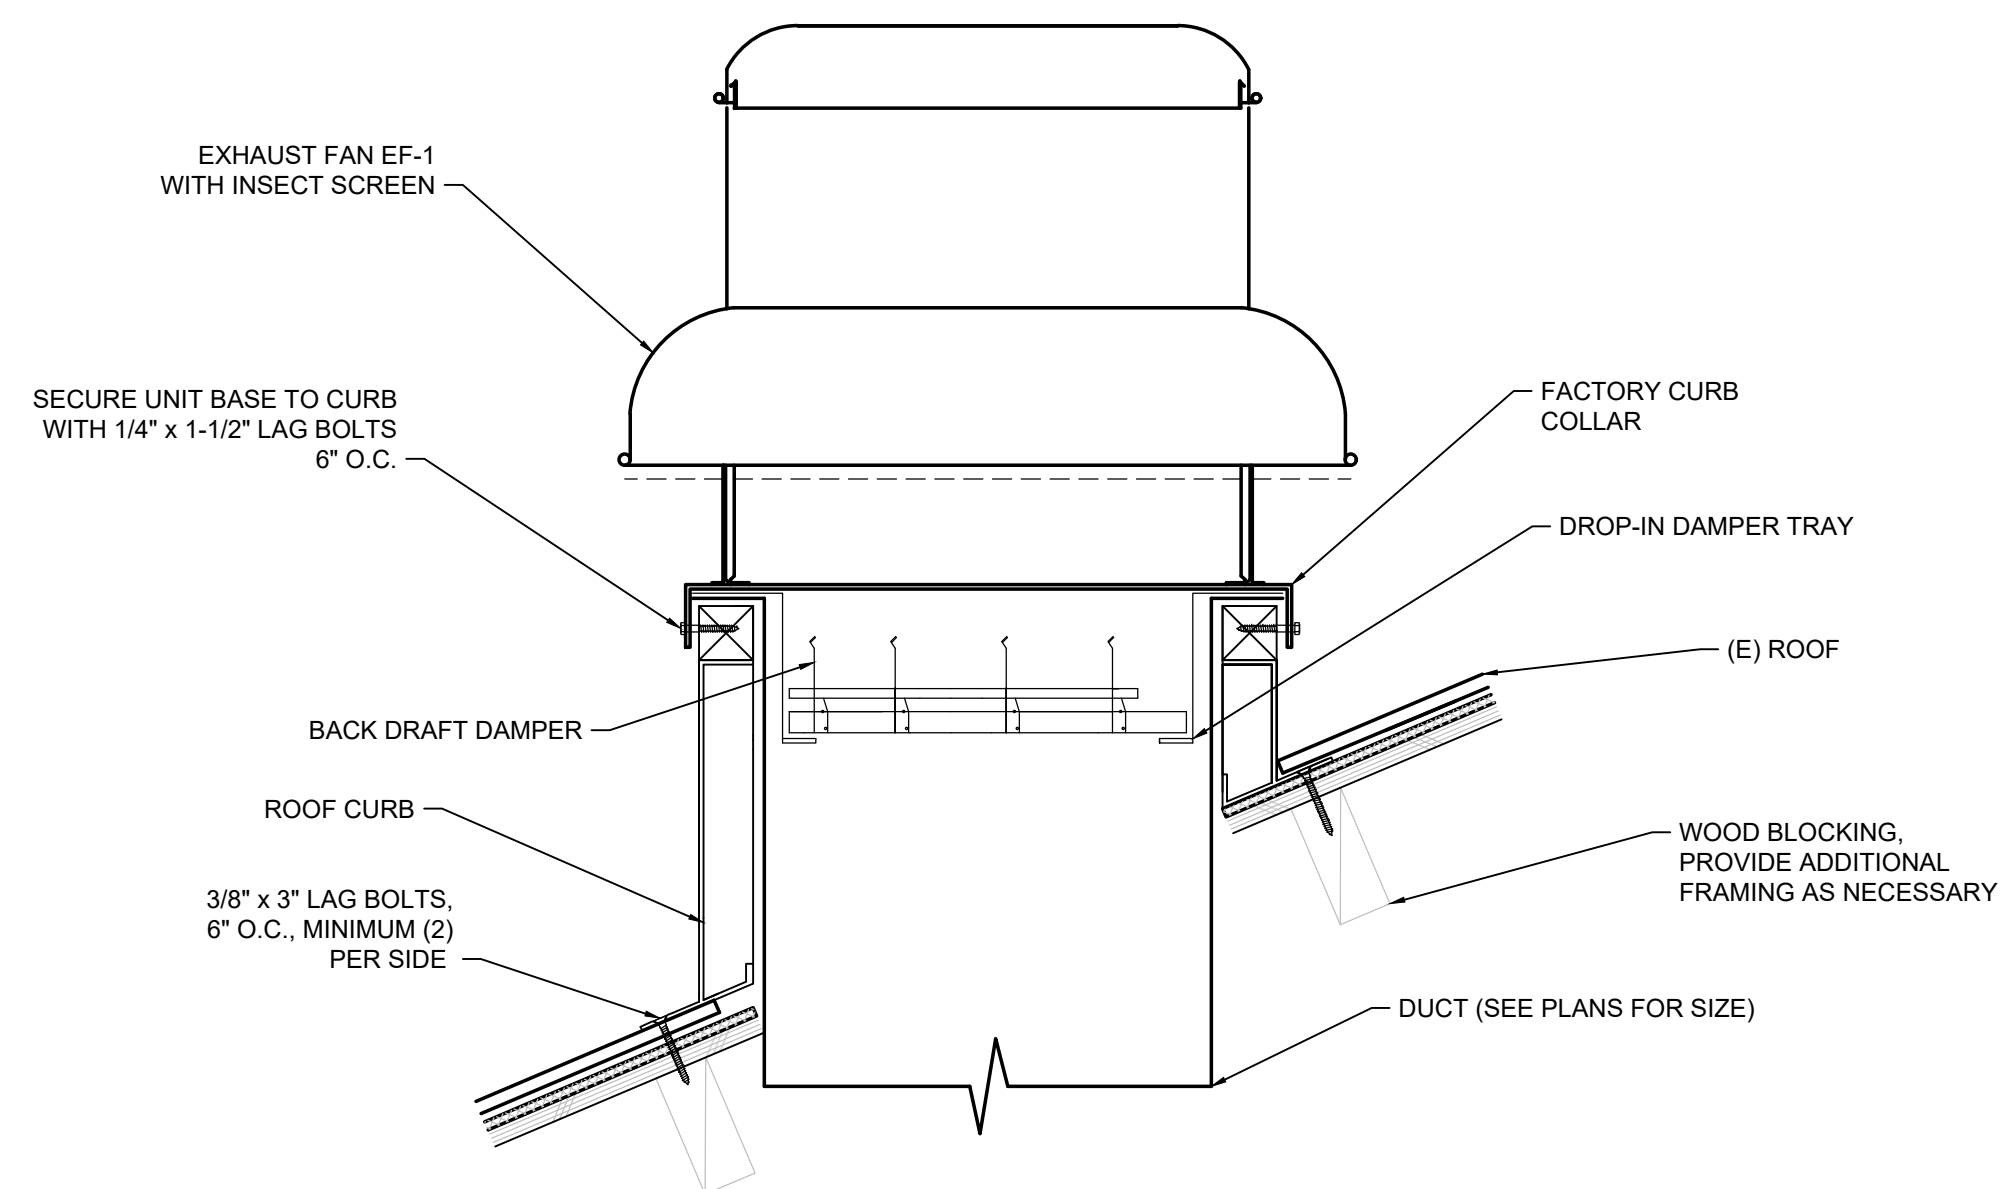


1 ROOF EXHAUST FAN DETAIL
M-3.0 SCALE: NONE

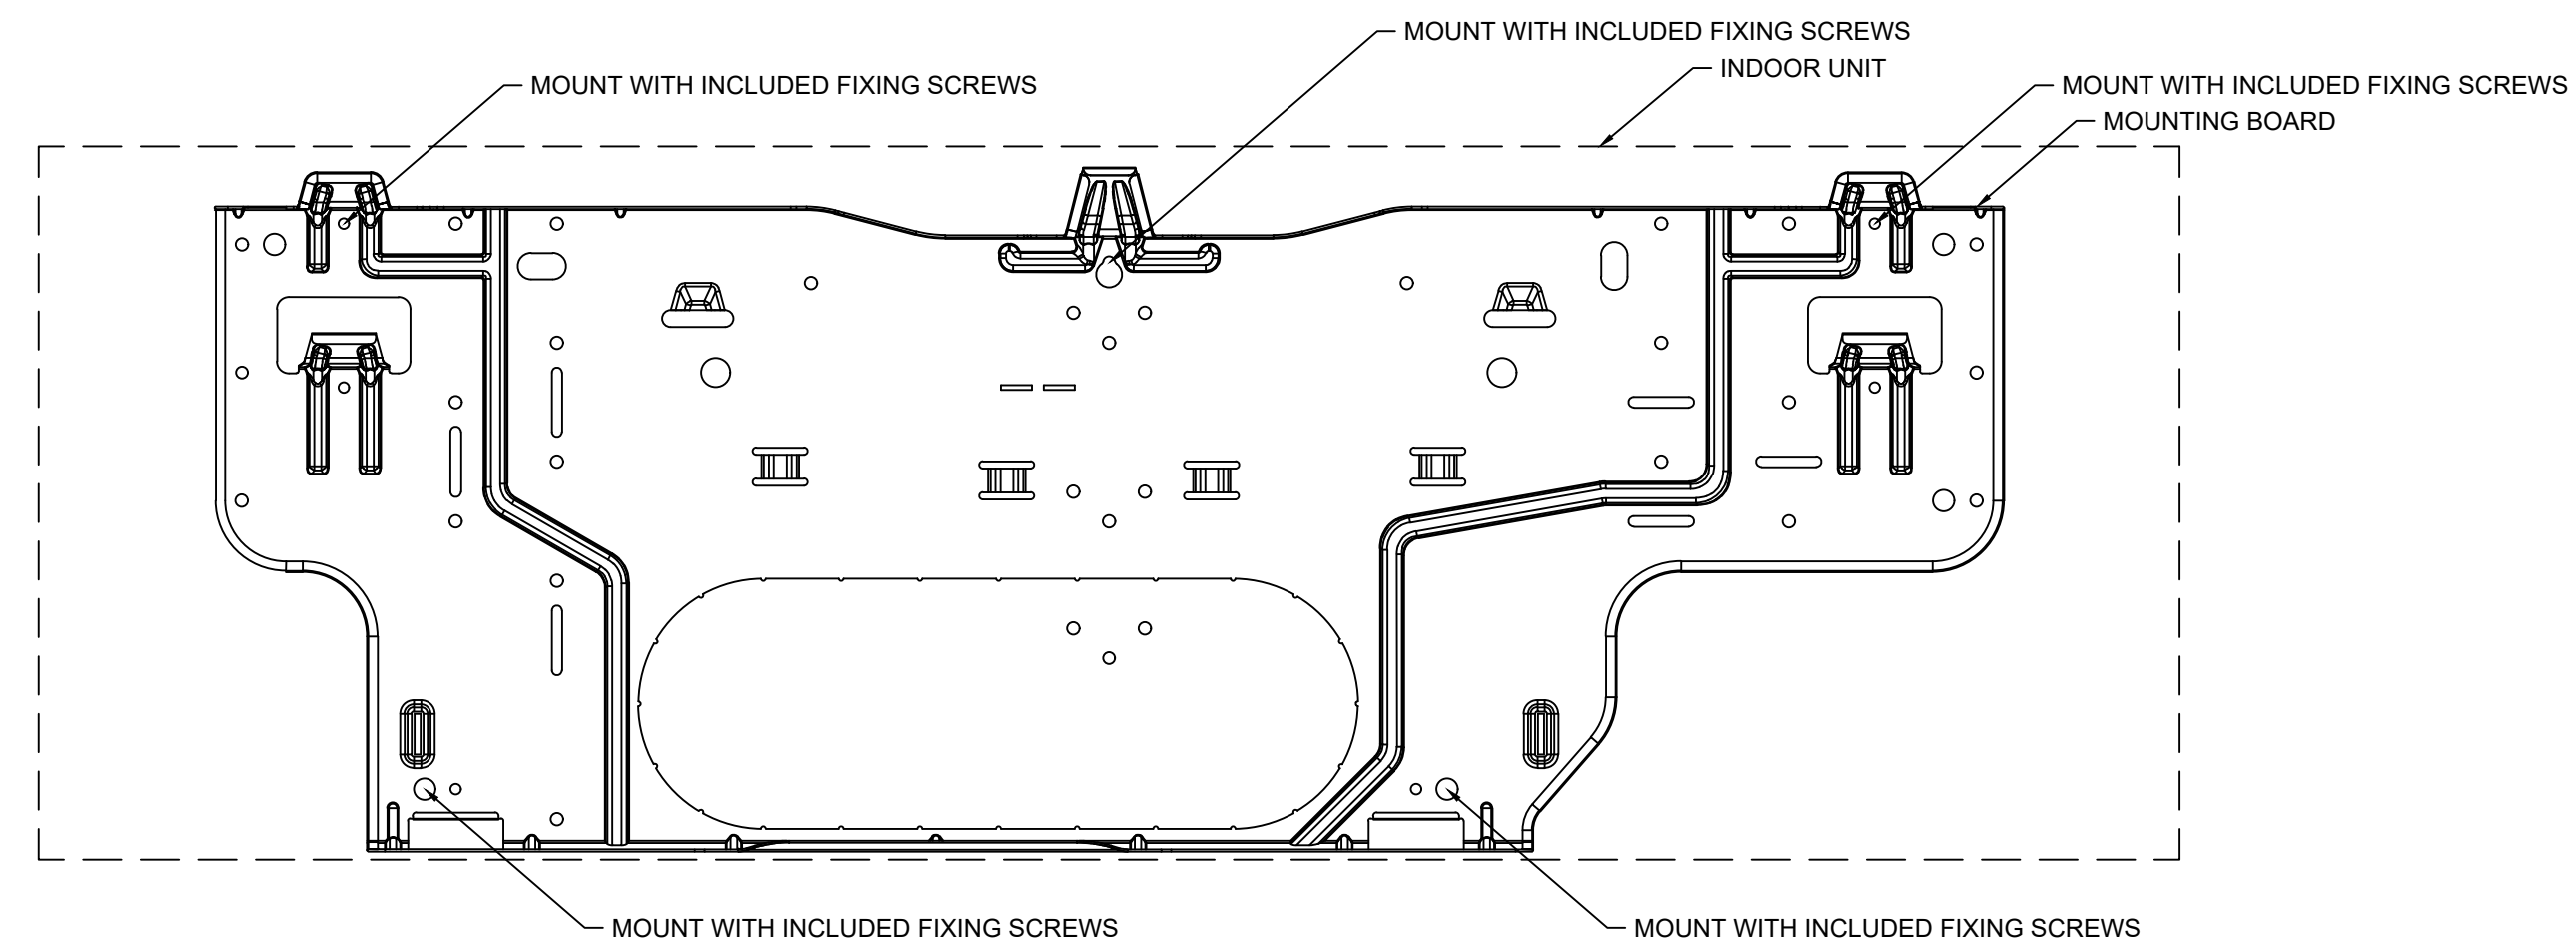


NOTE: MOUNT INDOOR UNIT ONTO BRACKET PER MANUFACTURER'S SPECIFICATIONS.

2 INDOOR UNIT MOUNTING DETAIL
M-3.0 SCALE: NONE

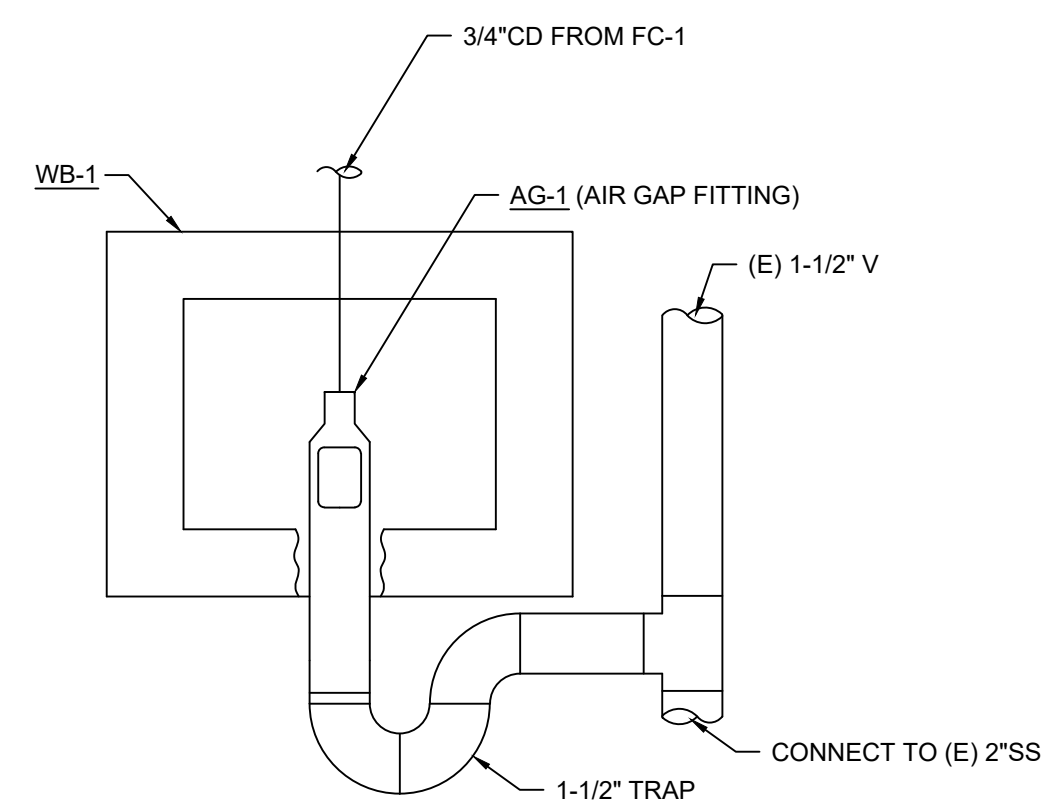

3 WB-1 & AG-1 MOUNTING DETAIL
M-3.0 SCALE: NONE

J:\2024_Jobs\24189 - City of Turlock Fire Station 31 Compressor Room\24189 - Mechanical.dwg, 2/21/2025 10:53:03 AM, e.dejong

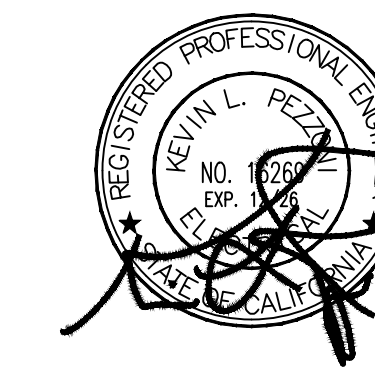

WMB ARCHITECTS

5757 Pacific Avenue
Suite 226
Stockton, CA 95207

2000 L Street
Suite 125
Sacramento, CA 95811

T 209.944.9110
F 209.944.5711
www.wmbarchitects.com

CITY PROJECT NO.
24-010
FIRE STATION NO. 31,
SCBA COMPRESSOR
ROOM

540 E MARSHALL ST.
TURLOCK, CA 95380

WMB Project No. 24-023

PUBLISH HISTORY:


No. DATE PURPOSE
11.08.24 BLDG PERMIT APP

FLOOR PLAN, NOTES AND
SYMBOLS

TITLE SHEET

E1.0

GENERAL ELECTRICAL LEGEND

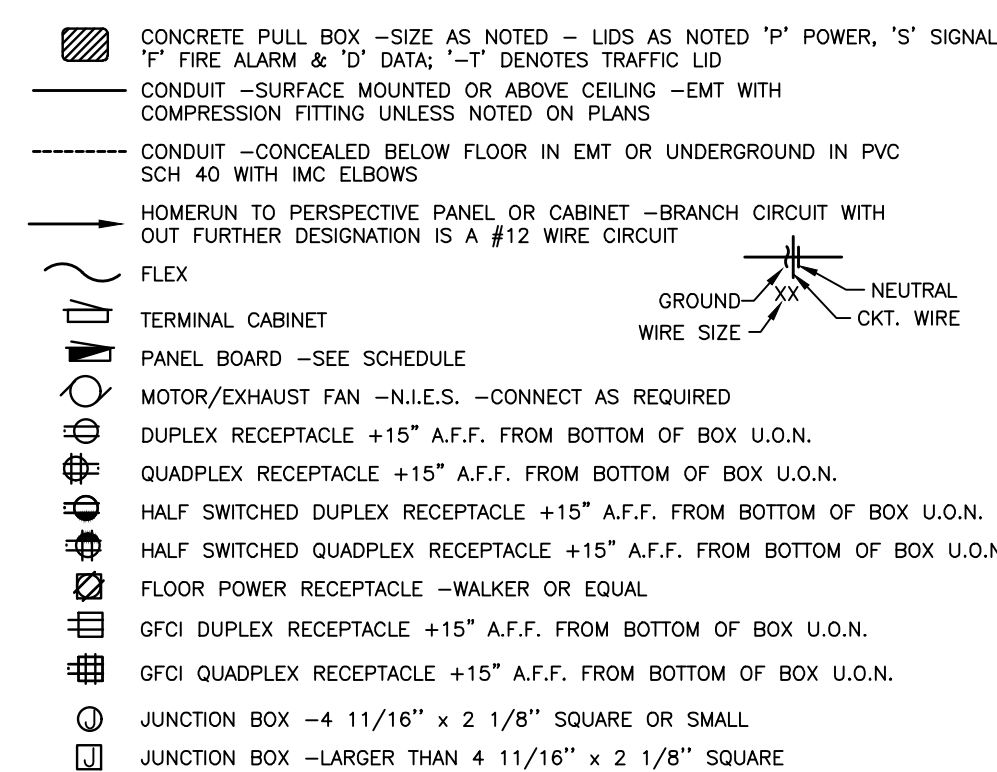

ELECTRICAL COMPLIANCE NOTES

THE INTENT OF THE DRAWINGS AND SPECIFICATION IS TO CONSTRUCT THE PROPOSED BUILDING IN ACCORDANCE WITH TITLE 24, CALIFORNIA CODE OF REGULATIONS. ALL WORK PERFORMED UNDER THIS CONTRACT SHALL CONFORM TO THE FOLLOWING CODES AND REGULATIONS AS APPLICABLE:

- 2022 CALIFORNIA ADMINISTRATIVE CODE (CAC)
- PART 1, TITLE 24, CALIFORNIA CODE OF REGULATIONS (CCR)
- 2022 CALIFORNIA BUILDING CODE (CBC)
- PART 2, TITLE 24, CCR
- BASED ON THE 2021 INTERNATIONAL BUILDING CODE (IBC)
- 2022 CALIFORNIA ELECTRICAL CODE (CEC)
- PART 3, TITLE 24, CCR
- BASED ON THE 2020 NATIONAL ELECTRICAL CODE (NEC)
- 2022 CALIFORNIA MECHANICAL CODE (CMC)
- PART 4, TITLE 24, CCR
- BASED ON THE 2021 UNIFORM MECHANICAL CODE (UMC)
- 2022 CALIFORNIA PLUMBING CODE (CPC)
- PART 5, TITLE 24, CCR
- BASED ON THE 2021 UNIFORM PLUMBING CODE (UPC)
- 2022 CALIFORNIA FIRE CODE (CFC)
- PART 9, TITLE 24, CCR
- BASED ON THE 2021 INTERNATIONAL FIRE CODE (IFC)
- 2022 NFPA 72, NATIONAL FIRE ALARM & SIGNALING CODE
- w/ CALIFORNIA AMENDMENTS.

UNLESS OTHERWISE STATED, IT IS INTENDED THAT THE ABOVE CODES AND REGULATIONS REFER TO THE LATEST EDITION OR REVISION IN EFFECT ON THE DATE OF THE CONTRACT. NOTHING ON THE DRAWING IS TO BE CONSTRUED AS REQUIRING OR PERMITTING WORK THAT IS CONTRARY TO THE ABOVE LISTED CODES AND REGULATIONS, OR OTHER LOCAL, STATE OR FEDERAL CODES OR REGULATIONS WHICH MAY BE APPLICABLE.

GENERAL ELECTRICAL NOTES

1. PROVIDE ALL LABOR, MATERIALS, TOOLS, PLANT EQUIPMENT, TRANSPORTATION AND ALL PERFORM ALL OPERATIONS NECESSARY FOR THE PROPER EXECUTION AND COMPLETION OF ALL ELECTRICAL WORK REQUIRED FOR THE COMPLETE AND OPERATING SYSTEMS AS OUTLINED WITHIN THE SCOPE OF WORK.
2. THE SIZE AND LOCATIONS OF EQUIPMENT ARE SHOWN TO SCALE WHEREVER POSSIBLE. CONTRACTOR SHALL MAKE USE OF ALL DATA IN ALL CONTRACT DOCUMENTS AND VERIFY THIS INFORMATION AT THE SITE.
3. CONDUCTORS SHALL BE COPPER CONDUCTORS TYPE AS NOTED ON CONSTRUCTION DOCUMENTS.
4. ALL REQUIRED CONDUITS SHALL BE PROVIDED BY E.C. LOW VOLTAGE WIRING SHALL BE BY MECHANICAL CONTRACTOR, LINE VOLTAGE (50 VOLTS OR MORE) SHALL BE BY ELECTRICAL CONTRACTOR.
5. ALL CONDUITS SHALL BE SUPPORTED AND BRACED PER OPA NO. OPA-0120, THE "UNISTRUT SEISMIC BRACING SYSTEM " FOR PIPES AND CONDUITS ONLY. LAYOUT DRAWINGS, SHOWING THE BRACING/SUPPORT LOCATIONS AND REFERENCES TO DETAILS FROM THE RELEVANT OSHPD PRE-APPROVALS FOR PIPING/DUCTS/CONDUITS EXCEPT FIRE SPRINKLERS. NEED TO BE SUBMITTED FOR USE BY THE IOR AND OSHPD STAFF. THE LAYOUT DRAWINGS NEED TO BE REVIEWED AND ACCEPTED BY THE AOR AND SEOR PRIOR TO STARTING INSTALLATION OF THE BRACING/SUPPORT. IOR SHALL ENSURE THE ABOVE REQUIREMENTS ARE SATISFIED.
6. DO NOT PENETRATE STRUCTURAL MEMBERS, INCLUDING BEAMS, COLUMNS, OR FOOTINGS, WITHOUT PRIOR WRITTEN CONSENT OF THE DISTRICT'S STRUCTURAL ENGINEER. SHOULD IT BECOME NECESSARY TO PENETRATE SUCH MEMBERS, NOTIFY THE DISTRICT IN WRITING WITHOUT DELAY, PRIOR TO PROCEEDING WITH CONSTRUCTION AROUND SUCH MEMBERS.
7. ALL ELECTRICAL WORK SHALL CONFORM WITH THE 2022 CALIF. ELECTRICAL CODE CALIFORNIA TITLE 17, 19 & 24 ALONG WITH N.F.P.A. STANDARDS AND THE STATE FIRE MARSHAL'S REQUIREMENTS.
8. ALL WORK TO BE IN ACCORDANCE WITH REQUIREMENTS OF STATE & GOVERNING LOCAL FIRE CODES AND BUILDING CODES.
9. WHERE EXISTING CONSTRUCTION IS CUT, DAMAGED, OR REMODELED, PATCH WITH MATERIALS TO MATCH IN KIND, QUALITY, AND PERFORMANCE.
10. WORK SHALL BE EXECUTED IN A CAREFUL AND ORDERLY MANNER WITH THE LEAST POSSIBLE DISTURBANCE TO PUBLIC AND TO OCCUPANTS OF EXISTING BUILDING.
11. CONTRACTOR SHALL ASSUME SOLE RESPONSIBILITY FOR SAFETY OF ALL PERSONS ON OR ABOUT THE CONSTRUCTION SITE, IN ACCORDANCE WITH APPLICABLE LAWS AND CODES. GUARD ALL HAZARDS IN ACCORDANCE WITH THE SAFETY PROVISIONS OF THE LATEST MANUAL OF ACCIDENT PREVENTION PUBLISHED BY THE ASSOCIATED GENERAL CONTRACTORS OF AMERICA.
12. CLEAN ALL EXPOSED SURFACES AND NEW EQUIPMENT AFTER COMPLETION.
13. ALL CHANGE ORDER PROPOSALS AND CHANGE ORDERS, BOTH ADDITIVE AND DEDUCTIVE, SHALL BE BASED UPON AND BE ACCOMPANIED BY A DETAILED MATERIALS AND LABOR BREAKDOWN FOR EACH SPECIFIC TASK AND/OR ITEM. THE BREAKDOWN SHALL INCLUDE ACTUAL MATERIALS COSTS PLUS OVERHEAD AND PROFIT, AS WELL AS LABOR UNITS BASE UPON THE MOST RECENT NECA MANUAL OF LABOR UNITS (NECA INDEX #4080) OR EQUIVALENT PUBLICATION FOR EACH SPECIFIC TASK AND ITEM. LABOR COSTS SHALL BE COMPUTED AS OUTLINED WITHIN THE GENERAL CONDITIONS, BASED UPON THE NECA LABOR TABLES FOR EACH TASK REQUIRED. MATERIALS COSTS SHALL INCLUDE ACTUAL CONTRACTOR INVOICE PLUS NO MORE THAN 15% MARKUP. THE OWNER AND CONTRACTOR AGREE TO THE ABOVE CHANGE ORDER COST PROCEDURE, FOR BOTH ADDITIVE AND DEDUCTIVE CHANGE ORDERS.
14. ALL PERSONNEL WORKING WITH ENERGIZED EQUIPMENT WITHIN THE RESTRICTED ZONE PER NFPA-70E SHALL COMPLY WITH ALL NFPA-70E AND OSHA REQUIREMENTS AND BE ARC FLASH SAFETY CERTIFIED.
15. ALL SWITCHES AND CONTROLS SHALL BE INSTALLED A MAXIMUM OF 38" TO THE TOP OF BOX (CBC 11B-308.1.1).

ELECTRICAL ABBREVIATIONS

Δ	DELTA CONNECTED	CR	CONTROL RELAY	HI	HIGH	NAC	NOTIFICATION APPLIANCE CIRCUIT	SW	SWITCH
Y	WYE CONNECTED	CT	CURRENT TRANSFORMER	HV	HIGH VOLTAGE	NC	NORMALLY CLOSED	SWD	SWITCHED
Ø	PHASE	CU	COPPER	HVAC	HEATING, VENTILATION, AIR CONDITIONING	NL	NIGHT LIGHT	SP	SPARE
A	AMPERES	DC	DIRECT CURRENT	IDF	INTERMEDIATE DISTRIBUTION FRAME	OC	ON CENTER	STD	STANDARD
AC	ALTERNATING CURRENT	DISC	DISCONNECT	INCAN	INCANDESCENT	OH	OVERHEAD	STR	STRANDED
ACT	ABOVE COUNTERTOP/BACKSPLASH	DIST	DISTRIBUTION	INST	INSTANTANEOUS	OL	THERMAL OVERLOAD RELAY	SWBD	SWITCHBOARD
AFF	ABOVE FINISHED FLOOR	(E)	EXISTING	OSHPD	OFFICE OF STATEWIDE HEALTH PLANNING AND DEVELOPMENT	OT	OVER TEMPERATURE	TEL	TELEPHONE
AL	ALUMINUM	EC	ELECTRICAL CONTRACTOR	KV	KILOVOLTS	PA	PUBLIC ADDRESS	TEMP	TEMPERATURE
APPROX	APPROXIMATE	EL, ELEV	ELEVATION	KVA	KILOVOLT AMPERES	PB	PULL BOX	TH	THERMOSTAT
AUTO	AUTOMATIC	ELECT	ELECTRICAL	KW	KILOWATTS	PH	PANEL	TRANSF	TRANSFORMER
AUX	AUXILIARY	EMT	ELECTRICAL METALLIC TUBING	LB	ELBOW	PRI	PRIMARY	TYP	TYPICAL
ALT	ALTERNATE	EOL	END OF LINE	LF	LINEAR FEET	PS	PRESSURE SWITCH	TSP	TWISTED SHIELDED PAIR
AWG	AMERICAN WIRE GAUGE	ENCL	ENCLOSURE	LV	LOW VOLTAGE	PWR	POWER	UG	UNDERGROUND
B	BARE	EP	EXPLOSION PROOF	M	MOTOR	(R)	REMOVE(D)	UNO	UNLESS NOTED OTHERWISE
BC	BARE COPPER GROUND	EQUIP	EQUIPMENT	MAX	MAXIMUM	RA	REMOTE ANNUNCIATOR	V	VOLTS
BKBD	BACKBOARD	ETC	ET CETERA	MCA	MINIMUM CIRCUIT AMPS	REQD	REQUIRED	VA	VOLT AMPS
BRKR	BREAKER	EVAP	EVAPORATOR	MCC	MOTOR CONTROL CENTER	REQMTS	REQUIREMENTS	VFD	VARIABLE FREQUENCY DRIVE
BLDG	BUILDING	(F)	FUTURE	MCM	THOUSAND CIRCULAR MILLS	RG	REDUNDANT GROUND PATH	VM	VOLT METER
C	CONDUIT OR CONTRACTOR	FA	FIRE ALARM	MECH	MECHANICAL	RM	ROOM	W/	WITH
CAB	CABINET	FACP	FIRE ALARM CONTROL PANEL	MFG	MANUFACTURER	RECP	RECEPTACLE	W/O	WITHOUT
CATV	CABLE TELEVISION	FLA	FULL LOAD AMPS	MIN	MINIMUM	SCH	SCHEDULE	WP	WEATHERPROOF
CKT	CIRCUIT	FLEX	FLEXIBLE	MPOE	MAIN POINT OF ENTRY	SEC	SECONDS, SECONDARY	WHD	WATT HOUR DEMAND METER
CLG	CEILING	FLUOR	FLUORESCENT	MSB	MAIN SWITCHBOARD	SIG	SIGNAL	WM	WATT METER
COMM	COMMUNICATION	FS	FLOW SWITCH	N	NEUTRAL	SPECS	SPECIFICATIONS	WH	WATER HEATER
CONN	CONNECT	GALV	GALVANIZED	(N)	NEW			XFMR	TRANSFORMER
CONT	CONTINUATION OR CONTINUED	GND	GROUND	NA	NON-AUTOMATIC			(XR)	REMOVE AND RELOCATE(D)
COORD	COORDINATE	GC	GENERAL CONTRACTOR						

